


646.406 DURABLE 4 INCH WHITE LINE, RECESSED POLYUREA  
 (ALL LINES WILL INCLUDE EDGE LINE BREAKS AND  
 RADIUS FOR TOWN HIGHWAYS)  
 ARLINGTON:  
 STA 68+00.00 - STA 82+00.00 LT & RT

646.602 TEMPORARY 4 INCH WHITE LINE, PAINT  
 (ALL LINES WILL INCLUDE EDGE LINE BREAKS AND  
 RADIUS FOR TOWN HIGHWAYS)  
 ARLINGTON:  
 STA 68+00.00 - STA 82+00.00 LT & RT

646.416 DURABLE 4 INCH YELLOW LINE, RECESSED POLYUREA  
 (ALL LINES WILL INCLUDE C/L BREAKS FOR  
 TOWN HIGHWAYS) S=SOLID, D=DASHED  
 ARLINGTON:  
 STA 68+00.00 - STA 82+00.00 LT C RT  
 S - S

646.612 TEMPORARY 4 INCH YELLOW LINE, PAINT  
 (ALL LINES WILL INCLUDE C/L BREAKS FOR  
 TOWN HIGHWAYS) S=SOLID, D=DASHED  
 ARLINGTON:  
 STA 68+00.00 - STA 82+00.00 LT C RT  
 S - S

675.50 REMOVING SIGNS  
 AS SHOWN - 4 ✓

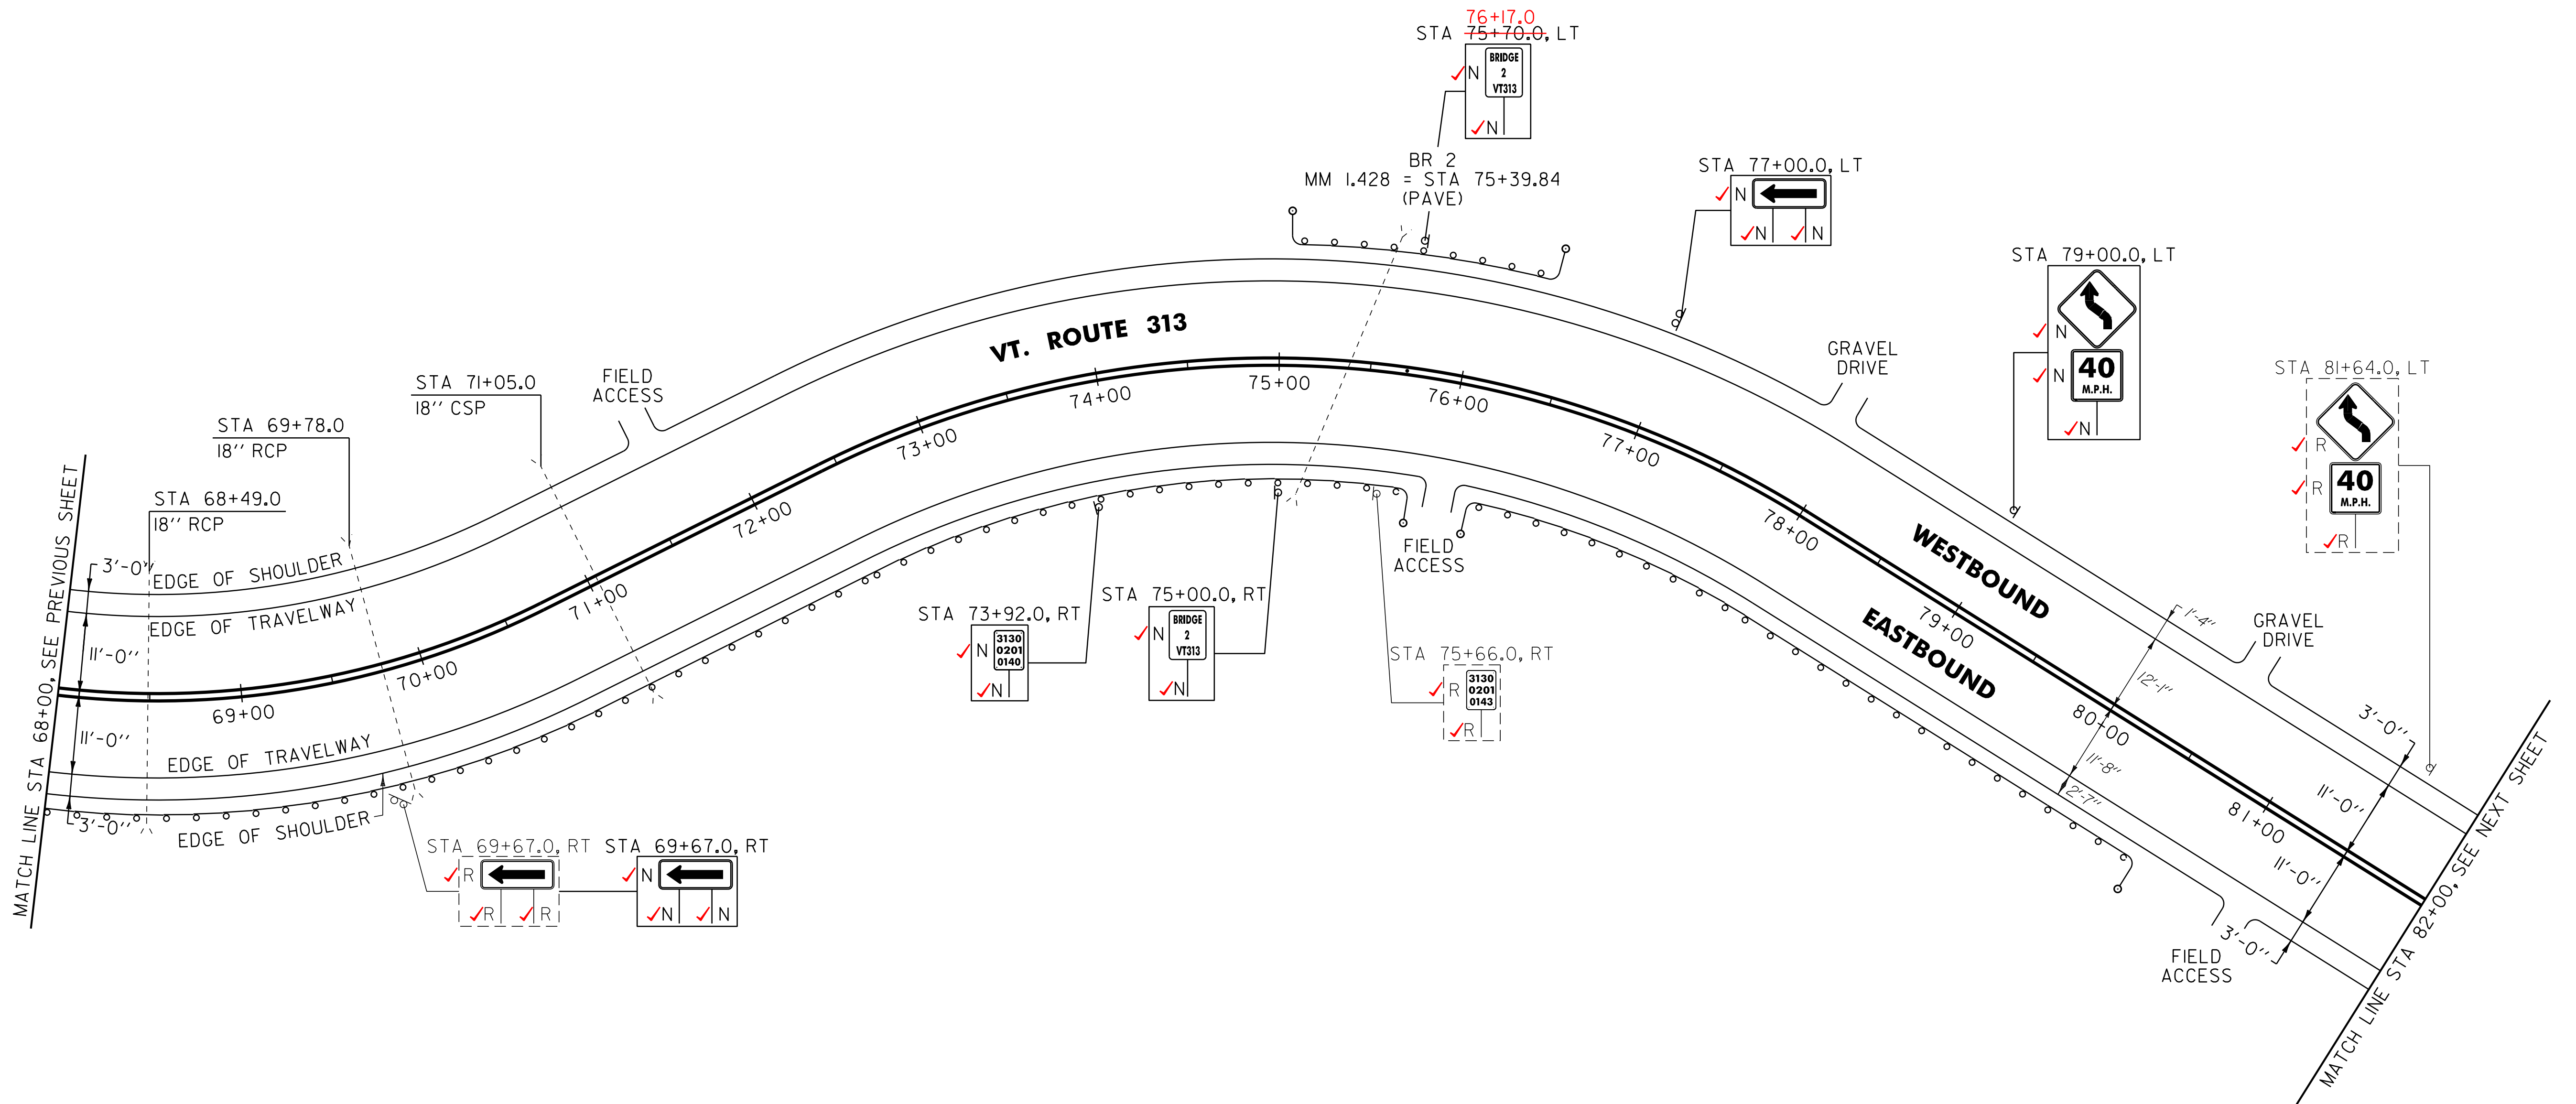

621.20 STEEL BEAM GUARDRAIL, GALVANIZED  
 ARLINGTON: STA 68+00.0 - STA 68+28.0 RT (28.0 LF)  
 STA 75+42.5 - STA 75+92.5 LT (50.0 LF)  
 STA 76+55.5 - STA 80+18.0 RT (362.5 LF) (200.0 LF)  
 78+18.0

621.205 STEEL BEAM GUARDRAIL, GALVANIZED W/8 FEET POSTS  
 ARLINGTON: 28.0 (712.5 LF)  
 STA 68+00.0 - STA 75+40.5 RT (740.5 LF)  
 STA 76+55.5 - STA 78+18.0 RT (162.5 LF)

621.50 MANUFACTURED TERMINAL SECTION, FLARED  
 ARLINGTON:  
 STA 75+05.0 ✓ - STA 75+42.5 LT ✓  
 STA 75+40.5 ✓ - STA 75+78.0 RT ✓  
 STA 75+92.5 ✓ - STA 76+30.0 LT ✓  
 STA 76+18.0 ✓ - STA 76+55.5 RT ✓  
 STA 80+18.0 ✓ - STA 80+55.5 RT ✓

621.80 REMOVAL AND DISPOSAL OF GUARDRAIL  
 ARLINGTON: 90.5  
 STA 68+00.0 - STA 75+78.0 RT (778.0 LF) (790.5 LF)  
 STA 75+06.0 - STA 76+34.0 LT (28.0 LF) (125.0 LF)  
 STA 76+18.0 - STA 80+55.0 RT (437.0 LF) (425.0 LF)  
 09.0

676.10 DELINEATOR WITH STEEL POST  
 ARLINGTON:  
 STA 75+05.0 LT  
 STA 75+78.0 RT  
 STA 76+18.0 RT  
 STA 76+30.0 LT  
 STA 80+55.5 RT

SIGN LEGEND  
 R = REMOVE  
 S = SALVAGE  
 N = NEW  
 RET = RETAIN  
 B-B = BACK TO BACK  
 EXISTING = - - - - -  
 NEW = \_\_\_\_\_

NOT TO SCALE

<b>PROJECT LAYOUT SHEET #4</b>	PROJECT NAME: ARLINGTON	PLOT DATE: 20-FEB-2013 16:40
	PROJECT NUMBER: STP 2334(1)	DRAWN BY: C.A.K.
	FILE NAME: OIC042.dgn	CHECKED BY: D.W.E.
	PROJECT LEADER: D.E.G. DESIGNED BY: M.J.M. IPARM FILE: p01c042i04.i	SHEET 20 OF 143