



646.406 DURABLE 4 INCH WHITE LINE, RECESSED POLYUREA  
 (ALL LINES WILL INCLUDE EDGE LINE BREAKS AND RADIUS FOR TOWN HIGHWAYS)  
 ARLINGTON:  
 STA 82+00.00 - STA 110+00.00 LT & RT

646.602 TEMPORARY 4 INCH WHITE LINE, PAINT  
 (ALL LINES WILL INCLUDE EDGE LINE BREAKS AND RADIUS FOR TOWN HIGHWAYS)  
 ARLINGTON:  
 STA 82+00.00 - STA 110+00.00 LT & RT

646.416 DURABLE 4 INCH YELLOW LINE, RECESSED POLYUREA  
 (ALL LINES WILL INCLUDE C/L BREAKS FOR TOWN HIGHWAYS) S=SOLID, D=DASHED  
 ARLINGTON:  
 STA 82+00.00 - STA 110+00.00 LT ☐ RT ☐  
 S - S - S

646.612 TEMPORARY 4 INCH YELLOW LINE, PAINT  
 (ALL LINES WILL INCLUDE C/L BREAKS FOR TOWN HIGHWAYS) S=SOLID, D=DASHED  
 ARLINGTON:  
 STA 82+00.00 - STA 110+00.00 LT ☐ RT ☐  
 S - S - S

675.50 REMOVING SIGNS AS SHOWN - 2 ✓

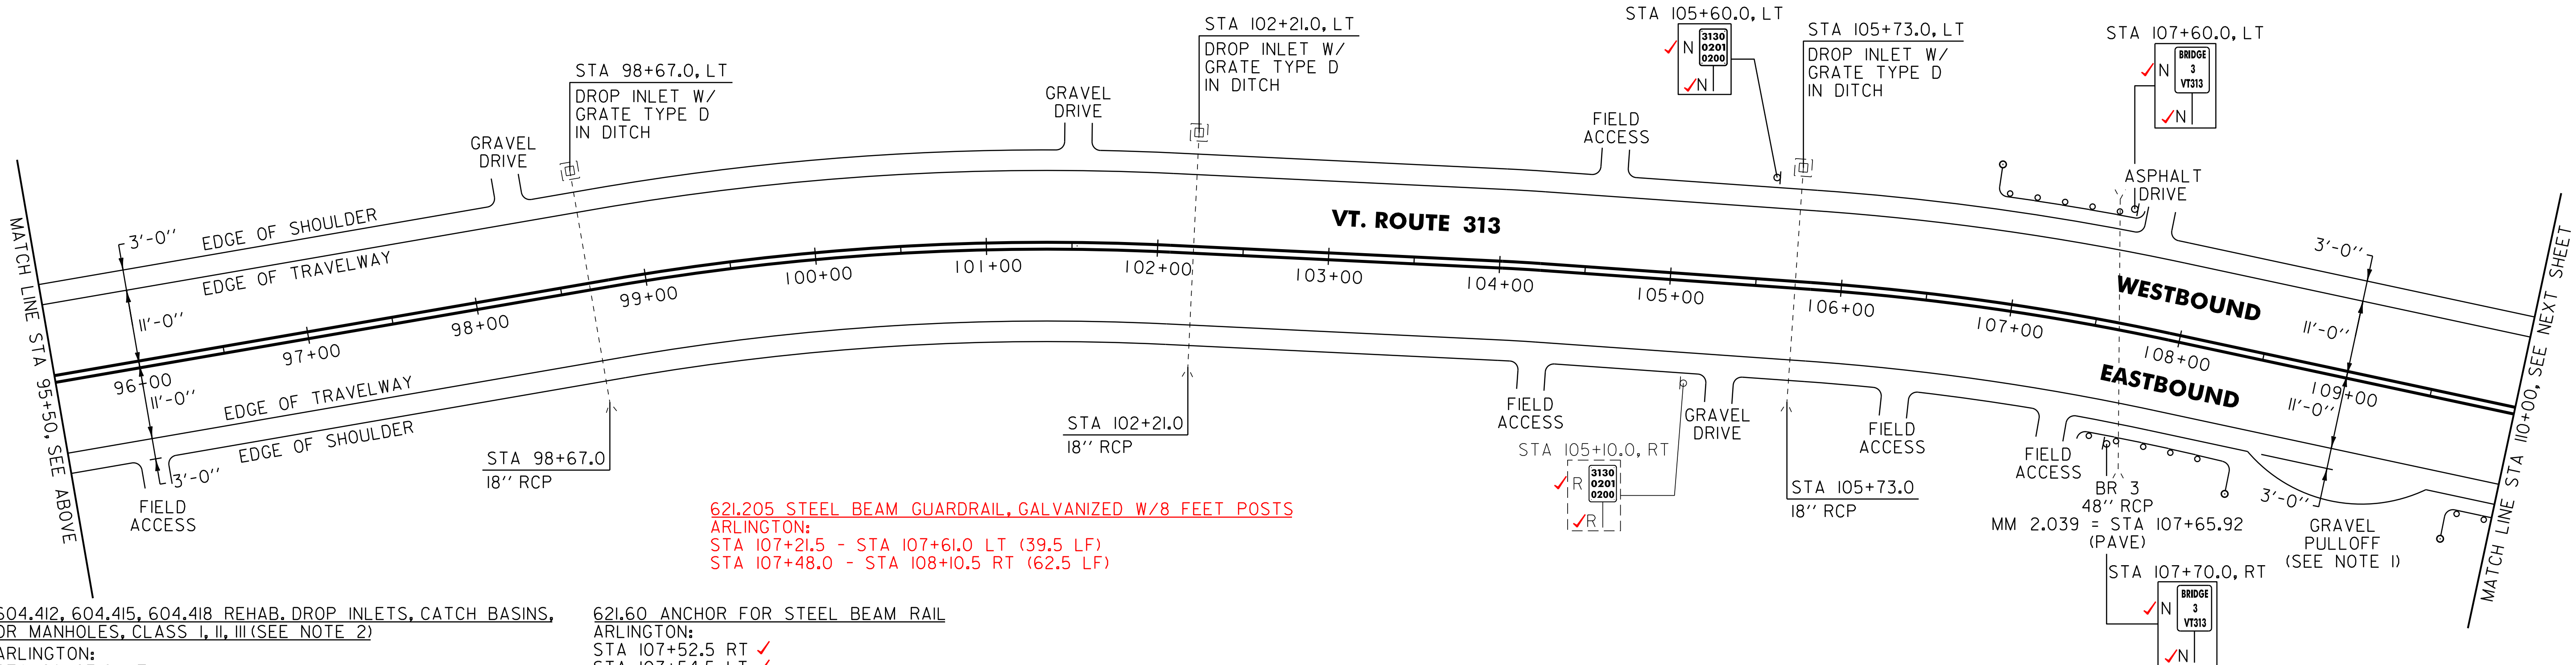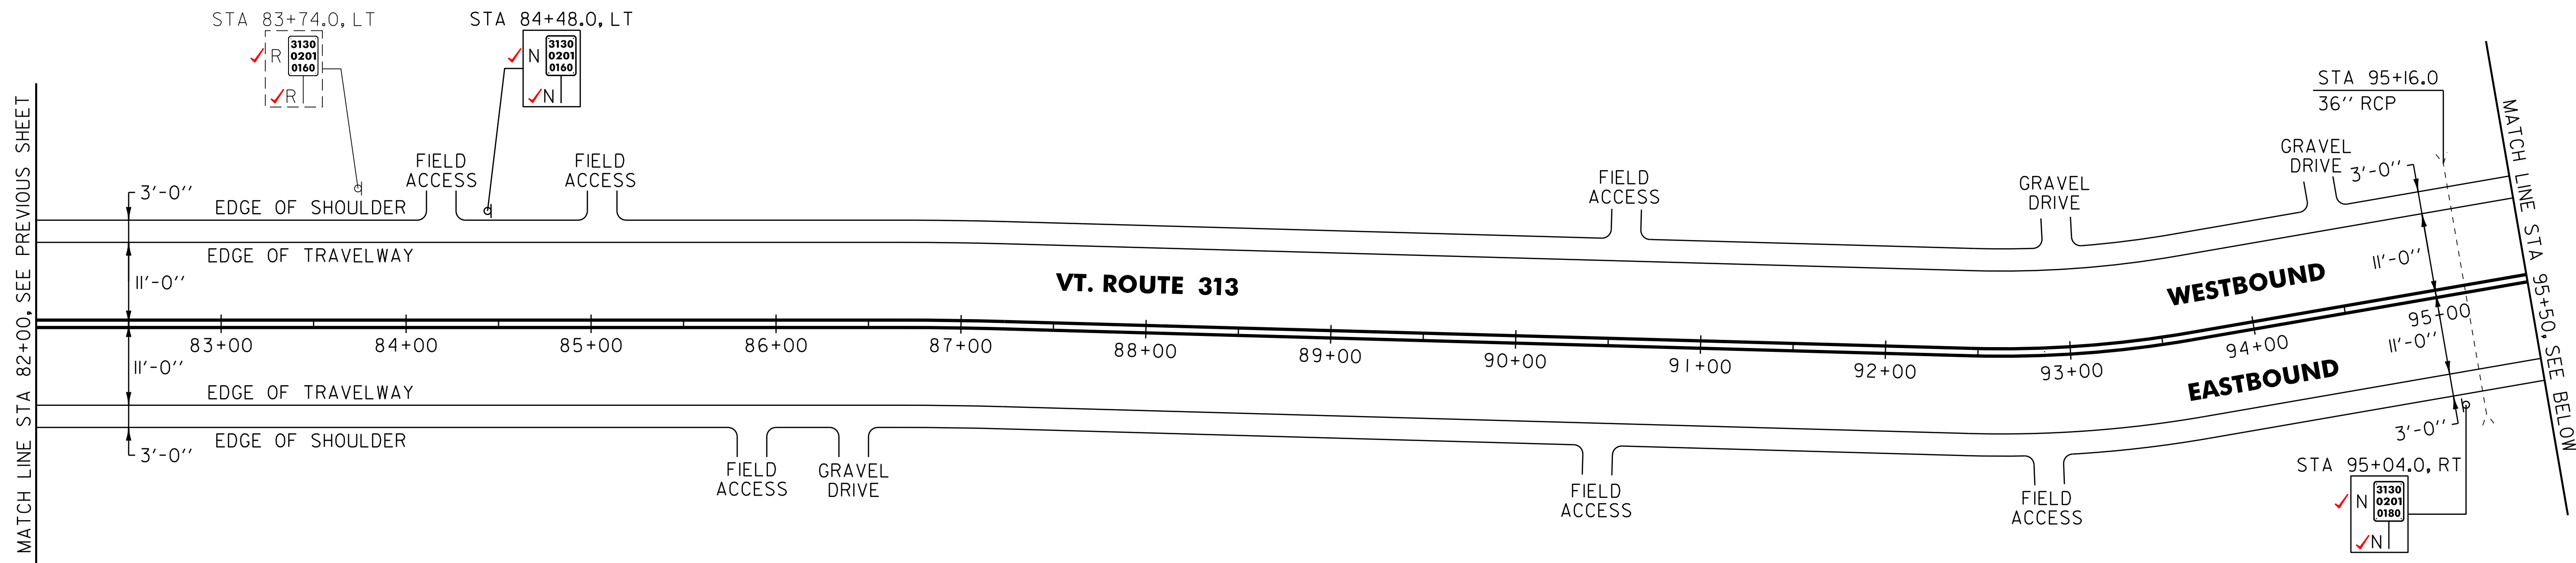

621.205 STEEL BEAM GUARDRAIL, GALVANIZED W/8 FEET POSTS  
 ARLINGTON:  
 STA 107+21.5 - STA 107+61.0 LT (39.5 LF)  
 STA 107+48.0 - STA 108+10.5 RT (62.5 LF)

604.412, 604.415, 604.418 REHAB. DROP INLETS, CATCH BASINS, OR MANHOLES, CLASS I, II, III (SEE NOTE 2)  
 ARLINGTON:  
 STA 98+67.0 LT  
 STA 102+21.0 LT ✓ CLASS I  
 STA 105+73.0 LT ✓ CLASS I

621.60 ANCHOR FOR STEEL BEAM RAIL  
 ARLINGTON:  
 STA 107+52.5 RT ✓  
 STA 107+54.5 LT ✓

~~621.20 STEEL BEAM GUARDRAIL, GALVANIZED~~  
 ARLINGTON:  
~~STA 107+21.5 - STA 107+61.0 LT (39.5 LF)~~  
~~STA 107+48.0 - STA 108+10.5 RT (64.5 LF)~~

621.80 REMOVAL AND DISPOSAL OF GUARDRAIL  
 ARLINGTON:  
 STA 106+91.0 - STA 107+61.0 LT (70.0 LF)  
 STA 107+46.0 - STA 108+45.0 RT (99.0 LF) 108+46.0 (100.0 LF)  
 STA 109+73.0 - STA 110+00.0 RT (26.0 LF)

621.50 MANUFACTURED TERMINAL SECTION, FLARED  
 ARLINGTON:  
 STA 106+84.0 ✓ - STA 107+21.5 LT ✓  
 STA 108+10.5 ✓ - STA 108+48.0 RT ✓  
 STA 109+70.0 ✓ - STA 110+00.0 RT ✓

676.10 DELINEATOR WITH STEEL POST  
 ARLINGTON:  
 STA 106+84.0 LT  
 STA 108+48.0 RT  
 STA 109+70.0 RT

NOTE:  
 I. PROVIDE A 5 FT WIDE, 1/2" TYPE IVS APRON FOR THE EXISTING GRAVEL PULLOUT. ANY REQUIRED EXCAVATION SHALL BE PERFORMED AS DIRECTED BY THE RESIDENT ENGINEER AND PAID FOR UNDER ITEM 608.25 ALL PURPOSE EXCAVATOR RENTAL, TYPE I.

SIGN LEGEND  
 R = REMOVE  
 S = SALVAGE  
 N = NEW  
 RET = RETAIN  
 B-B = BACK TO BACK  
 EXISTING = - - - - -  
 NEW = \_\_\_\_\_

NOT TO SCALE

<b>PROJECT LAYOUT SHEET #5</b>	PROJECT NAME: ARLINGTON	PLOT DATE: 20-FEB-2013 16:40
	PROJECT NUMBER: STP 2334(II)	DRAWN BY: C.A.K.
	FILE NAME: OIC042.dgn	CHECKED BY: D.W.E.
	PROJECT LEADER: D.E.G. DESIGNED BY: M.J.M. IPARM FILE: p01c042105.i	SHEET 21 OF 143