



646.406 DURABLE 4 INCH WHITE LINE, RECESSED POLYUREA  
 (ALL LINES WILL INCLUDE EDGE LINE BREAKS AND RADIUS FOR TOWN HIGHWAYS)  
 ARLINGTON:  
 STA 110+00.00 - STA 137+50.00 LT & RT

646.602 TEMPORARY 4 INCH WHITE LINE, PAINT  
 (ALL LINES WILL INCLUDE EDGE LINE BREAKS AND RADIUS FOR TOWN HIGHWAYS)  
 ARLINGTON:  
 STA 110+00.00 - STA 137+50.00 LT & RT

646.416 DURABLE 4 INCH YELLOW LINE, RECESSED POLYUREA  
 (ALL LINES WILL INCLUDE C/L BREAKS FOR TOWN HIGHWAYS) S=SOLID, D=DASHED  
 ARLINGTON:  
 STA 110+00.00 - STA 137+50.00 LT RT S S

646.612 TEMPORARY 4 INCH YELLOW LINE, PAINT  
 (ALL LINES WILL INCLUDE C/L BREAKS FOR TOWN HIGHWAYS) S=SOLID, D=DASHED  
 ARLINGTON:  
 STA 110+00.00 - STA 137+50.00 LT RT S S

675.50 REMOVING SIGNS AS SHOWN - 6  
 7 ✓

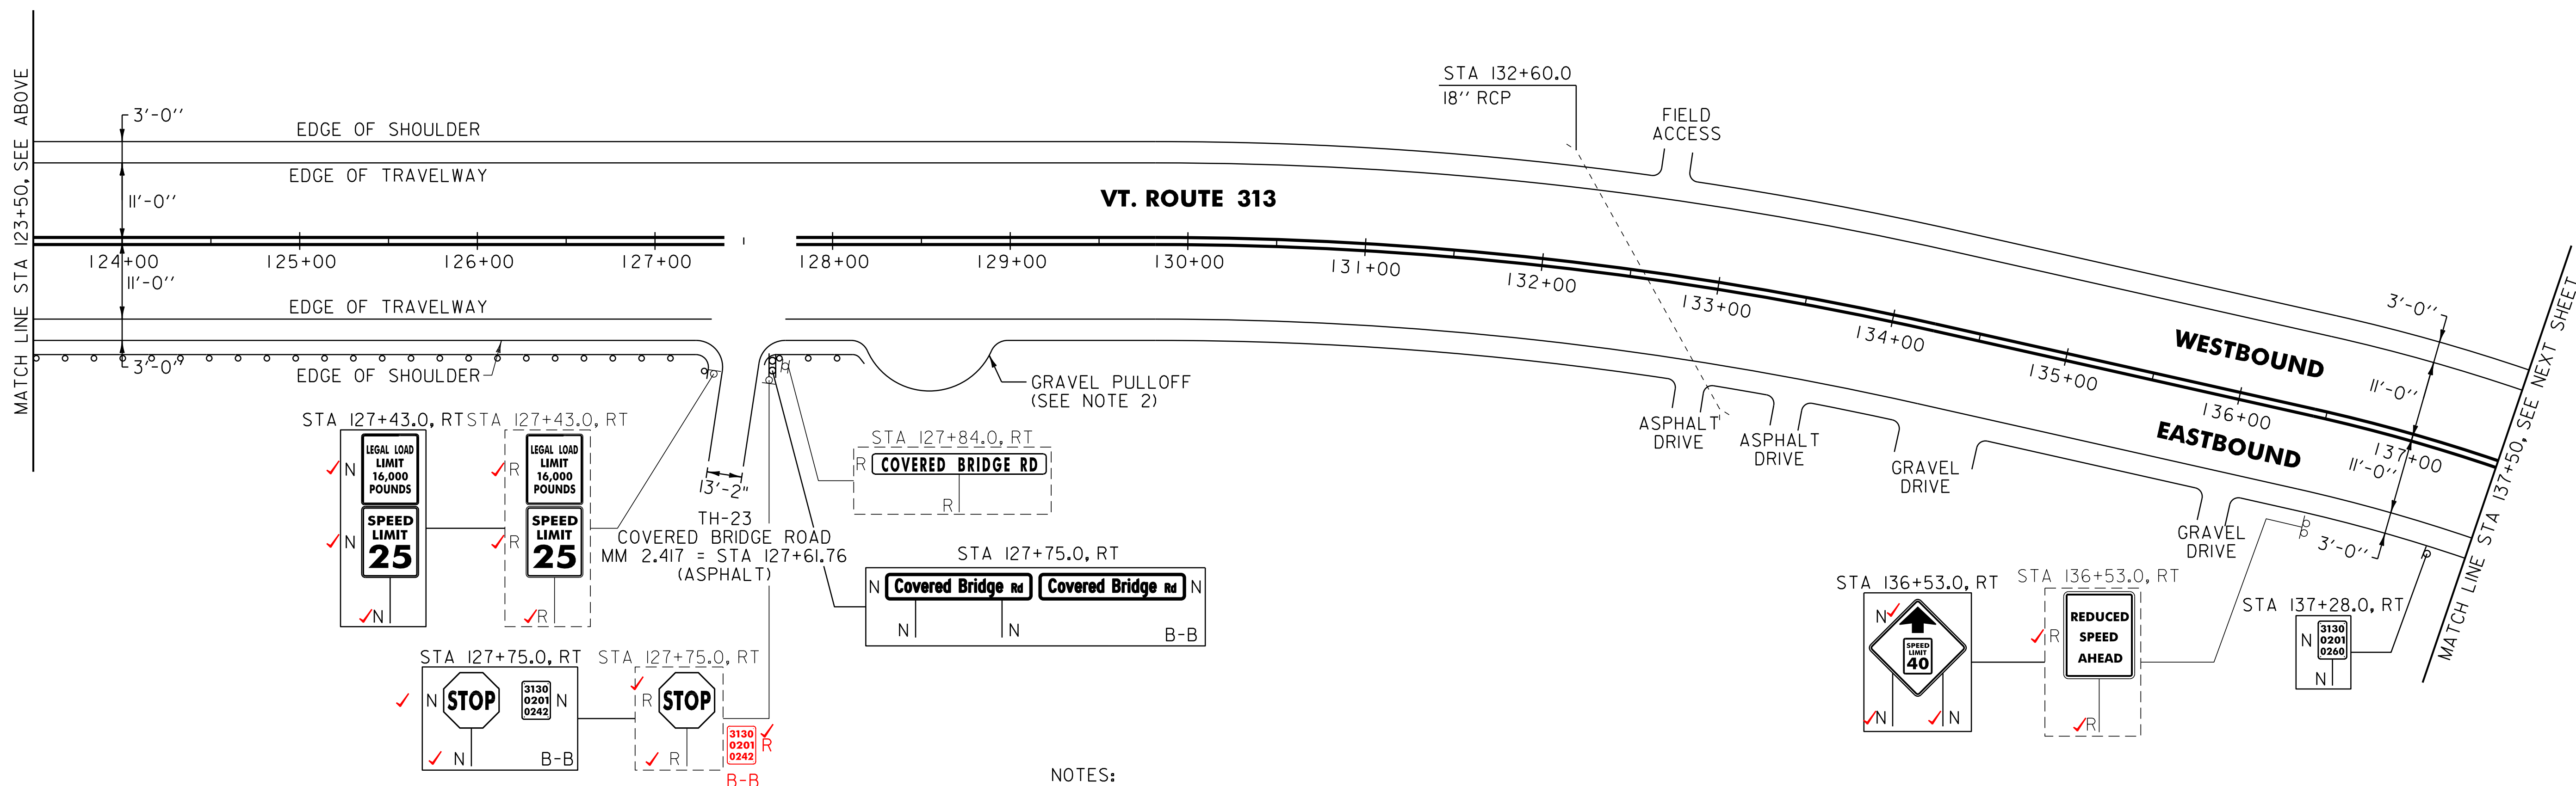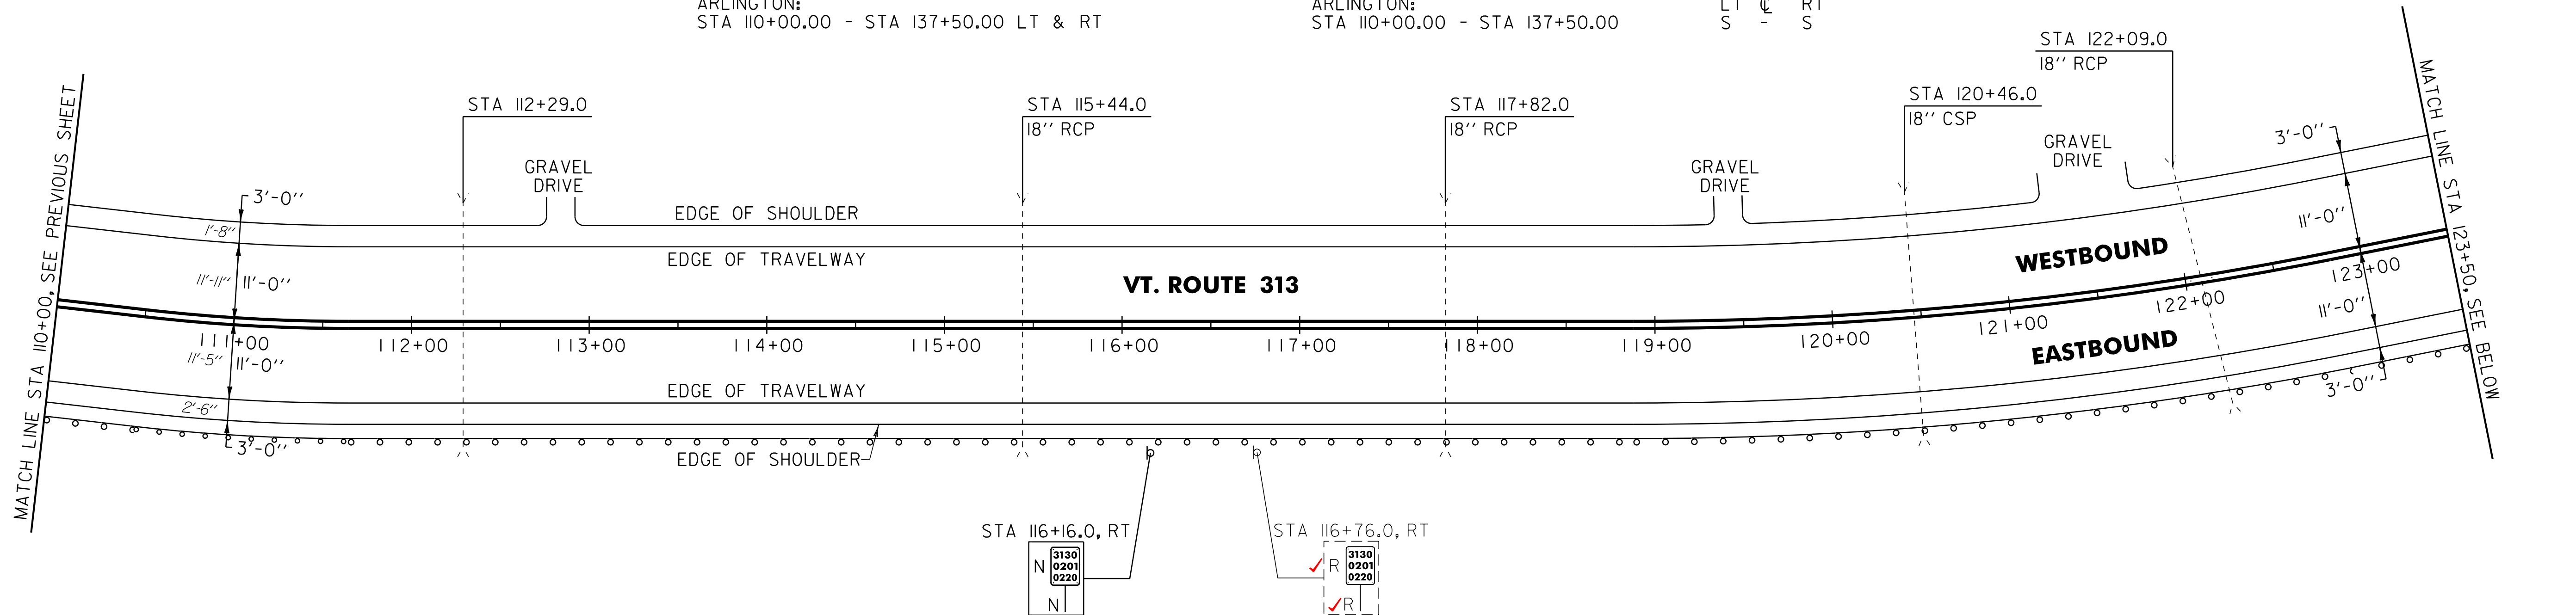

NOTES:

- PAVING LIMIT ON ALL TOWN HIGHWAYS SHALL BE MEASURED 25 FT BACK FROM VT. ROUTE 313 EDGE OF SHOULDER UNLESS DENOTED OTHERWISE ON THE PLANS OR AS DIRECTED BY THE RESIDENT ENGINEER.
- PROVIDE A 5 FT WIDE, 1/2" TYPE IVS APRON FOR THE EXISTING GRAVEL PULLOFF. ANY REQUIRED EXCAVATION SHALL BE PERFORMED AS DIRECTED BY THE RESIDENT ENGINEER AND PAID FOR UNDER ITEM 608.25 ALL PURPOSE EXCAVATOR RENTAL, TYPE I.

SIGN LEGEND  
 R = REMOVE  
 S = SALVAGE  
 N = NEW  
 RET = RETAIN  
 B-B = BACK TO BACK  
 EXISTING = - - - - -  
 NEW = \_\_\_\_\_

NOT TO SCALE

<b>PROJECT LAYOUT SHEET #6</b>	PROJECT NAME: ARLINGTON	PLOT DATE: 20-FEB-2013 16:40
	PROJECT NUMBER: STP 2334(1)	DRAWN BY: C.A.K.
	FILE NAME: OIC042.dgn	CHECKED BY: D.W.E.
	PROJECT LEADER: D.E.G. DESIGNED BY: M.J.M. IPARM FILE: p01c042106.i	SHEET 22 OF 143

621.20 STEEL BEAM GUARDRAIL, GALVANIZED

ARLINGTON:  
 STA 127+71.0 - STA 128+12.5 RT (41.5 LF)  
 73.0 09.0 (66.5 LF)

621.205 STEEL BEAM GUARDRAIL, GALVANIZED W/8 FEET POSTS

ARLINGTON:  
 STA 110+07.5 - STA 127+47.0 RT (4739.5 LF)  
 10.5 45.0 (1750.0 LF)

621.50 MANUFACTURED TERMINAL SECTION, FLARED

ARLINGTON:  
 STA 110+00.0 - STA 110+07.5 RT ✓  
 10.5

621.60 ANCHOR FOR STEEL BEAM RAIL

ARLINGTON:  
 STA 127+40.5 RT ✓  
 STA 127+77.5 RT ✓  
 STA 128+06.0 RT ✓

621.80 REMOVAL AND DISPOSAL OF GUARDRAIL

ARLINGTON: 109+57.5 73.0 (1850.0 LF)  
 STA 110+00.0 - STA 127+45.0 RT (1745.0 LF)  
 STA 127+73.0 - STA 128+09.0 RT (36.0 LF) (62.5 LF)