

646.406 DURABLE 4 INCH WHITE LINE, RECESSED POLYUREA
 (ALL LINES WILL INCLUDE EDGE LINE BREAKS AND
 RADIUS FOR TOWN HIGHWAYS)
 ARLINGTON:
 STA 137+50.00 - STA 151+00.00 LT & RT

646.602 TEMPORARY 4 INCH WHITE LINE, PAINT
 (ALL LINES WILL INCLUDE EDGE LINE BREAKS AND
 RADIUS FOR TOWN HIGHWAYS)
 ARLINGTON:
 STA 137+50.00 - STA 151+00.00 LT & RT

646.416 DURABLE 4 INCH YELLOW LINE, RECESSED POLYUREA
 (ALL LINES WILL INCLUDE C/L BREAKS FOR
 TOWN HIGHWAYS) S=SOLID, D=DASHED
 ARLINGTON:
 STA 137+50.00 - STA 151+00.00 LT C RT
 S - S

646.612 TEMPORARY 4 INCH YELLOW LINE, PAINT
 (ALL LINES WILL INCLUDE C/L BREAKS FOR
 TOWN HIGHWAYS) S=SOLID, D=DASHED
 ARLINGTON:
 STA 137+50.00 - STA 151+00.00 LT C RT
 S - S


646.481 DURABLE 24 INCH STOP BAR, TYPE ITAPE
 ARLINGTON:
 STA 149+05.44 LT, TH-3

646.682 TEMPORARY 24 INCH STOP BAR, PAINT
 ARLINGTON:
 STA 149+05.44 LT, TH-3

646.491 DURABLE LETTER OR SYMBOL, TYPE ITAPE
 ARLINGTON:
 STA 149+05.44 DOUBLE SOLID LT, TH-3 "S,T,O,P" (4 EA)

646.692 TEMPORARY LETTER OR SYMBOL, PAINT
 ARLINGTON:
 STA 149+05.44 DOUBLE SOLID LT, TH-3 "S,T,O,P" (4 EA)

675.50 REMOVING SIGNS
 AS SHOWN - 8 ✓

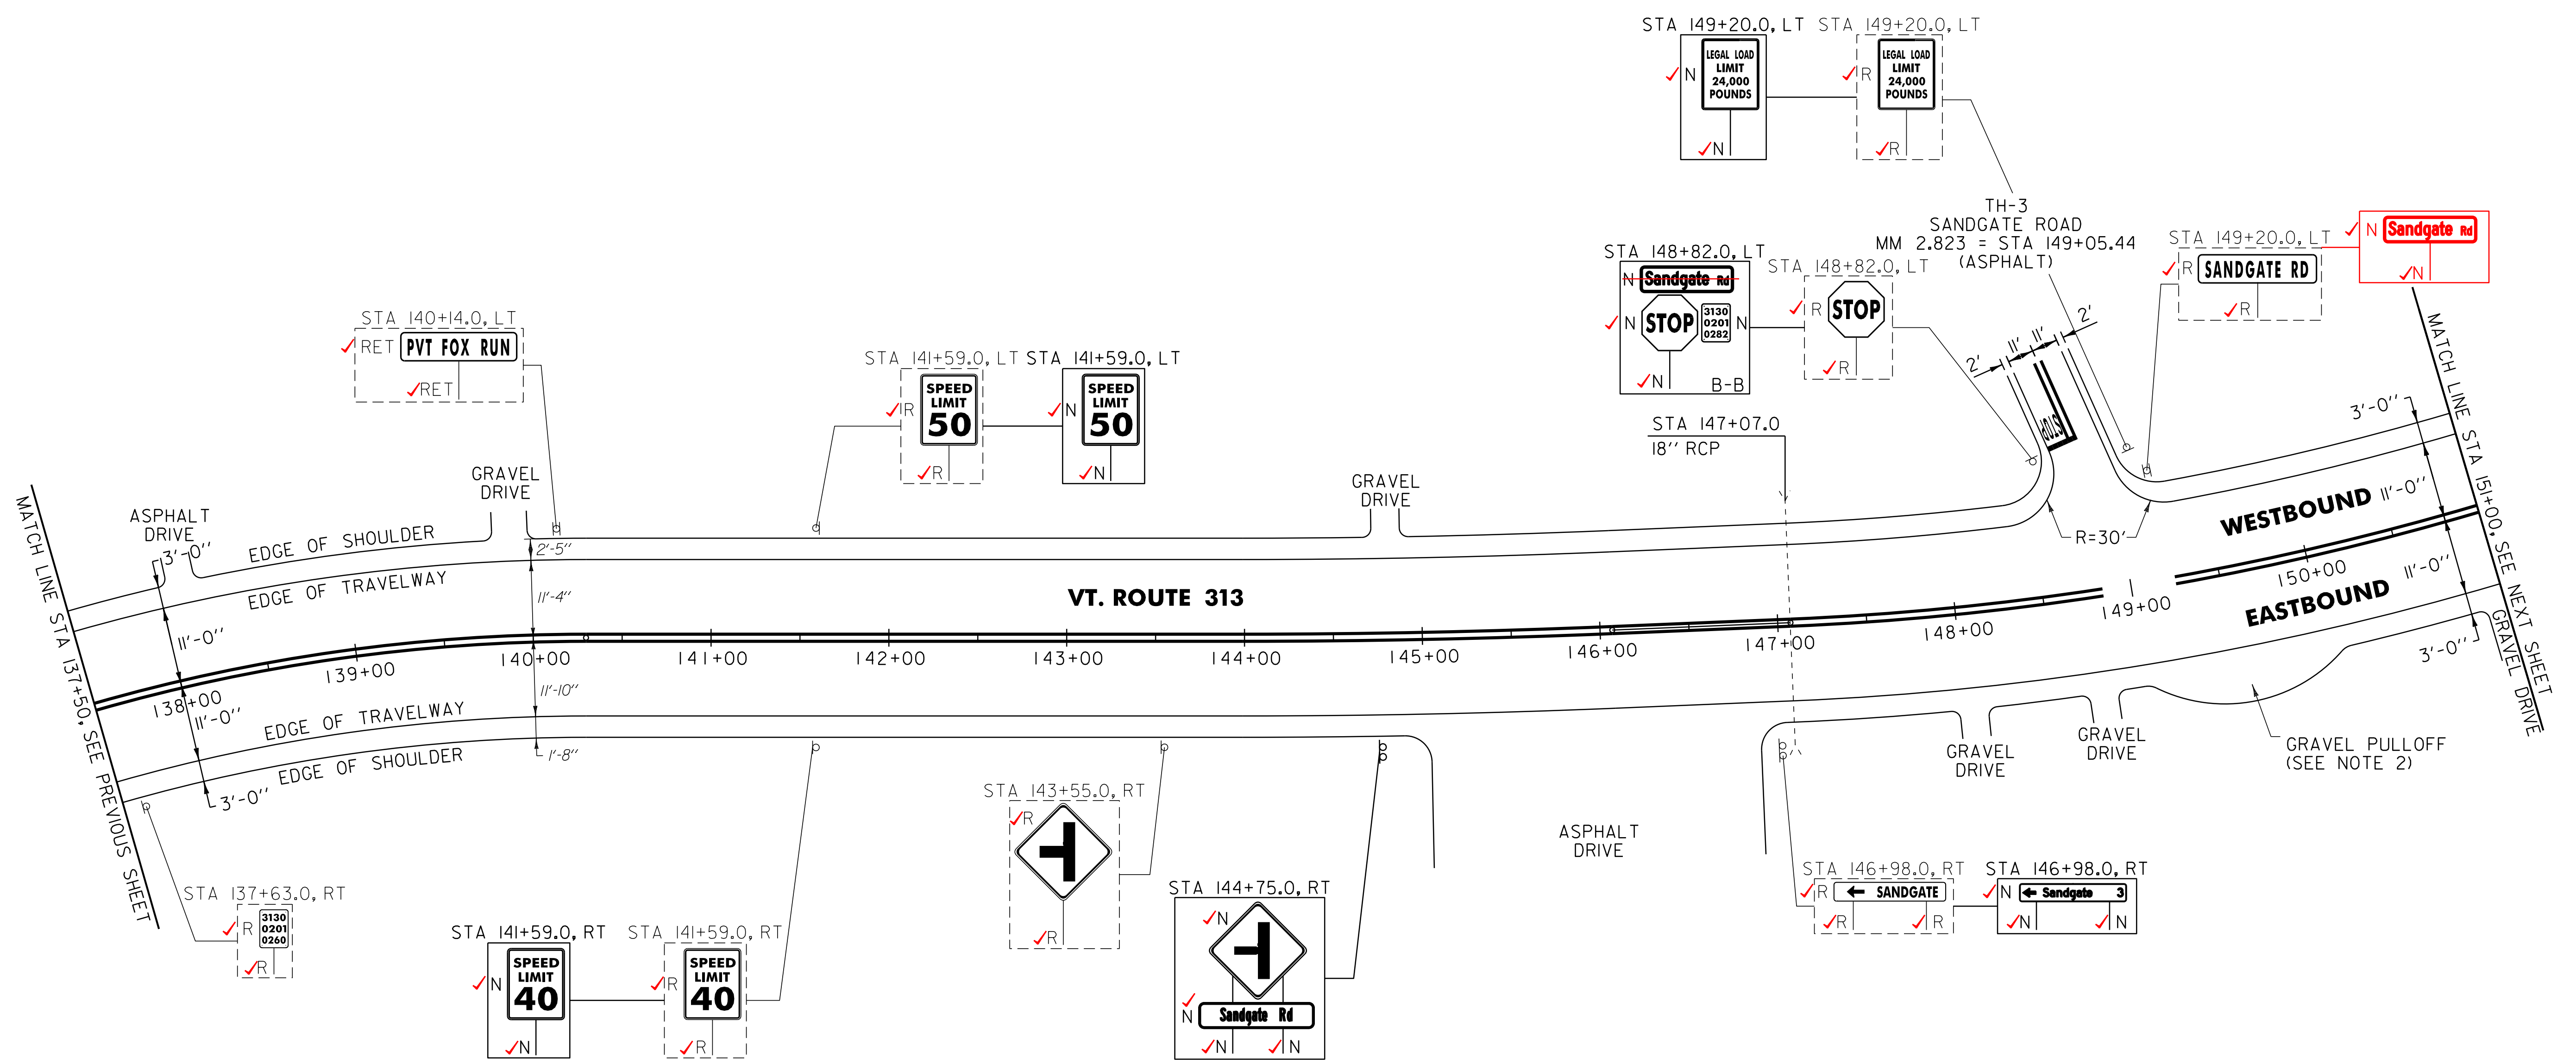

NOTES:

- PAVING LIMIT ON ALL TOWN HIGHWAYS SHALL BE MEASURED 25 FT BACK FROM VT. ROUTE 313 EDGE OF SHOULDER UNLESS DENOTED OTHERWISE ON THE PLANS OR AS DIRECTED BY THE RESIDENT ENGINEER.
- PROVIDE A 5 FT WIDE, 1 1/2" TYPE IVS APRON FOR THE EXISTING GRAVEL PULLOUT, ANY REQUIRED EXCAVATION SHALL BE PERFORMED AS DIRECTED BY THE RESIDENT ENGINEER AND PAID FOR UNDER ITEM 608.25 ALL PURPOSE EXCAVATOR RENTAL, TYPE I.

SIGN LEGEND
 R = REMOVE
 S = SALVAGE
 N = NEW
 RET = RETAIN
 B-B = BACK TO BACK
 EXISTING = - - - - -
 NEW = _____

PROJECT LAYOUT SHEET #7	NOT TO SCALE	
	PROJECT NAME: ARLINGTON	PROJECT NUMBER: STP 2334(1)
	FILE NAME: OIC042.dgn PROJECT LEADER: D.E.G. DESIGNED BY: M.J.M. IPARM FILE: p01c042107.i	PLOT DATE: 20-FEB-2013 16:40 DRAWN BY: C.A.K. CHECKED BY: D.W.E. SHEET 23 OF 143