


646.406 DURABLE 4 INCH WHITE LINE, RECESSED POLYUREA
 (ALL LINES WILL INCLUDE EDGE LINE BREAKS AND
 RADIUS FOR TOWN HIGHWAYS)
 ARLINGTON:
 STA 165+00.00 - STA 194+00.00 LT & RT
 646.602 TEMPORARY 4 INCH WHITE LINE, PAINT
 (ALL LINES WILL INCLUDE EDGE LINE BREAKS AND
 RADIUS FOR TOWN HIGHWAYS)
 ARLINGTON:
 STA 165+00.00 - STA 194+00.00 LT & RT

646.416 DURABLE 4 INCH YELLOW LINE, RECESSED POLYUREA
 (ALL LINES WILL INCLUDE C/L BREAKS FOR
 TOWN HIGHWAYS) S=SOLID, D=DASHED
 ARLINGTON:
 STA 165+00.00 - STA 194+00.00 LT @ RT
 STA 183+63.84 DOUBLE SOLID LT, TH-57 S - S

646.612 TEMPORARY 4 INCH YELLOW LINE, PAINT
 (ALL LINES WILL INCLUDE C/L BREAKS FOR
 TOWN HIGHWAYS) S=SOLID, D=DASHED
 ARLINGTON:
 STA 165+00.00 - STA 194+00.00 LT @ RT
 STA 183+63.84 DOUBLE SOLID LT, TH-57 S - S

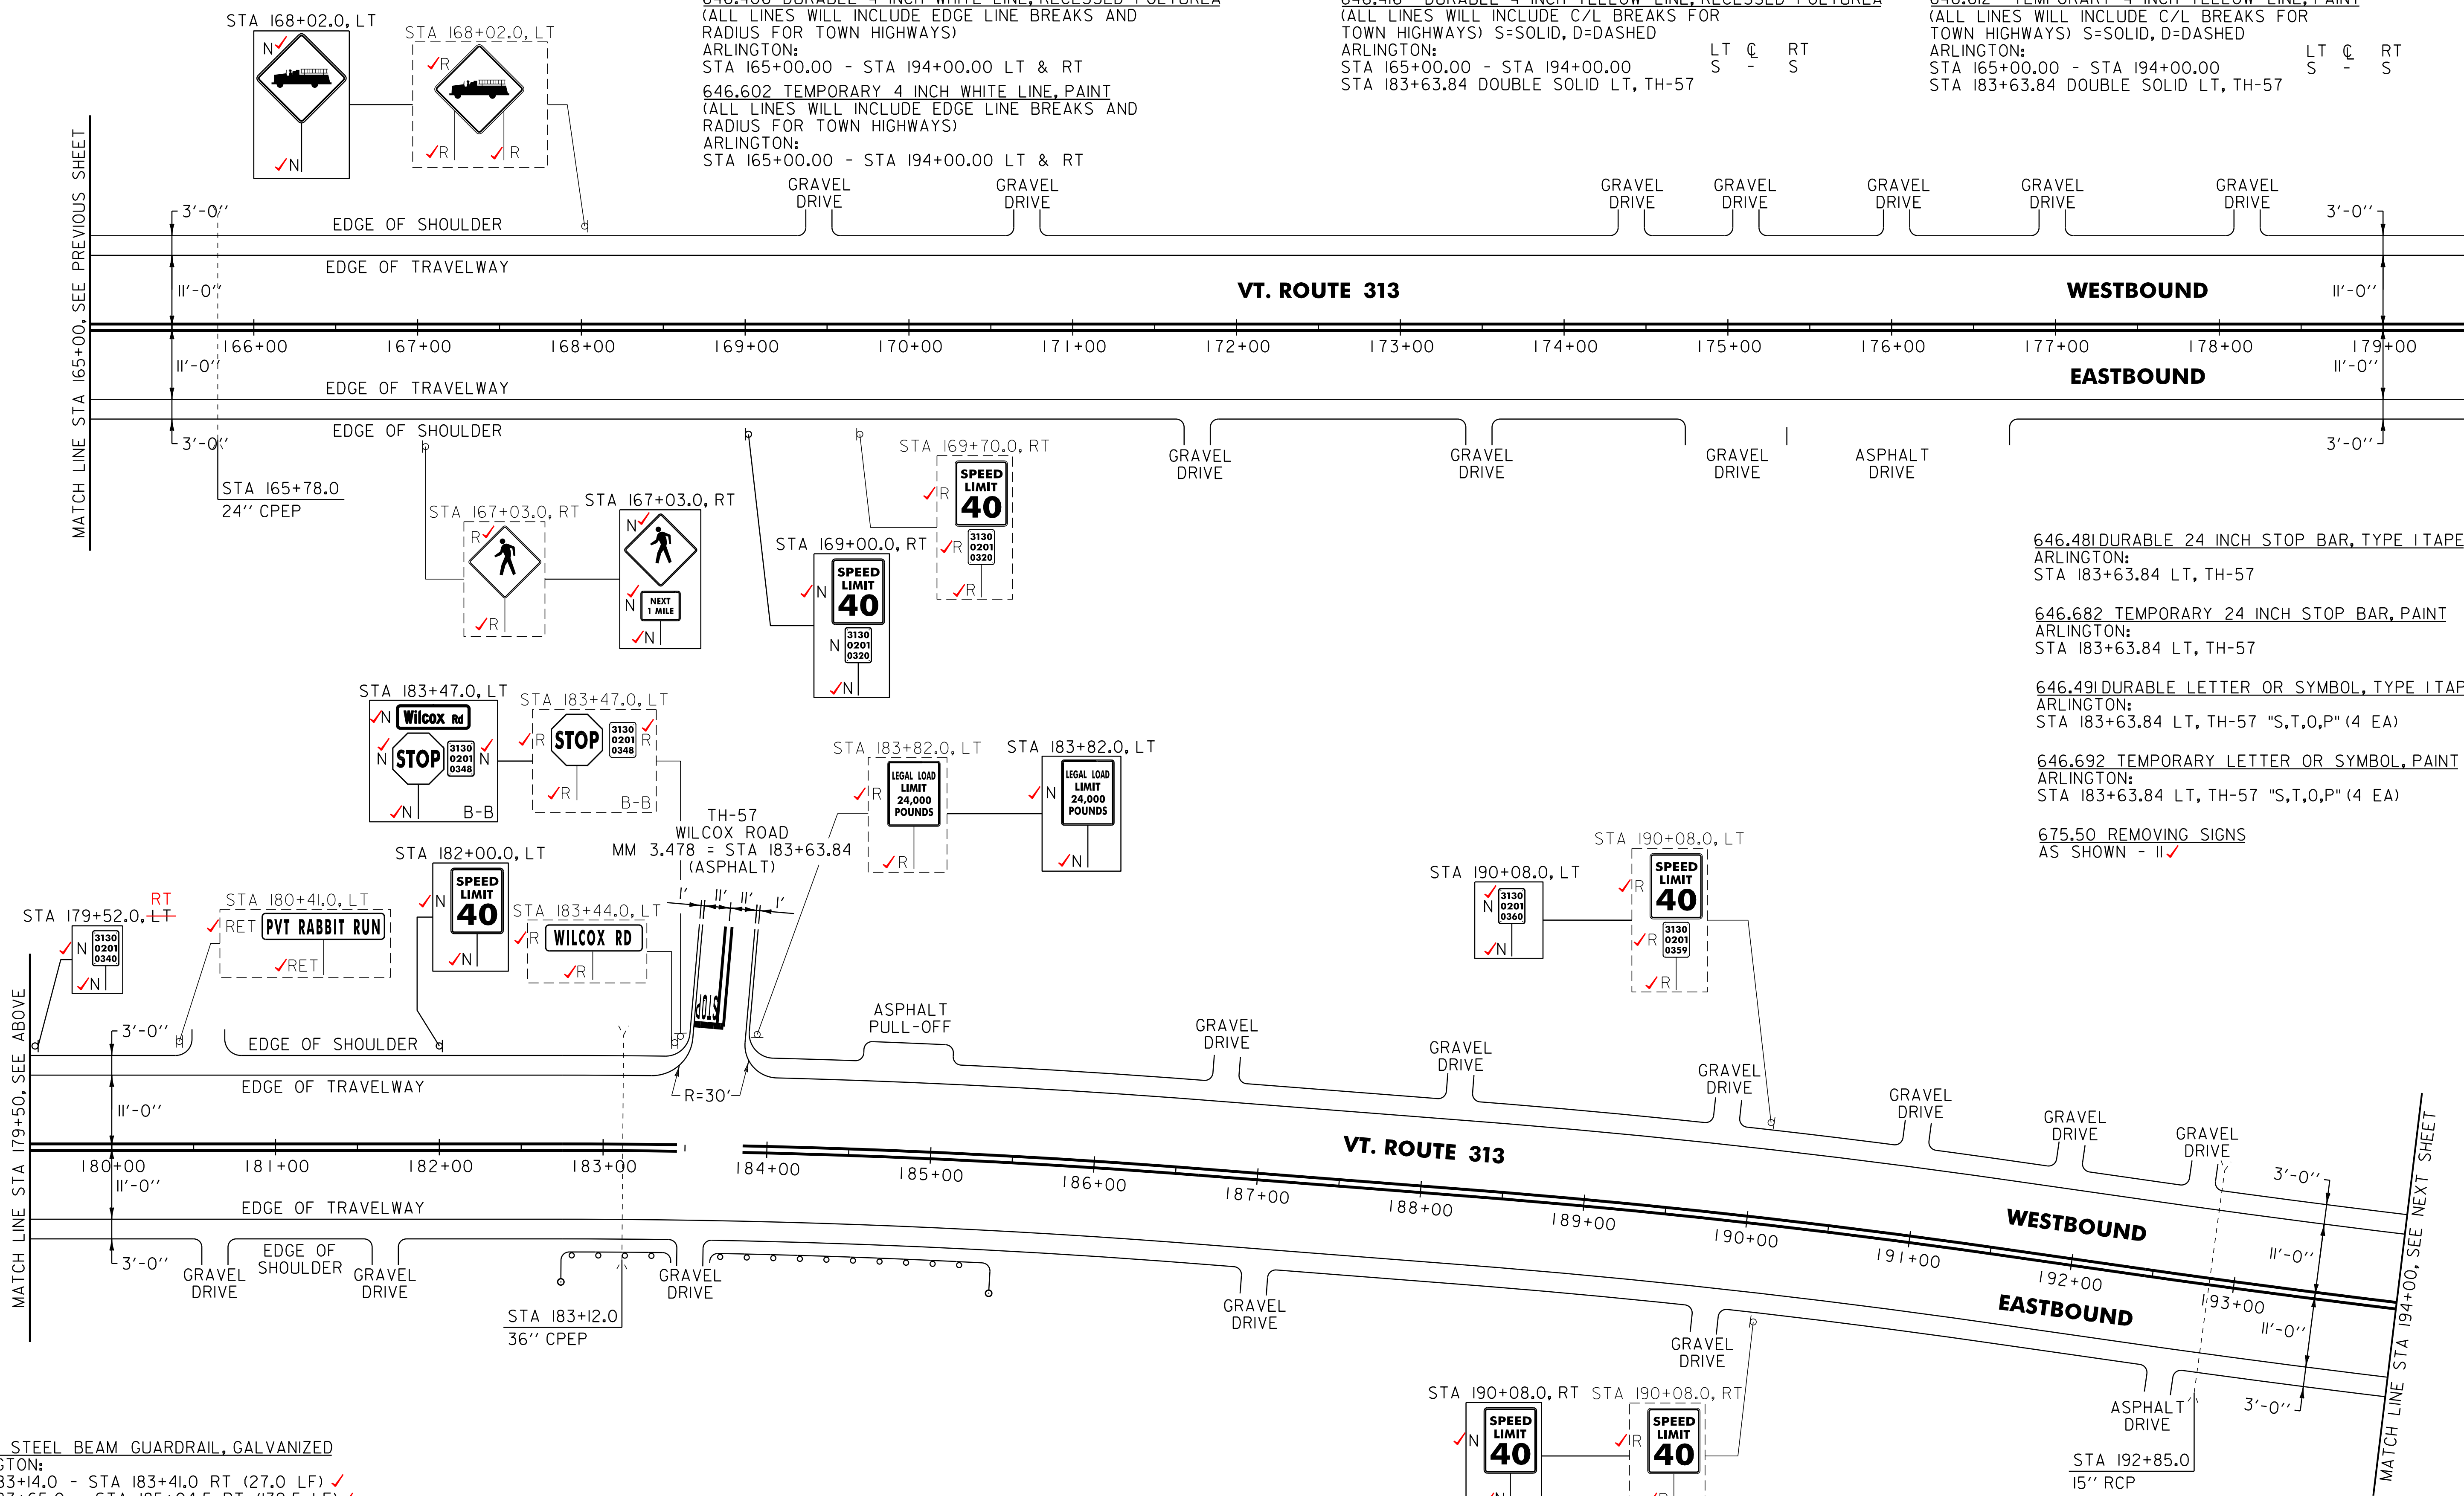

646.481 DURABLE 24 INCH STOP BAR, TYPE ITAPE
 ARLINGTON:
 STA 183+63.84 LT, TH-57

646.682 TEMPORARY 24 INCH STOP BAR, PAINT
 ARLINGTON:
 STA 183+63.84 LT, TH-57

646.491 DURABLE LETTER OR SYMBOL, TYPE ITAPE
 ARLINGTON:
 STA 183+63.84 LT, TH-57 "S,T,O,P" (4 EA)

646.692 TEMPORARY LETTER OR SYMBOL, PAINT
 ARLINGTON:
 STA 183+63.84 LT, TH-57 "S,T,O,P" (4 EA)

675.50 REMOVING SIGNS
 AS SHOWN - II ✓

621.20 STEEL BEAM GUARDRAIL, GALVANIZED
 ARLINGTON:
 STA 183+14.0 - STA 183+41.0 RT (27.0 LF) ✓
 STA 183+65.0 - STA 185+04.5 RT (139.5 LF) ✓

621.50 MANUFACTURED TERMINAL SECTION, FLARED
 ARLINGTON:
 STA 182+76.5 - STA 183+14.0 RT ✓
 STA 185+04.5 - STA 185+42.0 RT ✓

621.60 ANCHOR FOR STEEL BEAM RAIL
 ARLINGTON:
 STA 183+34.5 RT ✓
 STA 183+71.5 RT ✓

621.80 REMOVAL AND DISPOSAL OF GUARDRAIL
 ARLINGTON: 78.5
 STA 182+82.0 - STA 183+41.0 RT (59.0 LF) (62.5 LF)
 STA 183+65.0 - STA 185+30.0 RT (165.0 LF) (175.0 LF)
 40.0

676.10 DELINEATOR WITH STEEL POST
 ARLINGTON:
 STA 182+76.5 RT
 STA 185+42.0 RT

NOTE:
 I. PAVING LIMIT ON ALL TOWN HIGHWAYS SHALL BE MEASURED 25 FT BACK FROM VT. ROUTE 313 EDGE OF SHOULDER UNLESS DENOTED OTHERWISE ON THE PLANS OR AS DIRECTED BY THE RESIDENT ENGINEER.

SIGN LEGEND
 R = REMOVE
 S = SALVAGE
 N = NEW
 RET = RETAIN
 B-B = BACK TO BACK
 EXISTING = - - - - -
 NEW = _____

NOT TO SCALE

PROJECT LAYOUT SHEET #9	PROJECT NAME: ARLINGTON	PLOT DATE: 20-FEB-2013 16:40
	PROJECT NUMBER: STP 2334(1)	DRAWN BY: C.A.K.
	FILE NAME: OIC042.dgn	CHECKED BY: D.W.E.
	PROJECT LEADER: D.E.G. DESIGNED BY: M.J.M. IPARM FILE: p01c042109.i	SHEET 25 OF 143