



646.406 DURABLE 4 INCH WHITE LINE, RECESSED POLYUREA
 (ALL LINES WILL INCLUDE EDGE LINE BREAKS AND RADIUS FOR TOWN HIGHWAYS)
 ARLINGTON:
 STA 222+50.00 - STA 251+00.00 LT & RT

646.602 TEMPORARY 4 INCH WHITE LINE, PAINT
 (ALL LINES WILL INCLUDE EDGE LINE BREAKS AND RADIUS FOR TOWN HIGHWAYS)
 ARLINGTON:
 STA 222+50.00 - STA 251+00.00 LT & RT

646.416 DURABLE 4 INCH YELLOW LINE, RECESSED POLYUREA
 (ALL LINES WILL INCLUDE C/L BREAKS FOR TOWN HIGHWAYS) S=SOLID, D=DASHED
 ARLINGTON:
 STA 222+50.00 -STA 251+00.00 LT CL RT
 S - S

646.612 TEMPORARY 4 INCH YELLOW LINE, PAINT
 (ALL LINES WILL INCLUDE C/L BREAKS FOR TOWN HIGHWAYS) S=SOLID, D=DASHED
 ARLINGTON:
 STA 222+50.00 -STA 251+00.00 LT CL RT
 S - S

675.50 REMOVING SIGNS
 AS SHOWN - 2 ✓

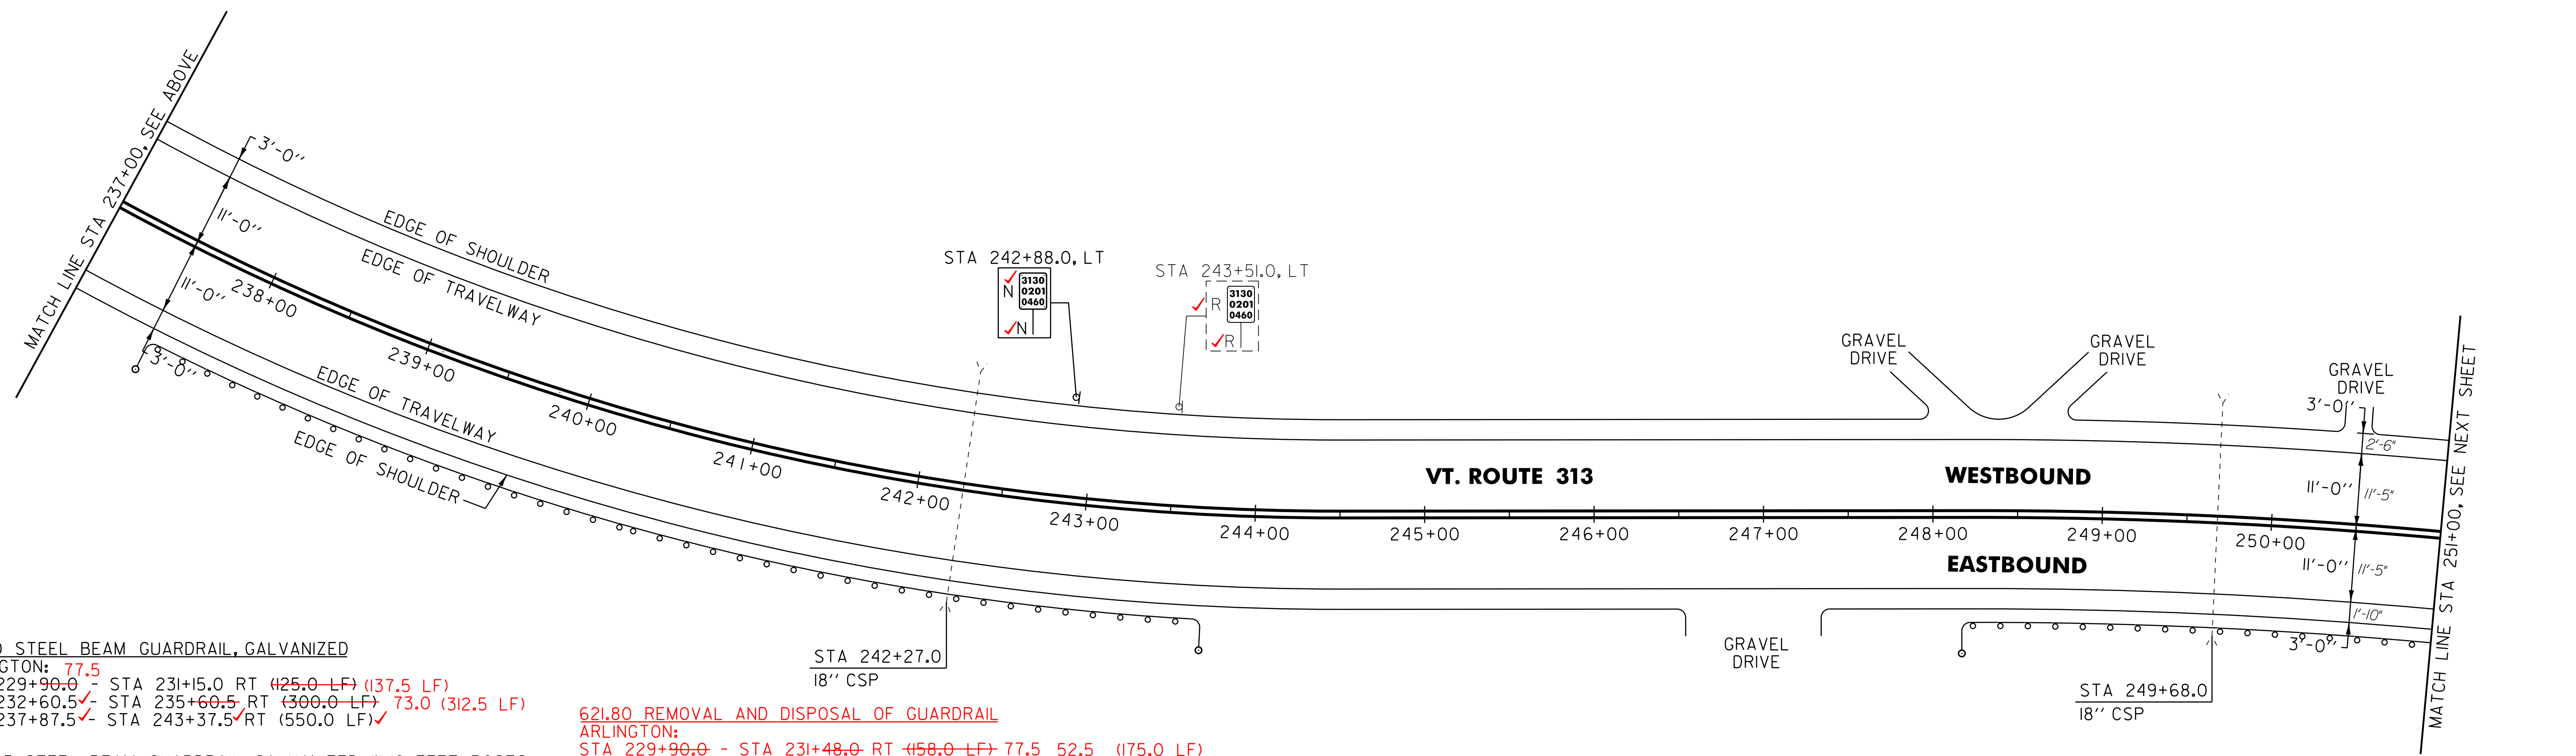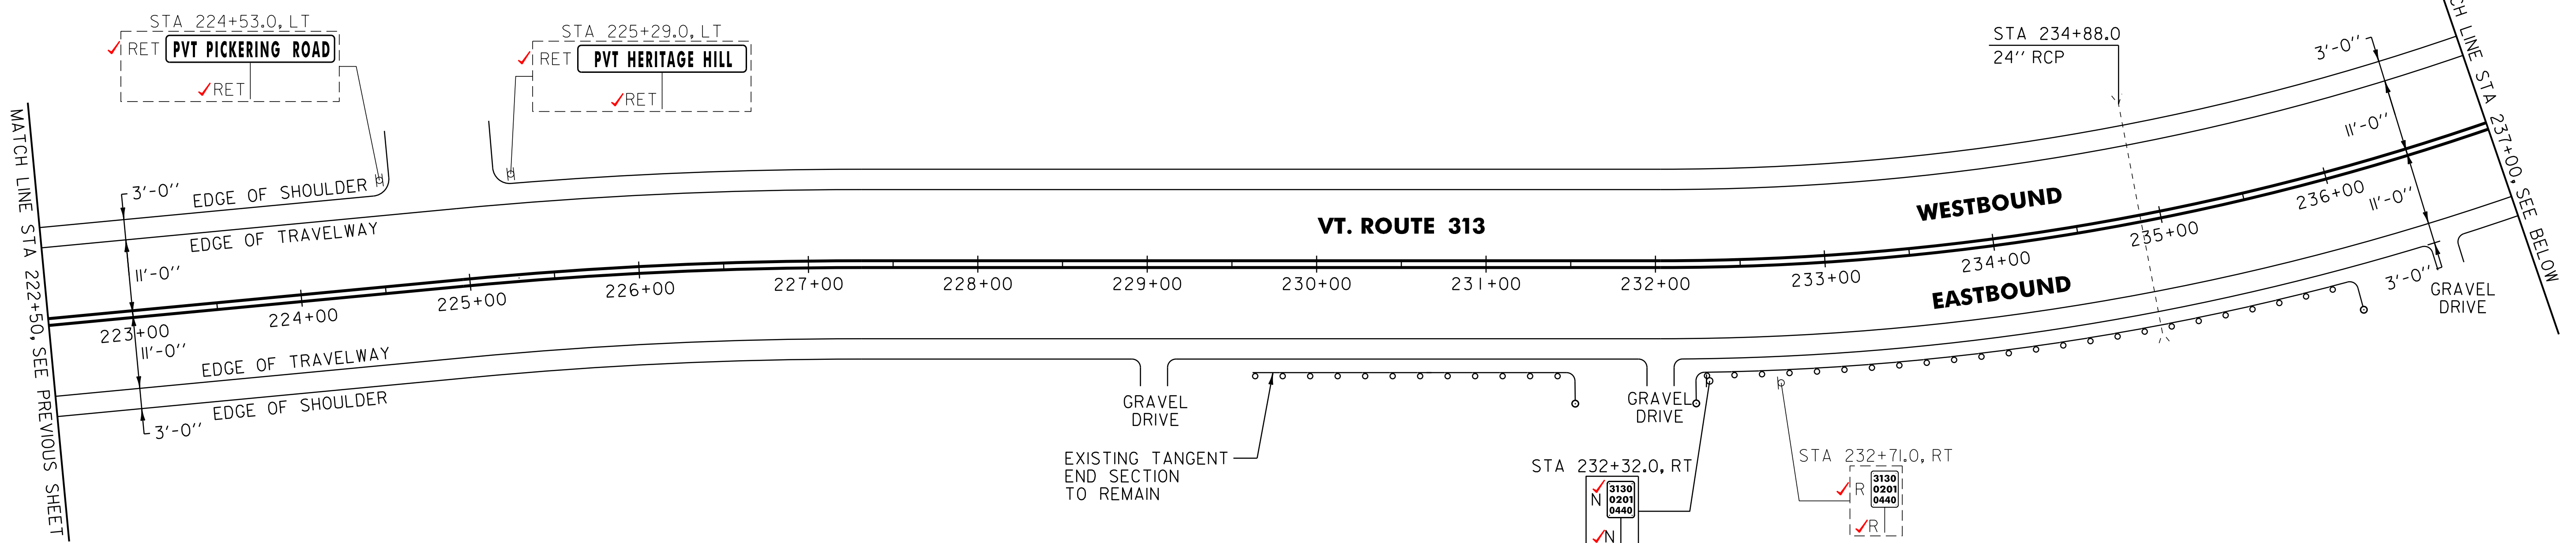

621.20 STEEL BEAM GUARDRAIL, GALVANIZED
 ARLINGTON: 77.5
 STA 229+90.0 - STA 231+15.0 RT (125.0 LF) (137.5 LF)
 STA 232+60.5 - STA 235+60.5 RT (300.0 LF) 73.0 (312.5 LF)
 STA 237+87.5 - STA 243+37.5 RT (550.0 LF) ✓

621.205 STEEL BEAM GUARDRAIL, GALVANIZED W/8 FEET POSTS
 ARLINGTON:
 STA 248+52.5 - STA 251+00.0 RT (247.5 LF)
 52.0 (247.0 LF)

621.50 MANUFACTURED TERMINAL SECTION, FLARED
 ARLINGTON:
 STA 231+15.0 ✓ - STA 231+52.5 RT ✓
 STA 232+23.0 ✓ - STA 232+60.5 RT ✓
 STA 235+60.5 - STA 235+98.0 RT 73.0 236+10.5
 STA 237+50.0 ✓ - STA 237+87.5 RT ✓
 STA 243+37.5 ✓ - STA 243+75.0 RT ✓
 STA 248+15.0 - STA 248+52.5 RT 14.5 52.0

621.80 REMOVAL AND DISPOSAL OF GUARDRAIL
 ARLINGTON:
 STA 229+90.0 - STA 231+48.0 RT (158.0 LF) 77.5 52.5 (175.0 LF)
 STA 232+23.0 - STA 235+97.0 RT (374.0 LF) 236+10.5 (387.5 LF)
 STA 239+09.0 - STA 239+82.0 RT (73.0 LF) 84.0 (75.0 LF)
 STA 240+44.0 - STA 243+64.0 RT (320.0 LF) 69.0 (320.0 LF)
 STA 248+17.0 - STA 251+00.0 RT (283.0 LF) 14.5 (285.5 LF)

621.80 REMOVAL AND DISPOSAL OF GUARDRAIL
 ARLINGTON:
 STA 229+90.0 - STA 231+48.0 RT (158.0 LF)
 STA 232+23.0 - STA 235+97.0 RT (374.0 LF)
 STA 239+09.0 - STA 239+82.0 RT (73.0 LF)
 STA 240+44.0 - STA 243+64.0 RT (320.0 LF)
 STA 248+17.0 - STA 251+00.0 RT (283.0 LF)

676.10 DELINEATOR WITH STEEL POST
 ARLINGTON:
 STA 231+52.5 RT
 STA 232+23.0 RT
 STA 235+98.0 RT
 STA 237+50.0 RT
 STA 243+75.0 RT
 STA 248+15.0 RT

SIGN LEGEND
 R = REMOVE
 S = SALVAGE
 N = NEW
 RET = RETAIN
 B-B = BACK TO BACK
 EXISTING = - - - - -
 NEW = _____

NOT TO SCALE

PROJECT LAYOUT SHEET #11	PROJECT NAME: ARLINGTON	PLOT DATE: 20-FEB-2013 16:40
	PROJECT NUMBER: STP 2334(1)	DRAWN BY: C.A.K.
	FILE NAME: OIC042.dgn	CHECKED BY: D.W.E.
	PROJECT LEADER: D.E.G. DESIGNED BY: M.J.M. IPARM FILE: p01c042III.i	SHEET 27 OF 143