



646.406 DURABLE 4 INCH WHITE LINE, RECESSED POLYUREA
 (ALL LINES WILL INCLUDE EDGE LINE BREAKS AND
 RADIUS FOR TOWN HIGHWAYS)
 ARLINGTON:
 STA 251+00.00 - STA 280+50.00 LT & RT

646.602 TEMPORARY 4 INCH WHITE LINE, PAINT
 (ALL LINES WILL INCLUDE EDGE LINE BREAKS AND
 RADIUS FOR TOWN HIGHWAYS)
 ARLINGTON:
 STA 251+00.00 - STA 280+50.00 LT & RT

646.416 DURABLE 4 INCH YELLOW LINE, RECESSED POLYUREA
 (ALL LINES WILL INCLUDE C/L BREAKS FOR
 TOWN HIGHWAYS) S=SOLID, D=DASHED
 ARLINGTON:
 STA 251+00.00 - STA 280+50.00 LT C RT
 S - S

646.612 TEMPORARY 4 INCH YELLOW LINE, PAINT
 (ALL LINES WILL INCLUDE C/L BREAKS FOR
 TOWN HIGHWAYS) S=SOLID, D=DASHED
 ARLINGTON:
 STA 251+00.00 - STA 280+50.00 LT C RT
 S - S

675.50 REMOVING SIGNS
 AS SHOWN - 2 ✓

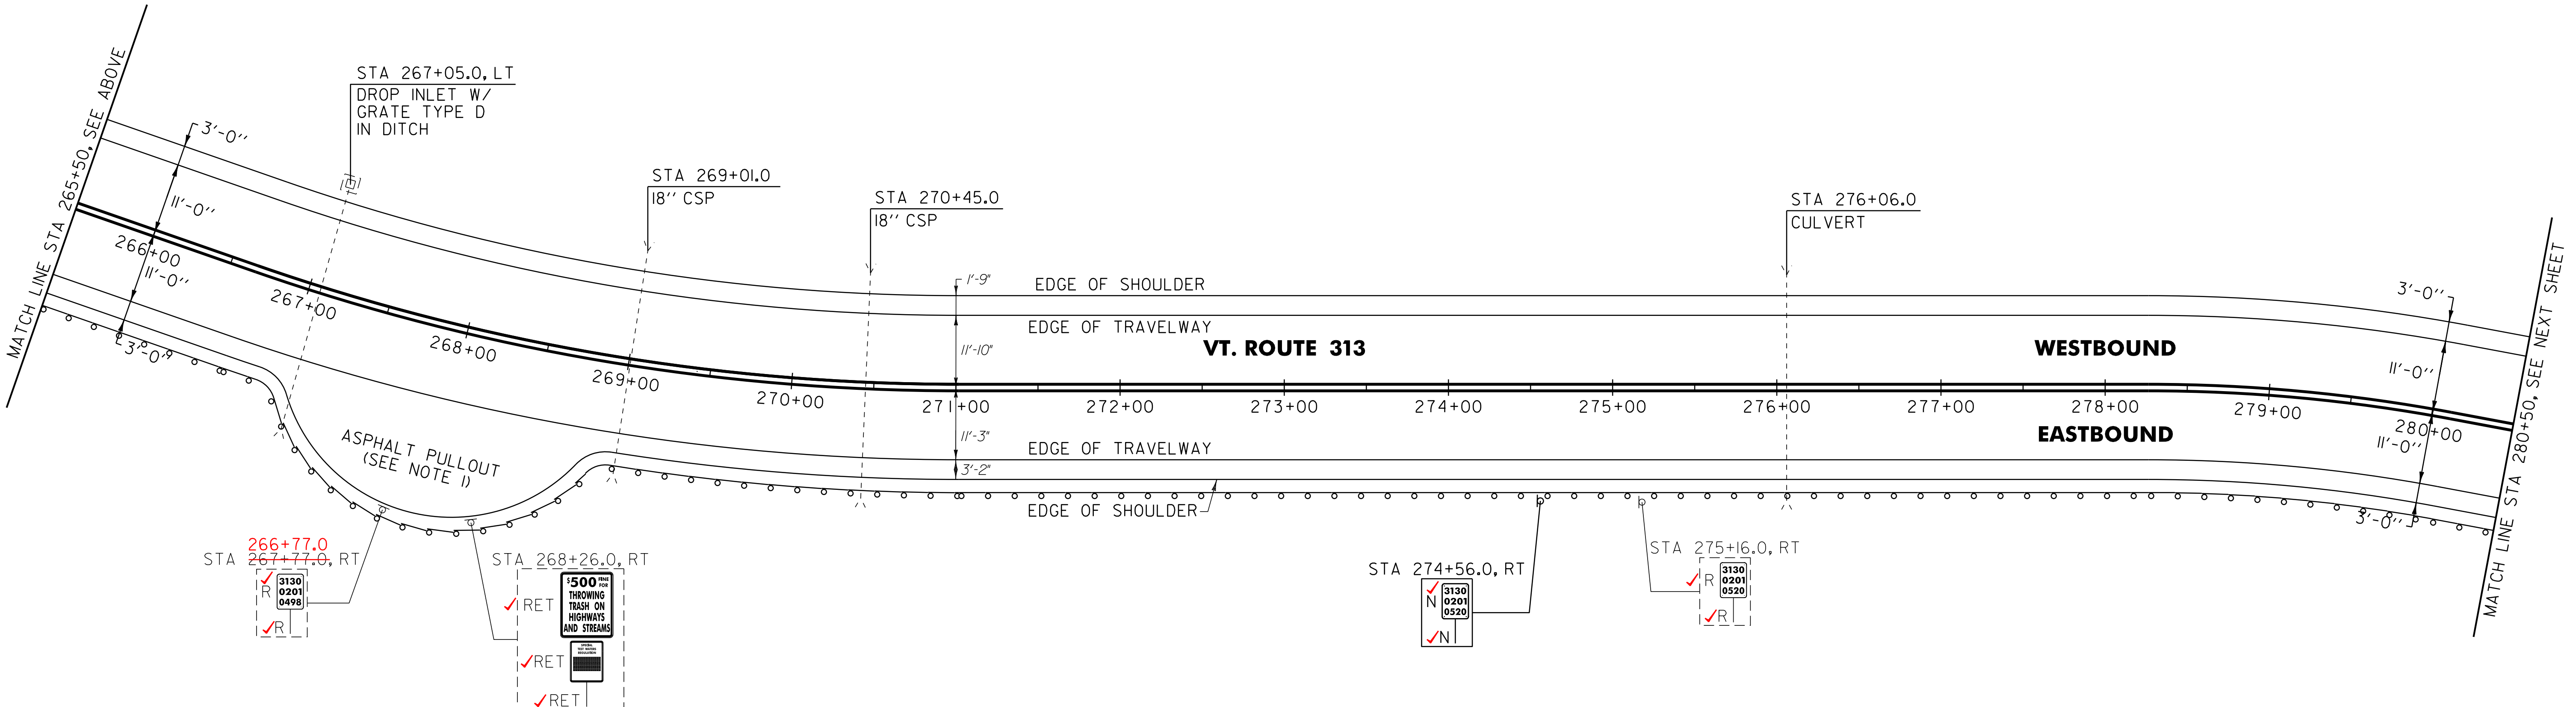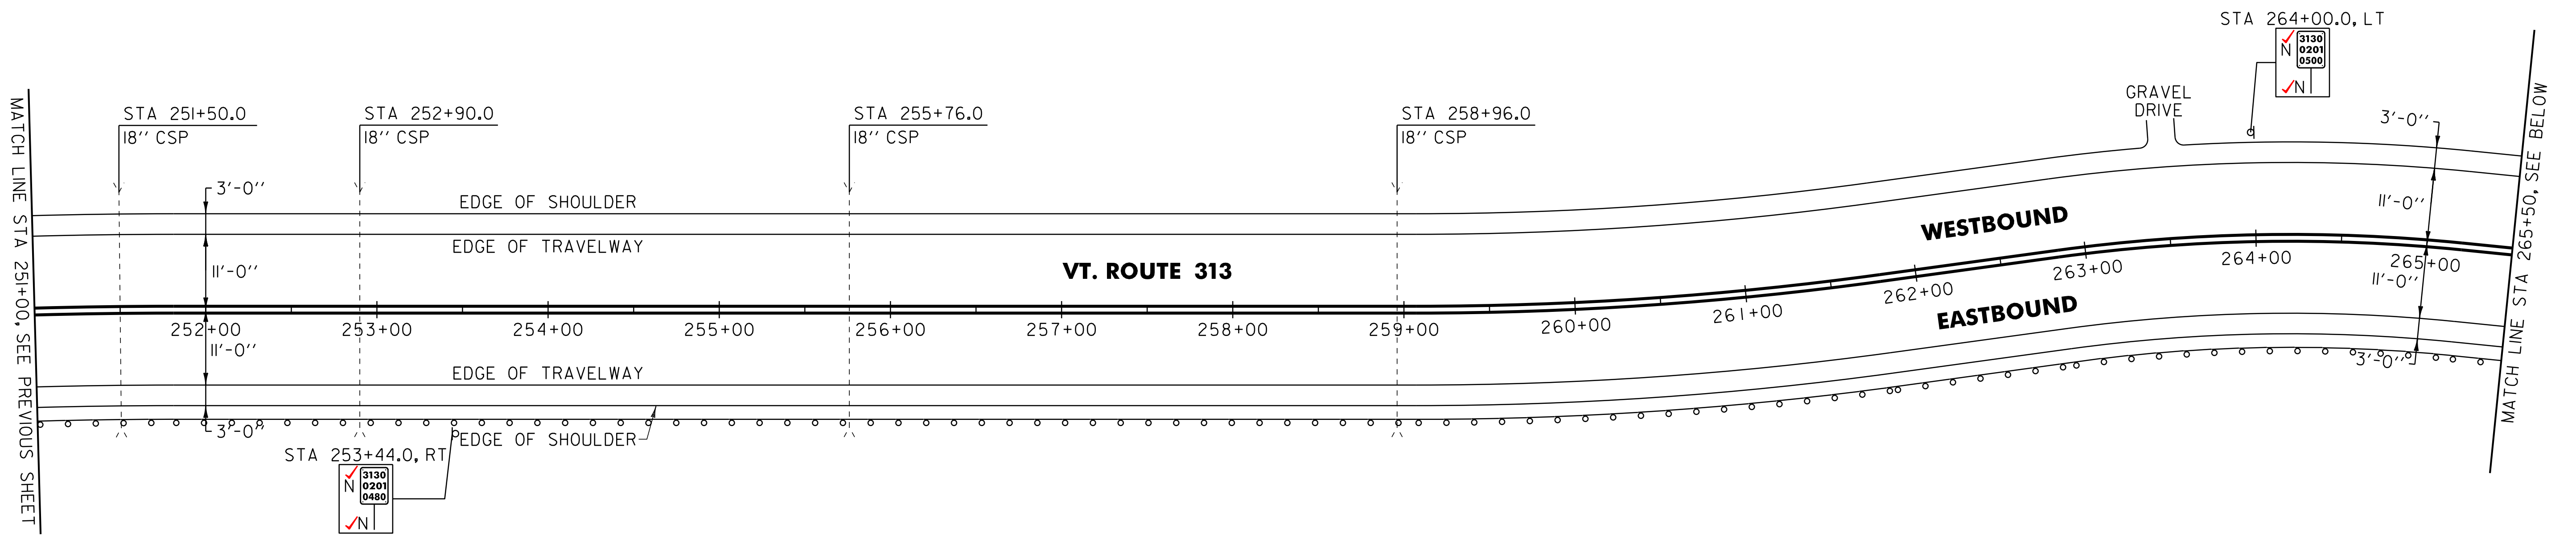

- NOTES:
- THE CONTRACTOR SHALL PAVE THE ENTIRE EXISTING ASPHALT PULLOUT WITH 1/2" TYPE IVS AS DIRECTED BY THE ENGINEER. ANY REQUIRED EXCAVATION SHALL BE PERFORMED AS DIRECTED BY THE RESIDENT ENGINEER AND PAID FOR UNDER ITEM 608.25 ALL PURPOSE EXCAVATOR RENTAL, TYPE I.
 - THE CONTRACTOR SHALL REHAB. THE EXISTING DROP INLETS, CATCH BASINS OR MANHOLES TO A DEPTH AS DIRECTED BY THE RESIDENT ENGINEER. ALL REHAB. WORK WILL BE PAID FOR UNDER THE APPLICABLE REHAB. ITEM AS DIRECTED BY THE RESIDENT ENGINEER. ALL EXISTING UTILITIES MARKED "TO REMAIN" SHALL NOT BE ALTERED OR REHABILITATED UNLESS DIRECTED BY THE RESIDENT ENGINEER.

604.412, 604.415, 604.418 REHAB. DROP INLETS, CATCH BASINS, OR MANHOLES, CLASS I, II, III (SEE NOTE 2)
 ARLINGTON:
 STA 267+05.0 LT ✓ CLASS I

621.205 STEEL BEAM GUARDRAIL, GALVANIZED W/8 FEET POSTS
 ARLINGTON:
 STA 251+00.0 ✓ - STA 280+50.0 RT (2950.0 LF) (2962.5 LF)

621.80 REMOVAL AND DISPOSAL OF GUARDRAIL → ADDITIONAL REMOVAL FOR OPENING PER DTA AT:
 ARLINGTON:
 STA 251+00.0 ✓ - STA 267+77.0 RT ✓ (1677.0 LF) ✓
 77.5 STA 268+85.0 - STA 280+50.0 RT ✓ (1172.5 LF)

621.60 ANCHOR FOR STEEL BEAM RAIL
 ARLINGTON:
 STA 268+18.75 RT
 STA 268+56.25 RT

SIGN LEGEND
 R = REMOVE
 S = SALVAGE
 N = NEW
 RET = RETAIN
 B-B = BACK TO BACK
 EXISTING = - - - - -
 NEW = _____

NOT TO SCALE

| | | |
|---------------------------------|-----------------------------|------------------------------|
| PROJECT LAYOUT SHEET #12 | PROJECT NAME: ARLINGTON | PLOT DATE: 20-FEB-2013 16:40 |
| | PROJECT NUMBER: STP 2334(1) | DRAWN BY: C.A.K. |
| | FILE NAME: OIC042.dgn | CHECKED BY: D.W.E. |
| | PROJECT LEADER: D.E.G. | SHEET 28 OF 143 |
| | DESIGNED BY: M.J.M. | |
| | IPARM FILE: p01c042112.i | |