


646.406 DURABLE 4 INCH WHITE LINE, RECESSED POLYUREA
 (ALL LINES WILL INCLUDE EDGE LINE BREAKS AND
 RADIUS FOR TOWN HIGHWAYS)
 ARLINGTON:
 STA 280+50.00 - STA 308+00.00 LT & RT

646.602 TEMPORARY 4 INCH WHITE LINE, PAINT
 (ALL LINES WILL INCLUDE EDGE LINE BREAKS AND
 RADIUS FOR TOWN HIGHWAYS)
 ARLINGTON:
 STA 280+50.00 - STA 308+00.00 LT & RT

646.416 DURABLE 4 INCH YELLOW LINE, RECESSED POLYUREA
 (ALL LINES WILL INCLUDE C/L BREAKS FOR
 TOWN HIGHWAYS) S=SOLID, D=DASHED
 ARLINGTON:
 STA 280+50.00 - STA 308+00.00 LT & RT S - S

646.612 TEMPORARY 4 INCH YELLOW LINE, PAINT
 (ALL LINES WILL INCLUDE C/L BREAKS FOR
 TOWN HIGHWAYS) S=SOLID, D=DASHED
 ARLINGTON:
 STA 280+50.00 - STA 308+00.00 LT & RT S - S

675.50 REMOVING SIGNS
 AS SHOWN - 7 ✓

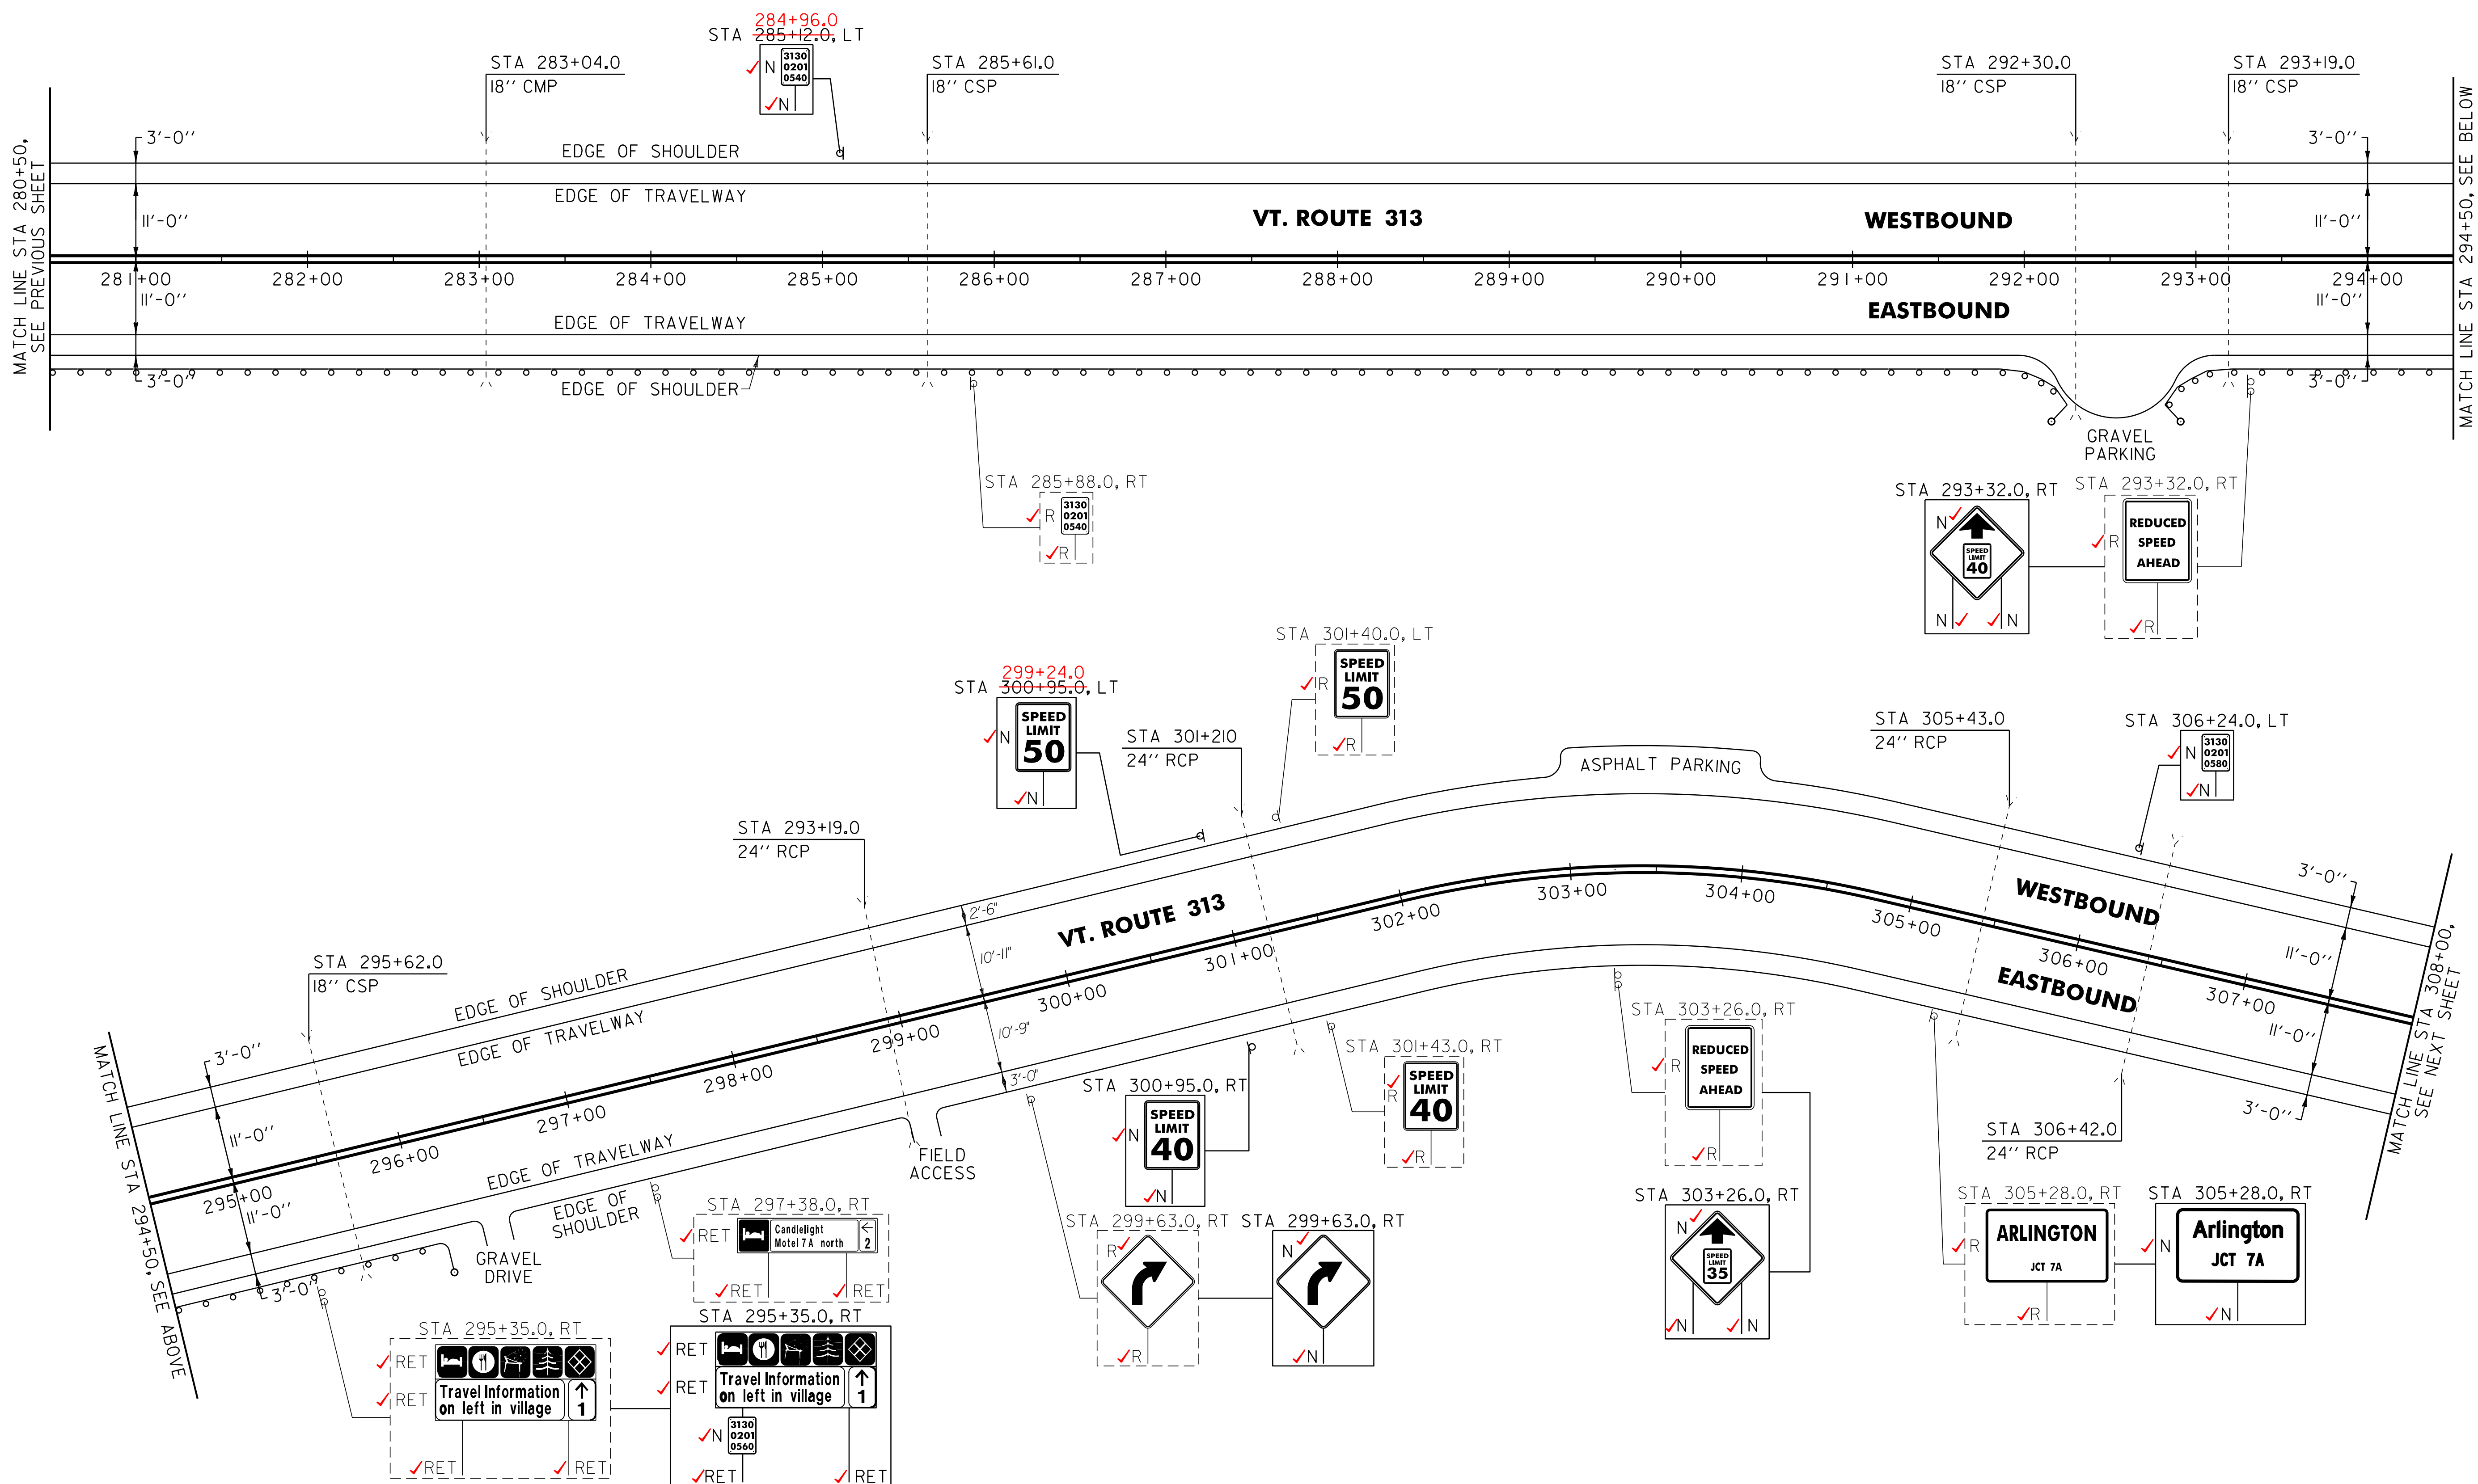

621.20 STEEL BEAM GUARDRAIL, GALVANIZED
 ARLINGTON:
 STA 293+19.5 ✓ - STA 295+69.5 ✓ RT (250.0 LF) ✓

621.205 STEEL BEAM GUARDRAIL, GALVANIZED W/8 FEET POSTS
 ARLINGTON:
 STA 280+50.0 ✓ - STA 291+90.0 ✓ RT (1140.0 LF) ✓

621.50 MANUFACTURED TERMINAL SECTION, FLARED
 ARLINGTON:
 STA 291+90.0 ✓ - STA 292+27.5 RT ✓
 STA 292+82.0 ✓ - STA 293+19.5 RT ✓
 STA 295+69.5 ✓ - STA 296+07.0 RT ✓

621.80 REMOVAL AND DISPOSAL OF GUARDRAIL
 ARLINGTON:
 STA 280+50.0 ✓ - STA 292+25.0 RT (175.0 LF) ✓
 STA 292+82.0 ✓ - STA 296+08.0 RT (326.0 LF) ✓
 27.5 (1177.5 LF)
 07.0 (325.0 LF)

676.10 DELINEATOR WITH STEEL POST
 ARLINGTON:
 STA 292+27.5 RT
 STA 292+82.0 RT
 STA 296+07.0 RT

SIGN LEGEND
 R = REMOVE
 S = SALVAGE
 N = NEW
 RET = RETAIN
 B-B = BACK TO BACK
 EXISTING = - - - - -
 NEW = _____

PROJECT LAYOUT SHEET #13	NOT TO SCALE	
	PROJECT NAME: ARLINGTON	PROJECT NUMBER: STP 2334(1)
	FILE NAME: OIC042.dgn	PLOT DATE: 20-FEB-2013 16:40
	PROJECT LEADER: D.E.G. DESIGNED BY: M.J.M. IPARM FILE: p01c0421i3.i	DRAWN BY: C.A.K. CHECKED BY: D.W.E. SHEET 29 OF 143