


COLOR: WHITE BORDER & TEXT (REFLECTORIZED)  
GREEN BACKGROUND (REFLECTORIZED)

MATERIAL: PER VAOT STANDARD E-123


LOCATION: VT. ROUTE 313  
ARLINGTON:  
STA 34+50.0, RT  
STA 317+30.0, RT

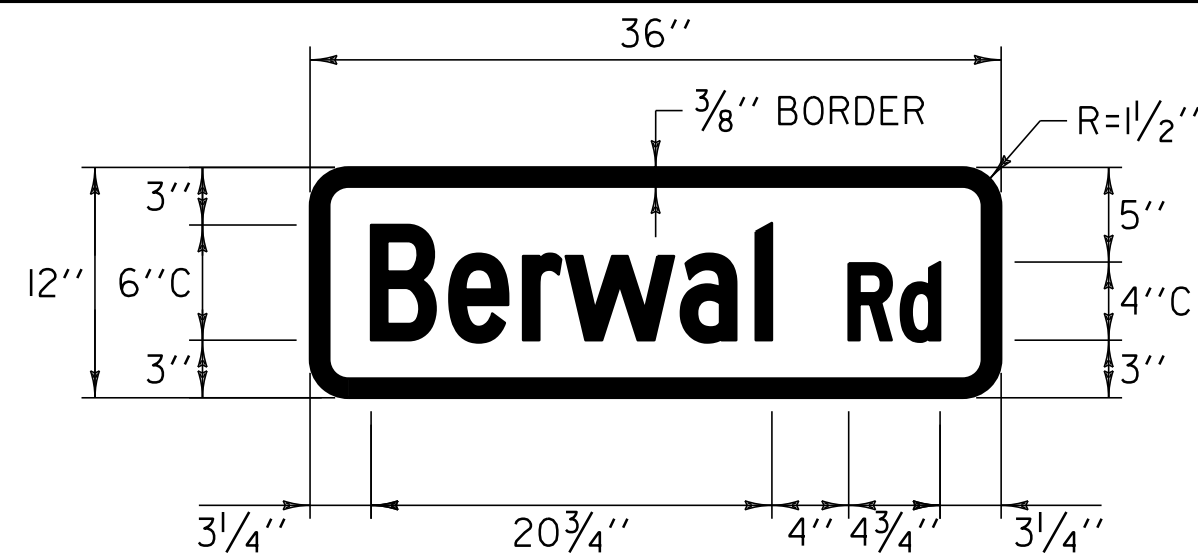

COLOR: WHITE BORDER & TEXT (REFLECTORIZED)  
GREEN BACKGROUND (REFLECTORIZED)

MATERIAL: PER VAOT STANDARD E-123


LOCATION: VT. ROUTE 313  
ARLINGTON:  
STA 163+49.0, LT

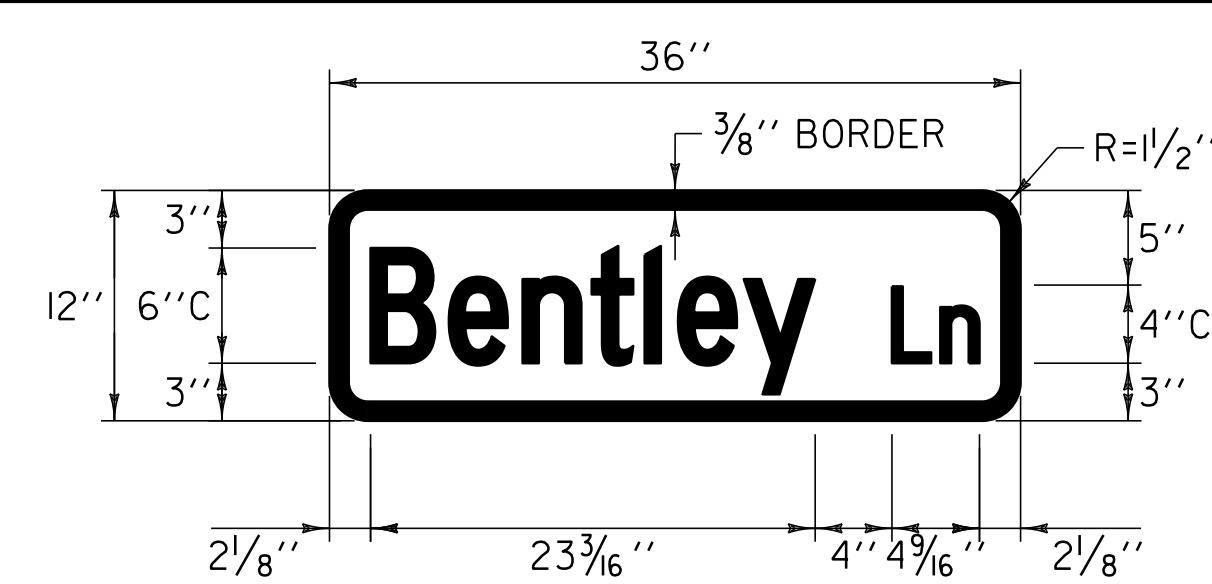

COLOR: WHITE BORDER & TEXT (REFLECTORIZED)  
GREEN BACKGROUND (REFLECTORIZED)

MATERIAL: PER VAOT STANDARD E-123


LOCATION: VT. ROUTE 313  
ARLINGTON:  
STA 329+41.0, LT

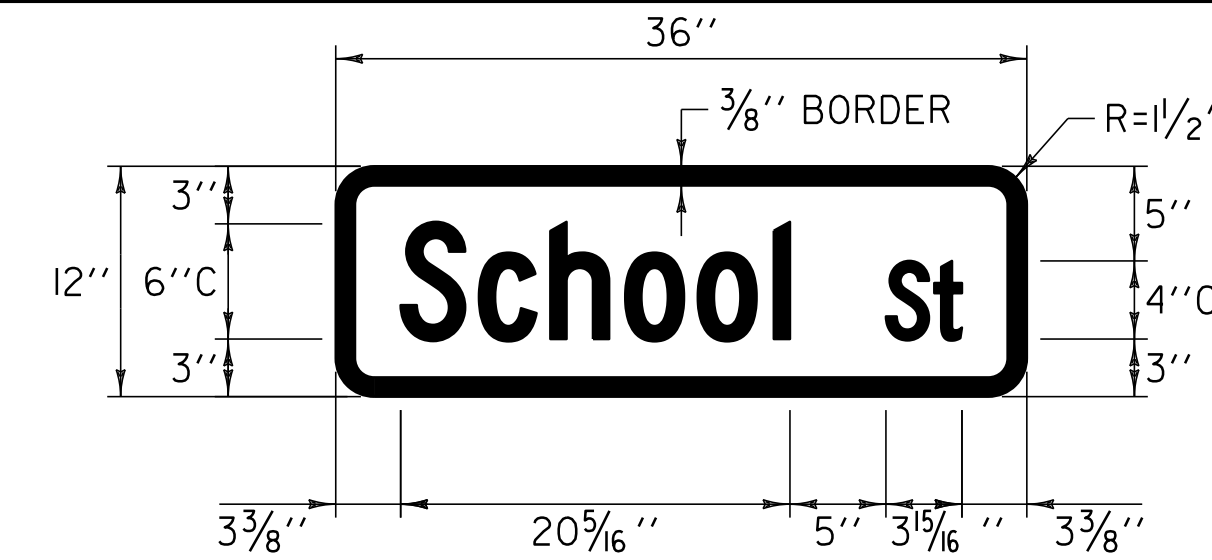

COLOR: WHITE BORDER & TEXT (REFLECTORIZED)  
GREEN BACKGROUND (REFLECTORIZED)

MATERIAL: PER VAOT STANDARD E-123


LOCATION: VT. ROUTE 313  
ARLINGTON:  
STA 347+78.0, RT

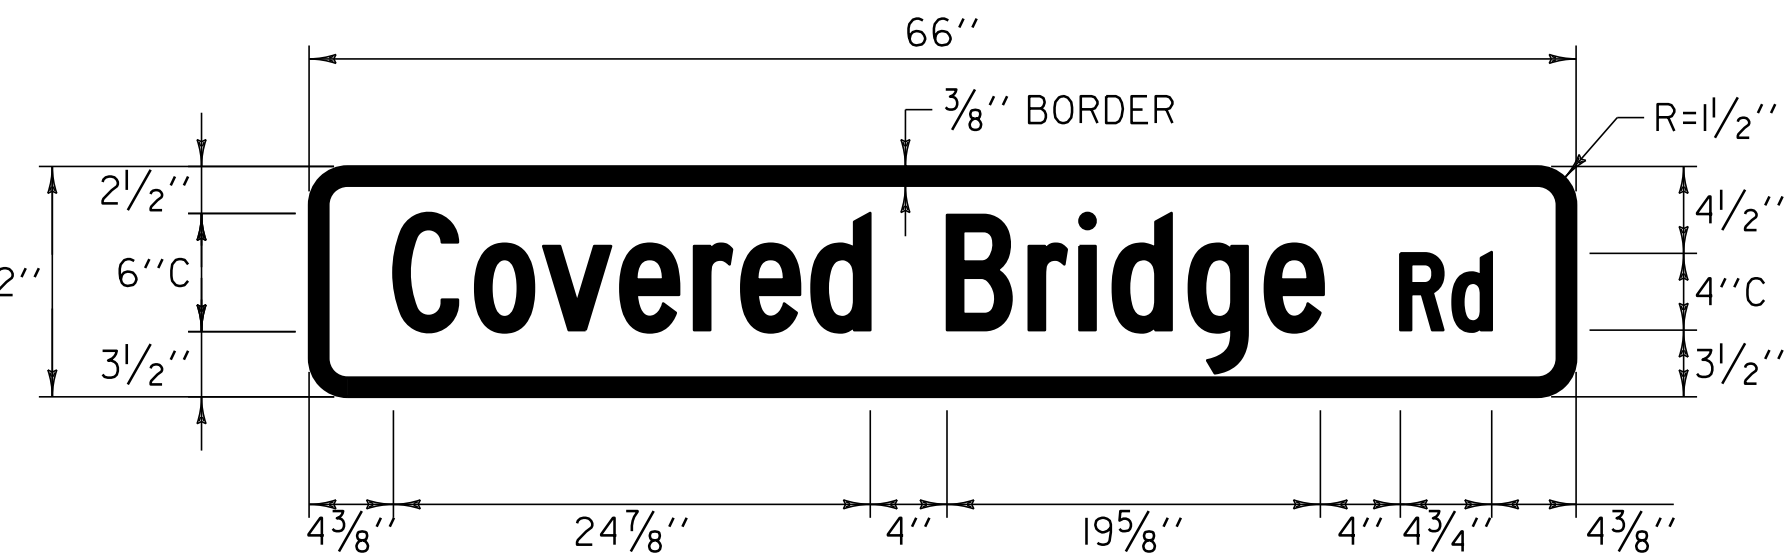

COLOR: WHITE BORDER & TEXT (REFLECTORIZED)  
GREEN BACKGROUND (REFLECTORIZED)

MATERIAL: PER VAOT STANDARD E-123


LOCATION: VT. ROUTE 313  
ARLINGTON:  
STA 127+75.0, RT

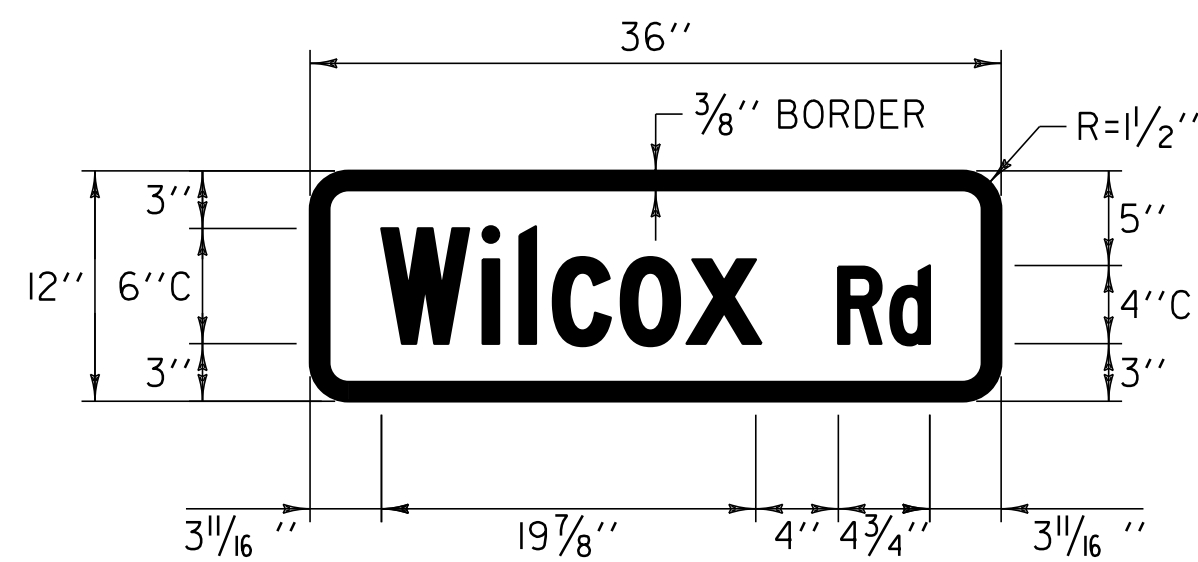

COLOR: WHITE BORDER & TEXT (REFLECTORIZED)  
GREEN BACKGROUND (REFLECTORIZED)

MATERIAL: PER VAOT STANDARD E-123


LOCATION: VT. ROUTE 313  
ARLINGTON:  
STA 183+47.0, LT

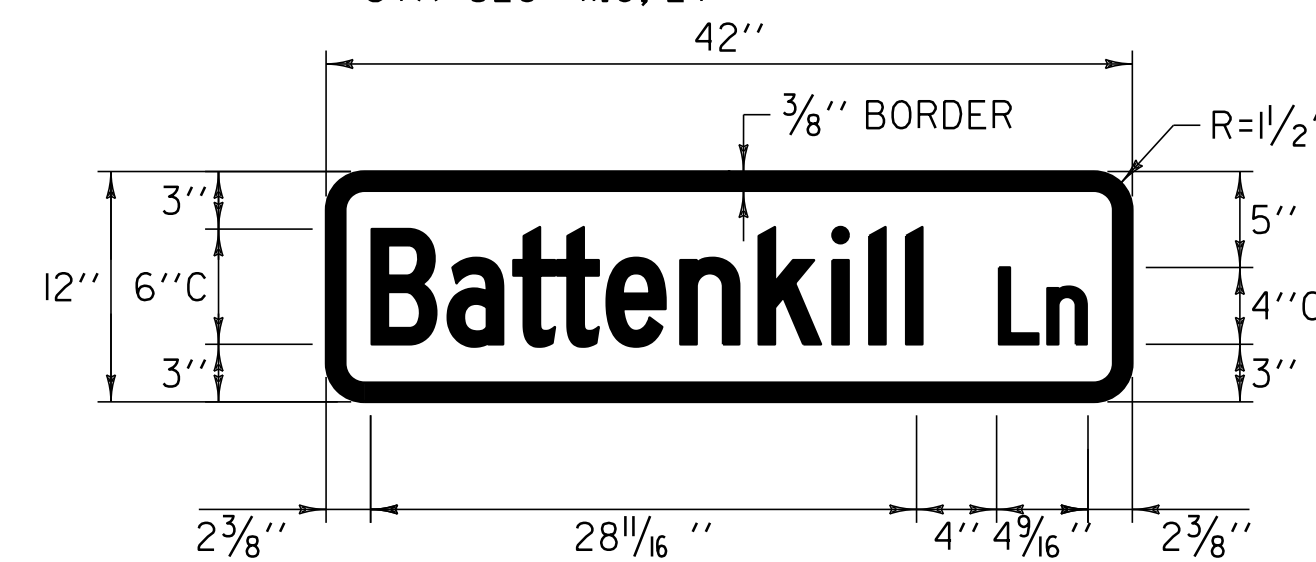

COLOR: WHITE BORDER & TEXT (REFLECTORIZED)  
GREEN BACKGROUND (REFLECTORIZED)

MATERIAL: PER VAOT STANDARD E-123


LOCATION: VT. ROUTE 313  
ARLINGTON:  
STA 330+33.0, RT

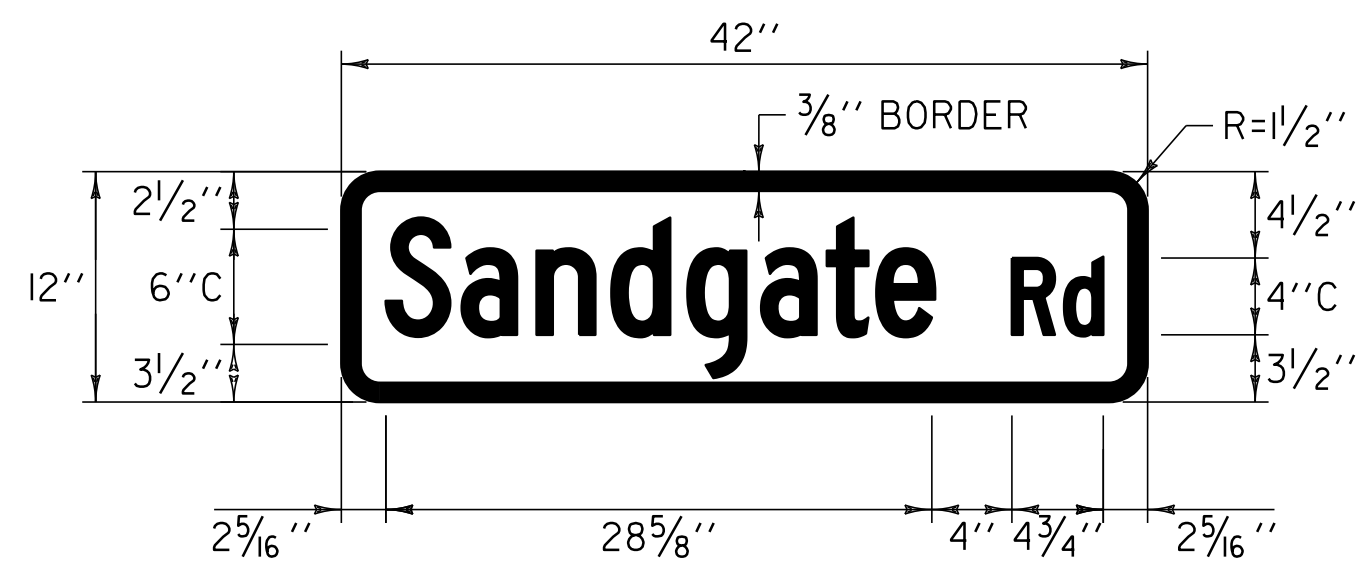

COLOR: WHITE BORDER & TEXT (REFLECTORIZED)  
GREEN BACKGROUND (REFLECTORIZED)

MATERIAL: PER VAOT STANDARD E-123


LOCATION: VT. ROUTE 313  
ARLINGTON:  
STA 148+82.0, LT

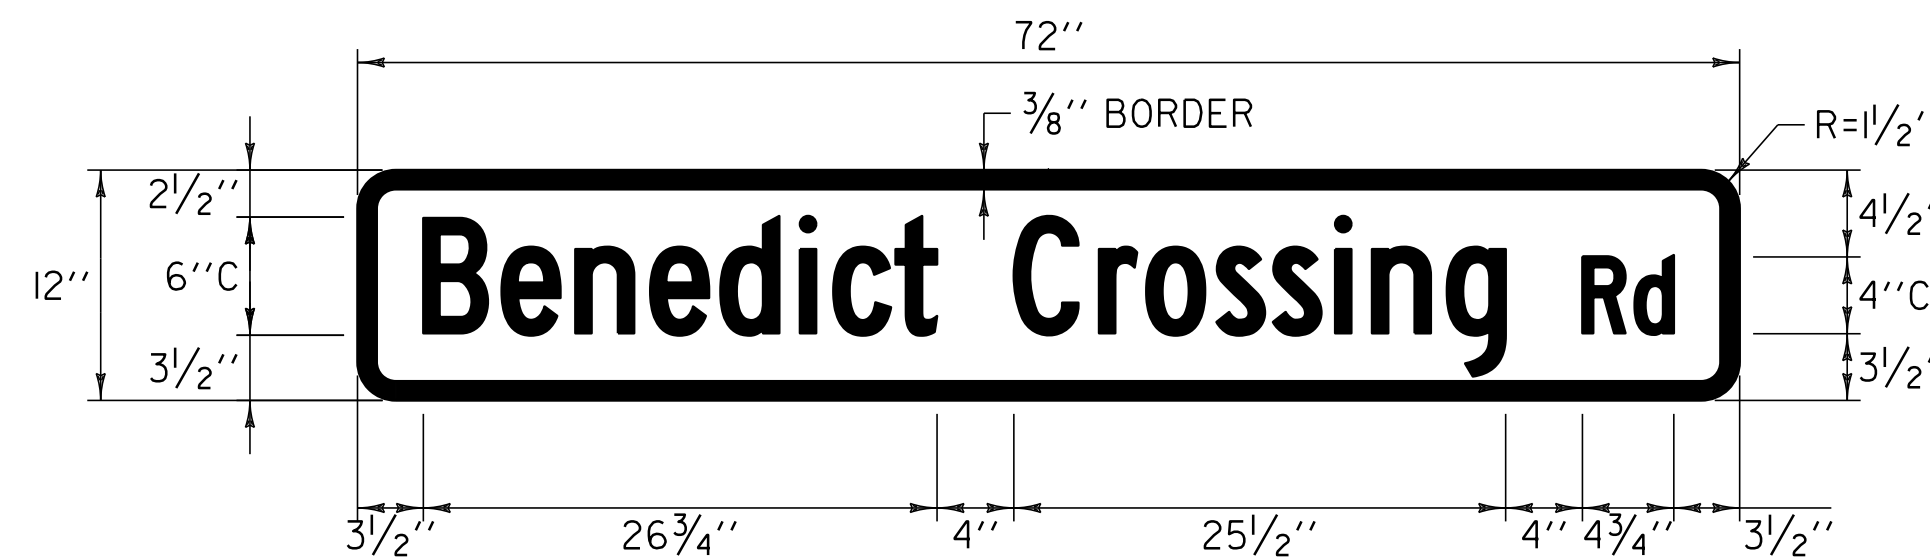

COLOR: WHITE BORDER & TEXT (REFLECTORIZED)  
GREEN BACKGROUND (REFLECTORIZED)

MATERIAL: PER VAOT STANDARD E-123


LOCATION: VT. ROUTE 313  
ARLINGTON:  
STA 209+01.0, RT

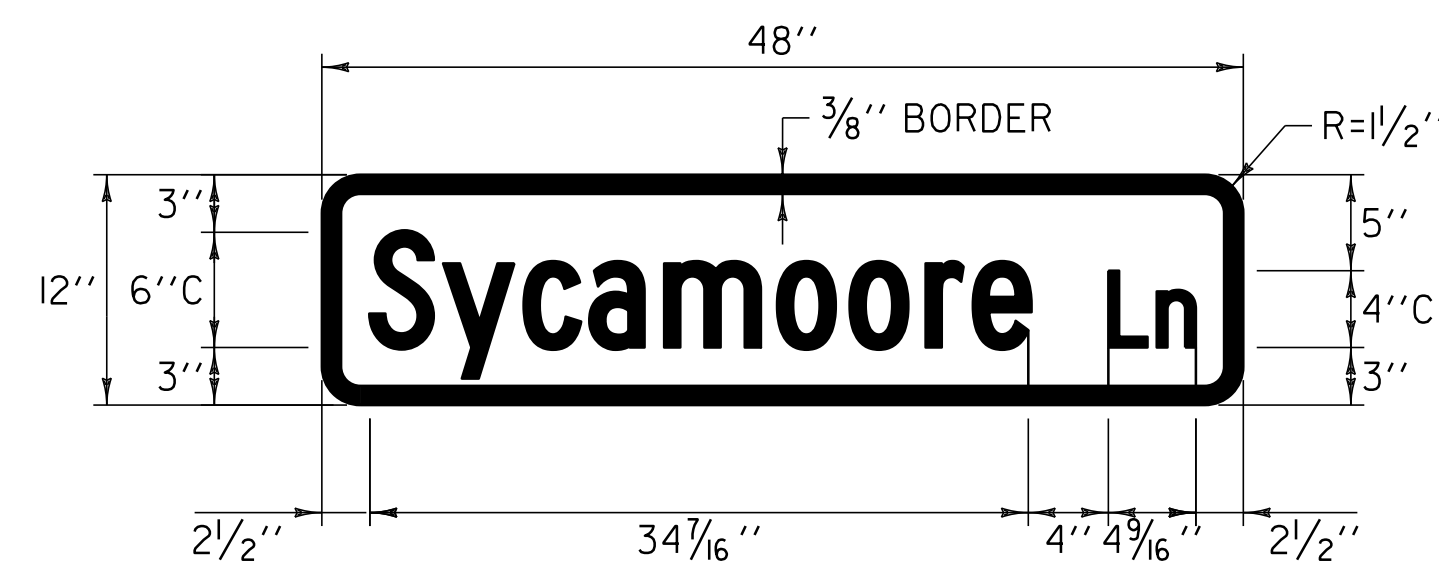

COLOR: WHITE BORDER & TEXT (REFLECTORIZED)  
GREEN BACKGROUND (REFLECTORIZED)

MATERIAL: PER VAOT STANDARD E-123


LOCATION: VT. ROUTE 313  
ARLINGTON:  
STA 157+32.0, LT

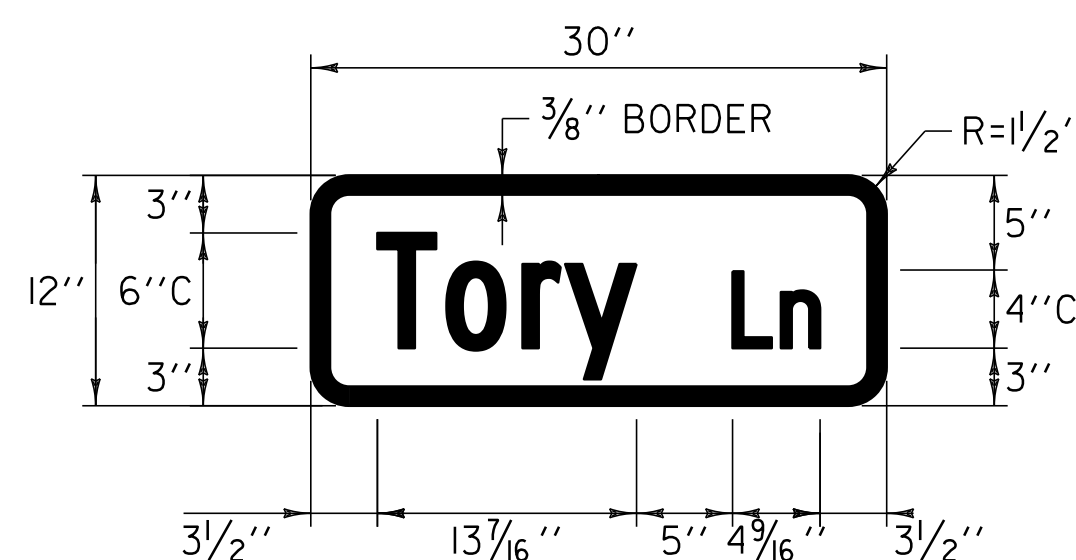

COLOR: WHITE BORDER & TEXT (REFLECTORIZED)  
GREEN BACKGROUND (REFLECTORIZED)

MATERIAL: PER VAOT STANDARD E-123

LOCATION: VT. ROUTE 313  
ARLINGTON:  
STA 325+64.0, LT

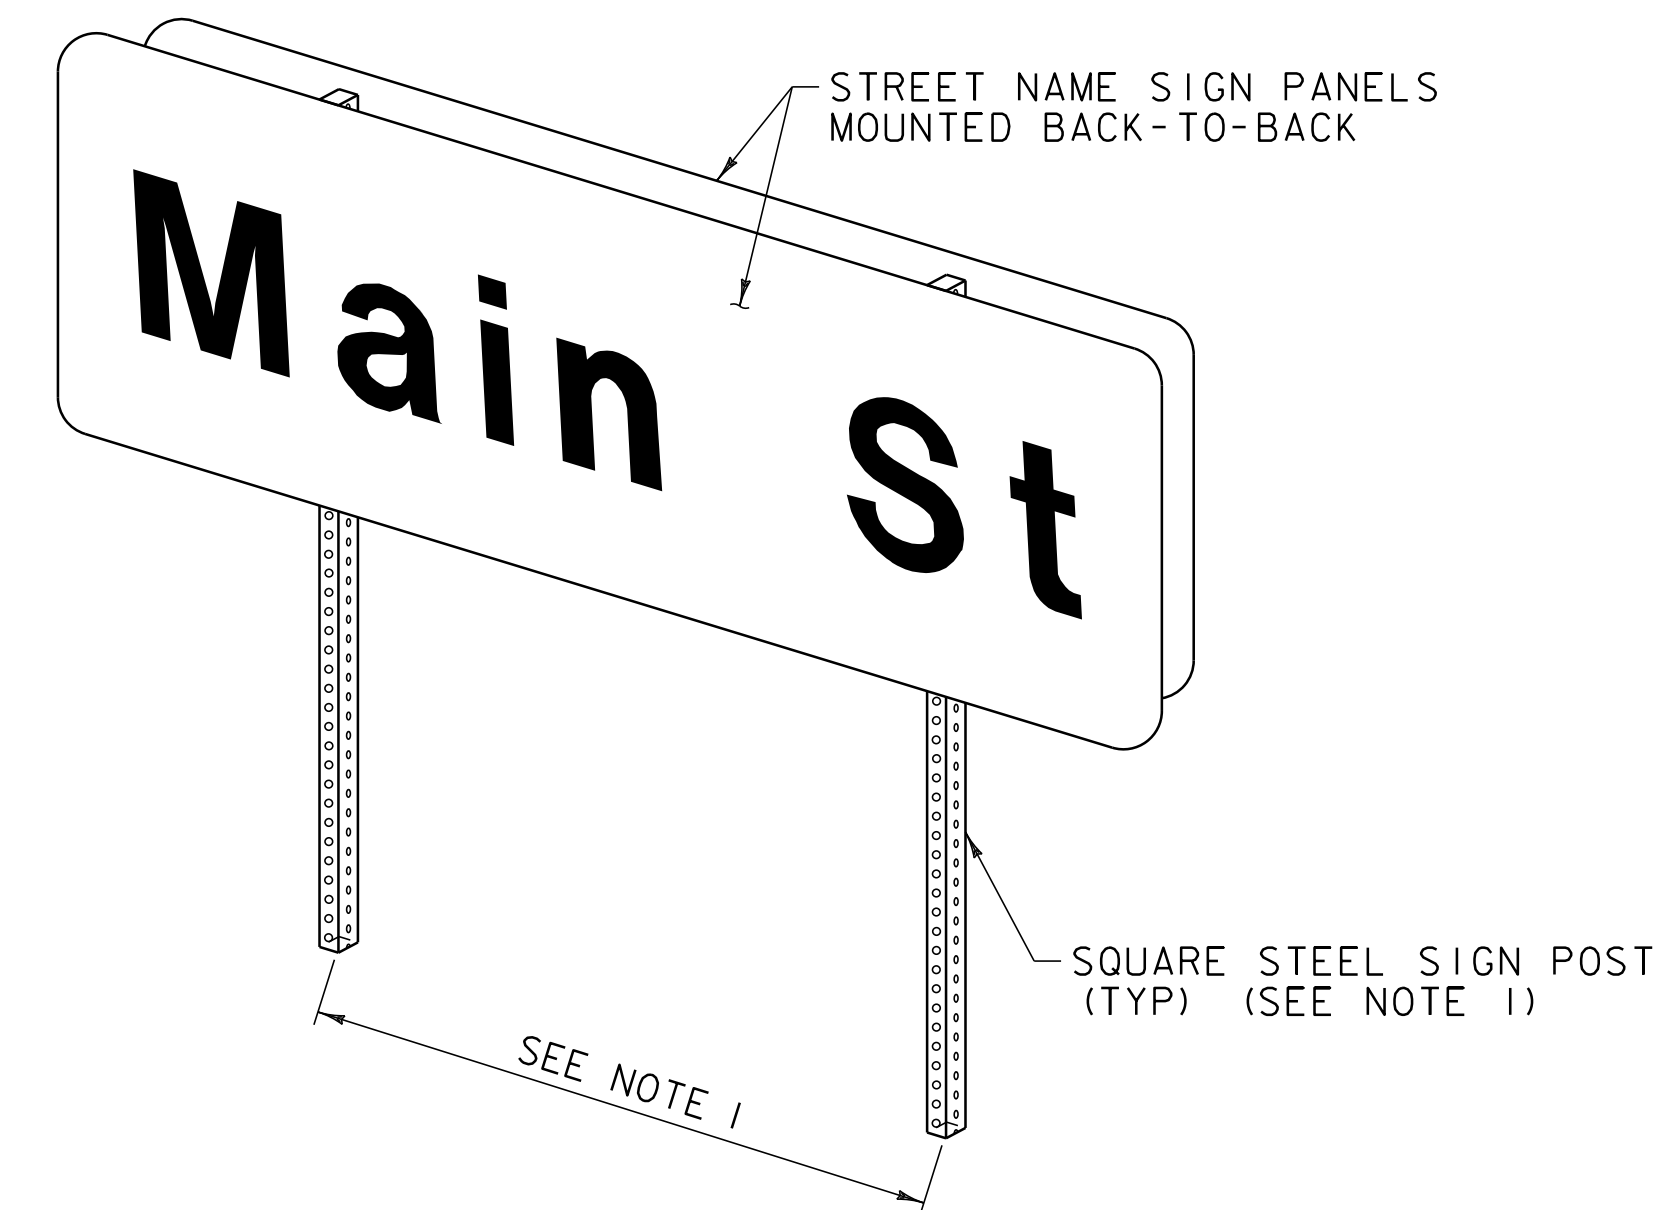

**TWO POST STREET NAME SIGN INSTALLATION FOR STREET NAME > 48"**

NOTE:

1. SEE VAOT STD E-164 FOR SQUARE STEEL SIGN POST DETAILS & POST SPACING REQUIREMENTS.

NOT TO SCALE

**TRAFFIC SIGN DETAILS SHEET #2**

PROJECT NAME: ARLINGTON	PLOT DATE: 20-FEB-2013 16:41
PROJECT NUMBER: STP 2334(1)	DRAWN BY: C.A.K.
FILE NAME: OIC042.dgn	CHECKED BY: D.W.E.
PROJECT LEADER: D.E.G.	SHEET 51 OF 143
DESIGNED BY: M.J.M.	
IPARM FILE: pOlc042tsd.i	

ALL SIGNS SIZES WERE INSTALLED PER PLAN. SEE LAYOUT SHEETS FOR LOCATIONS