



**COLD PLANE TYPICAL SECTION**

HISTORIC VT. ROUTE 7A ARLINGTON STA 185+85.60 TO ARLINGTON STA 206+00.00 ✓

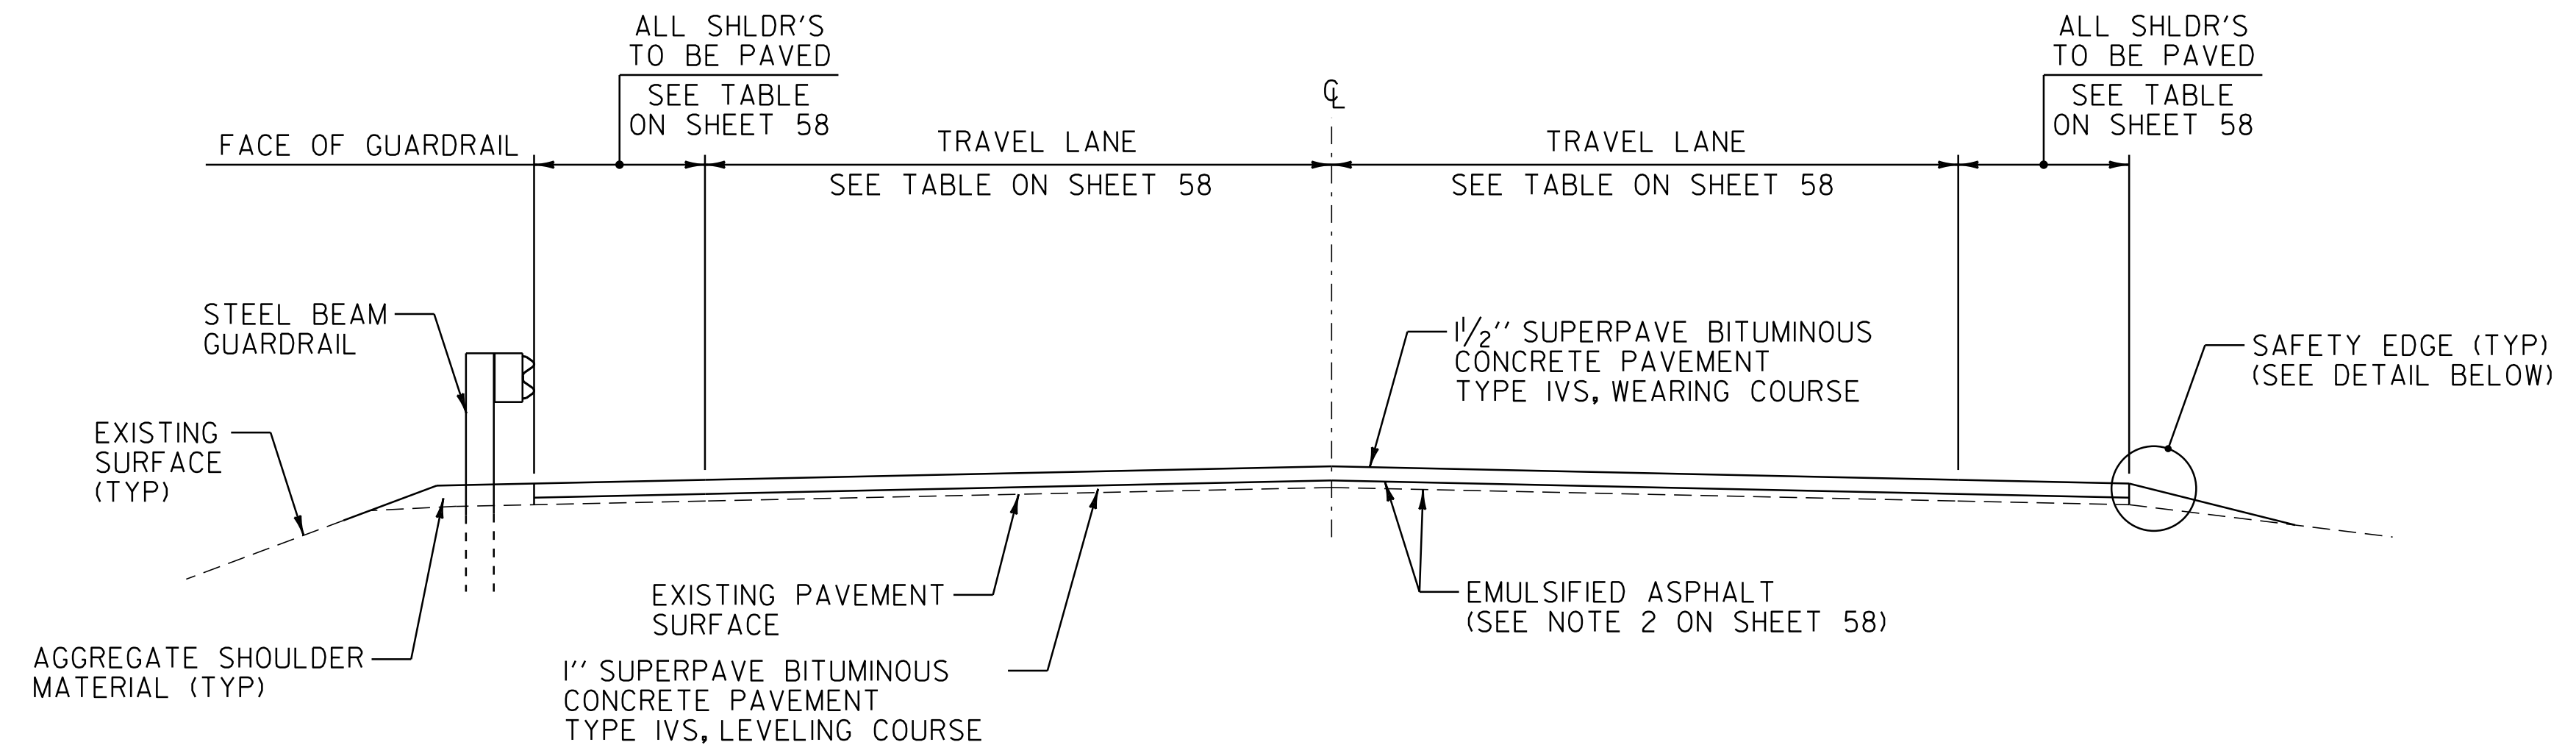

**LEVEL & OVERLAY TYPICAL SECTION**

HISTORIC VT. ROUTE 7A SUNDERLAND STA 74+18.40 TO SUNDERLAND STA 111+72.48 ✓  
 HISTORIC VT. ROUTE 7A MANCHESTER STA 0+00.00 TO MANCHESTER STA 60+98.40 ✓  
 HISTORIC VT. ROUTE 7A MANCHESTER STA 392+56.80 TO MANCHESTER STA 426+25.44 ✓  
 HISTORIC VT. ROUTE 7A DORSET STA 0+00.00 TO DORSET STA 38+50.50 ✓  
 HISTORIC VT. ROUTE 7A DORSET STA 39+16.50 TO DORSET STA 63+22.00 ✓  
 HISTORIC VT. ROUTE 7A DORSET STA 63+96.50 TO DORSET STA 79+20.00 ✓

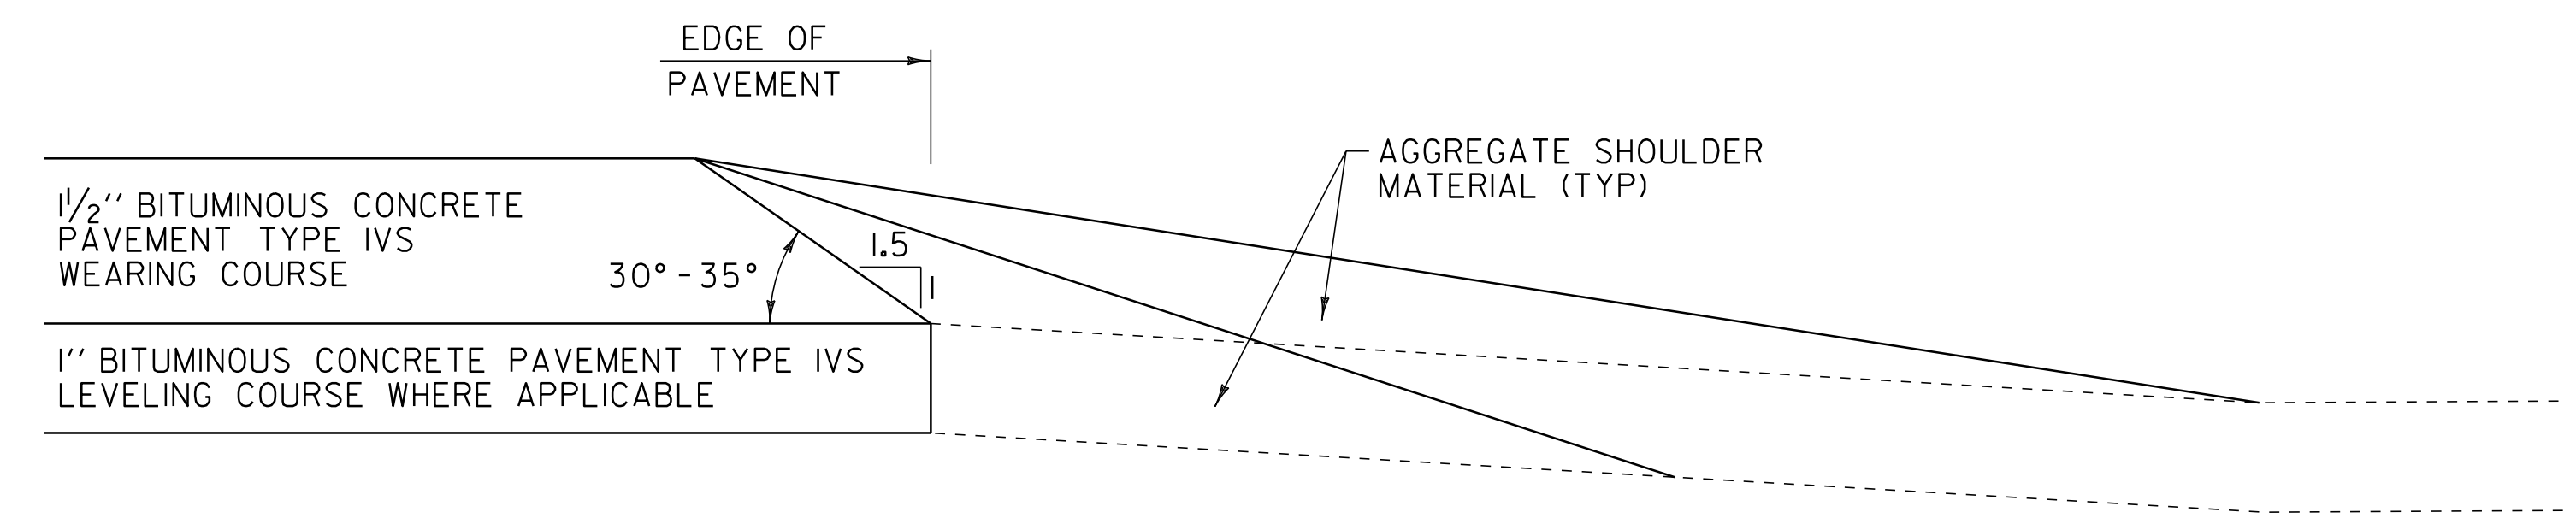

**SAFETY EDGE DETAIL**

NOT TO SCALE

<b>PROJECT TYPICAL SHEET #2</b>	PROJECT NAME: ARLINGTON-DORSET	
	PROJECT NUMBER: STP 2625(1)	
	FILE NAME: p06c218.dgn	PLOT DATE: \$DATE\$
	PROJECT LEADER: D.E.G.	DRAWN BY: C.A.K.
	DESIGNED BY: D.W.E.	CHECKED BY: M.J.L.
	IPARM FILE: p06c218+typ2.i	SHEET 59 OF 143