


**BEGIN PROJECT  
LOCATION TIES  
ARLINGTON  
HISTORIC VT. ROUTE 7A**

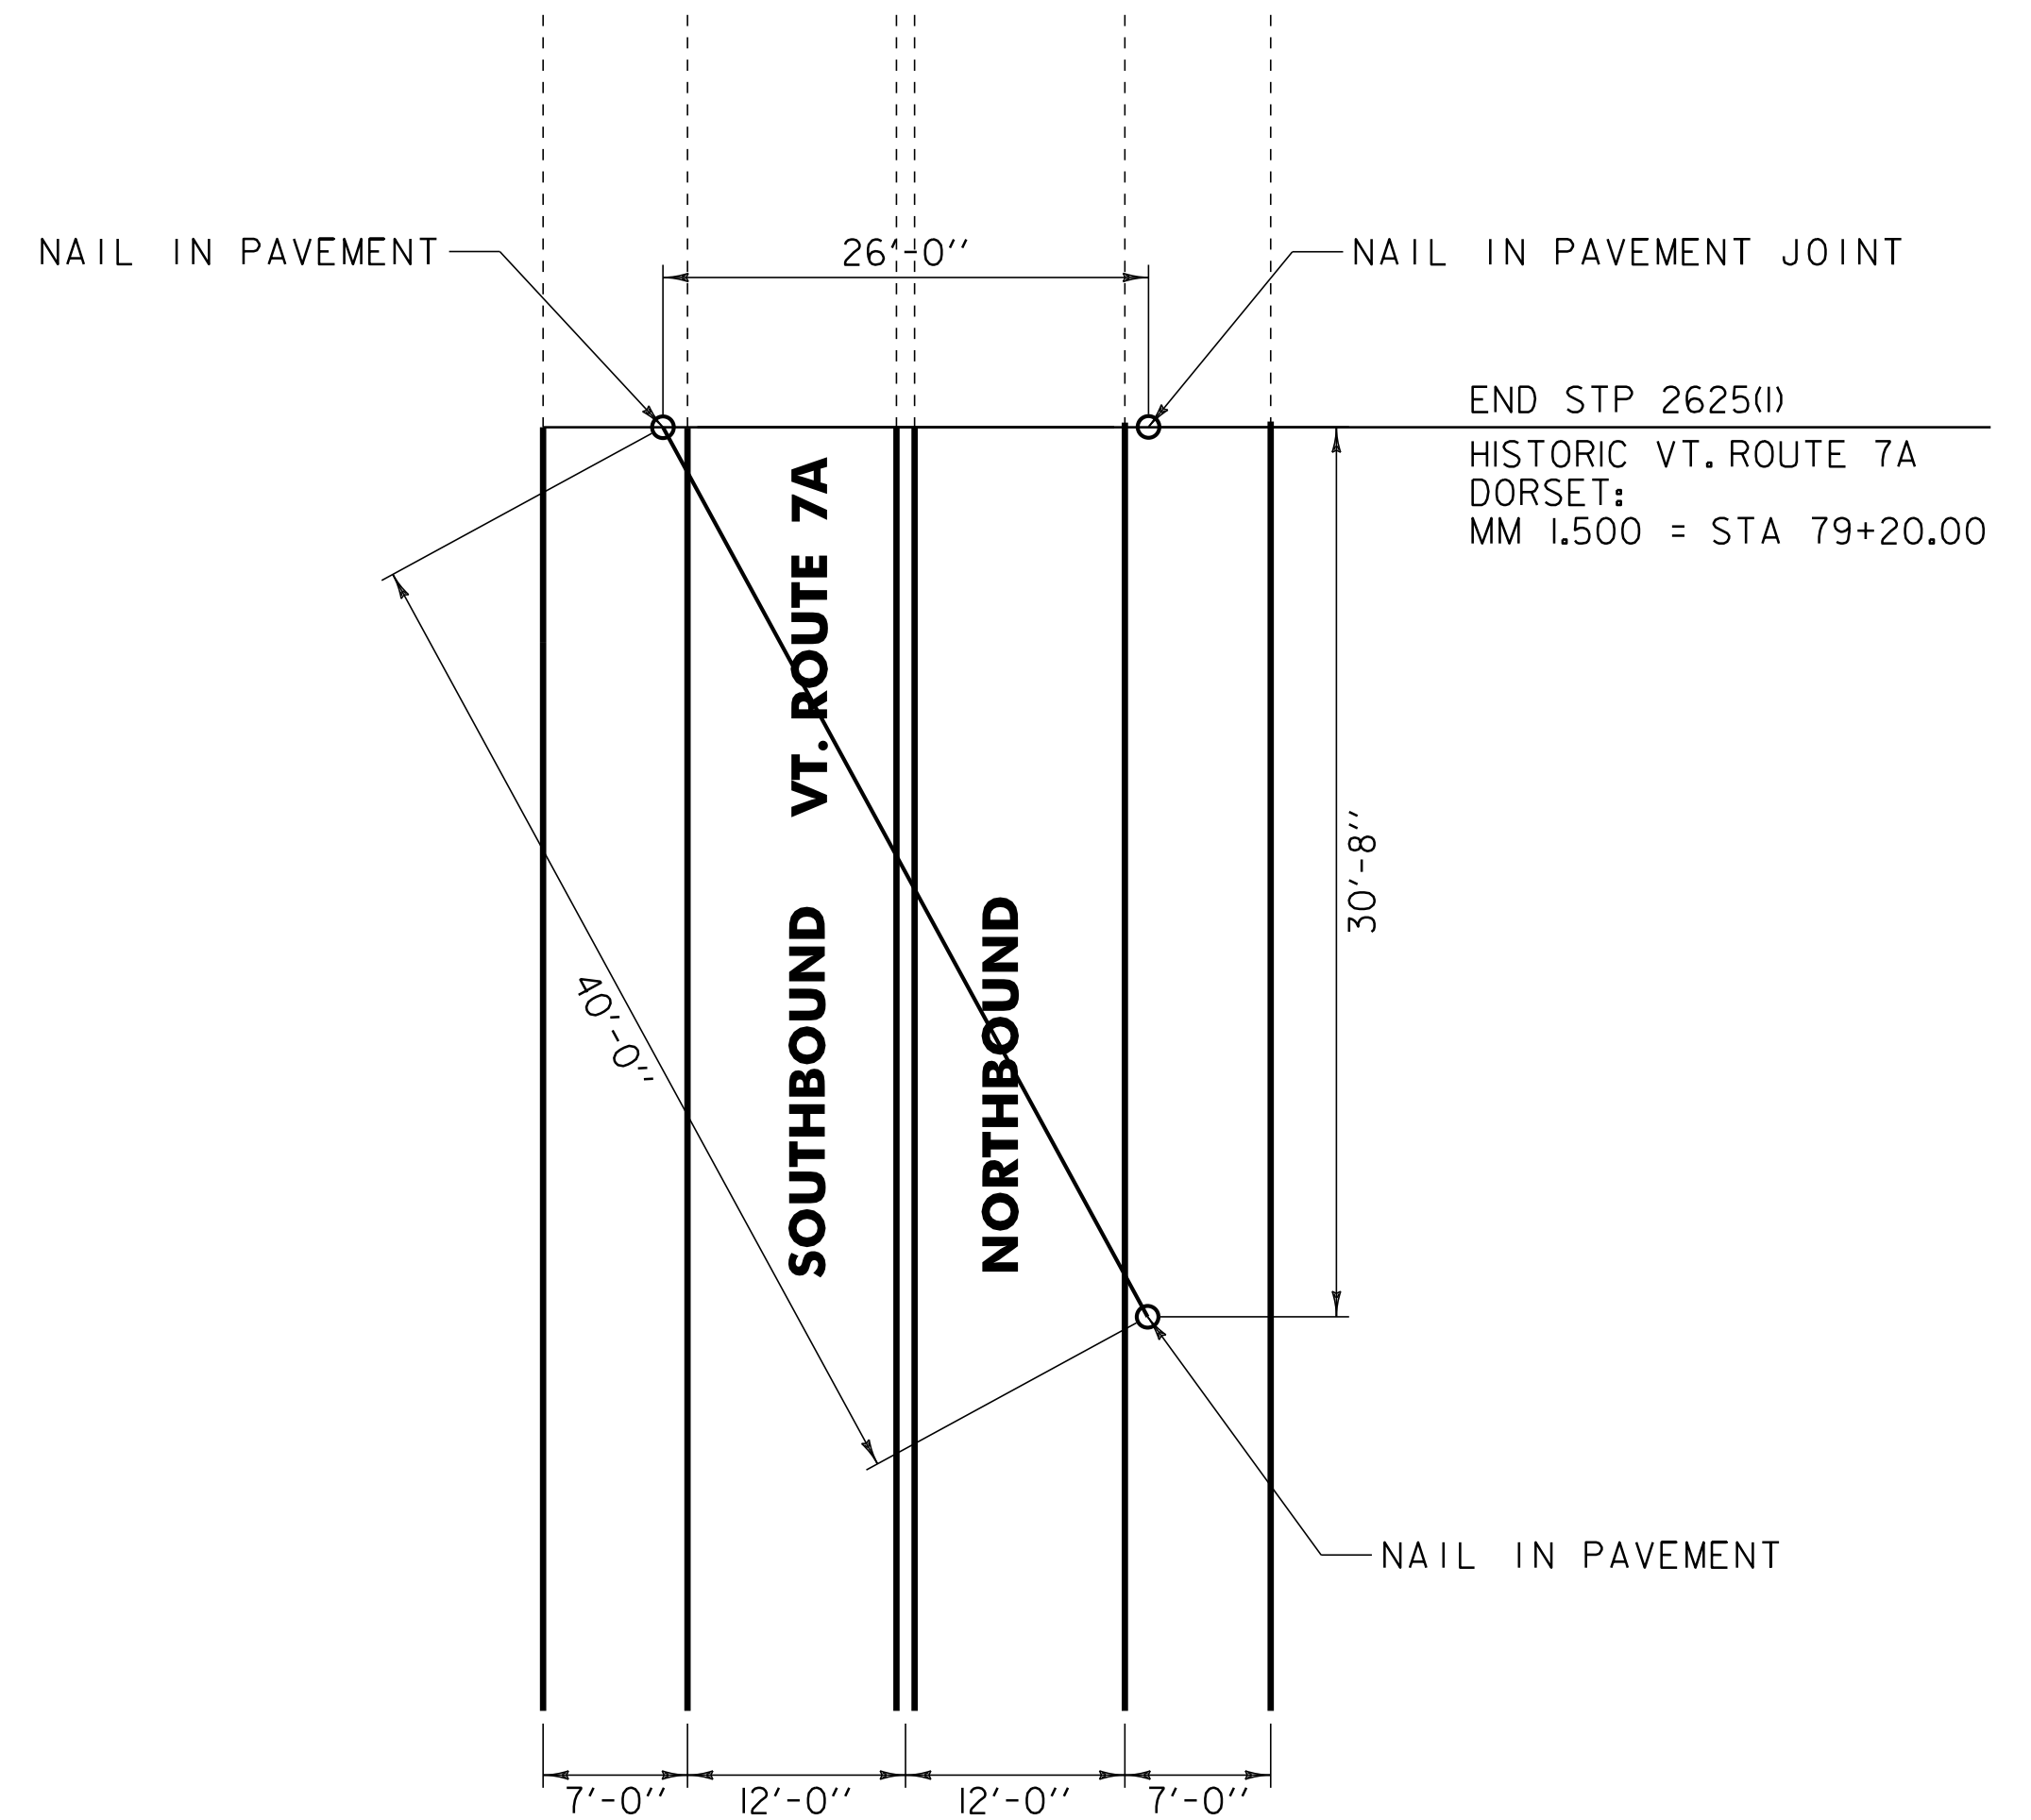

**END PROJECT  
LOCATION TIES  
DORSET  
HISTORIC VT. ROUTE 7A**

TIES NOT FOUND

NOT TO SCALE

<b>PROJECT TIE SHEET</b>	PROJECT NAME: ARLINGTON-DORSET	
	PROJECT NUMBER: STP 2625(I)	
	FILE NAME: p06c218.dgn	PLOT DATE: \$DATE\$
	PROJECT LEADER: D.E.G.	DRAWN BY: C.A.K.
DESIGNED BY: D.W.E.	CHECKED BY: M.J.L.	
IPARM FILE: p06c218+tie.i	SHEET 68 OF 143	