


646.406 DURABLE 4 INCH WHITE LINE, RECESSED POLYUREA
(ALL LINES WILL INCLUDE EDGE LINE BREAKS AND RADIUS FOR TOWN HIGHWAYS)
ARLINGTON:
STA 241+00.00 - STA 255+00.00 EDGE LINE LT & RT

646.416 DURABLE 4 INCH YELLOW LINE, RECESSED POLYUREA
(ALL LINES WILL INCLUDE C/L BREAKS FOR TOWN HIGHWAYS) S=SOLID, D=DASHED
ARLINGTON:
STA 241+00.00 - STA 255+00.00 LT ☉ RT
STA 251+27.52 DOUBLE SOLID RT, TH-15

646.481 DURABLE 24 INCH STOP BAR, TYPE ITAPE
ARLINGTON:
STA 251+27.52 RT, TH-15

646.491 DURABLE LETTER OR SYMBOL, TYPE ITAPE
ARLINGTON:
STA 251+27.52 RT, TH-15 "S,T,O,P" (4 EA)

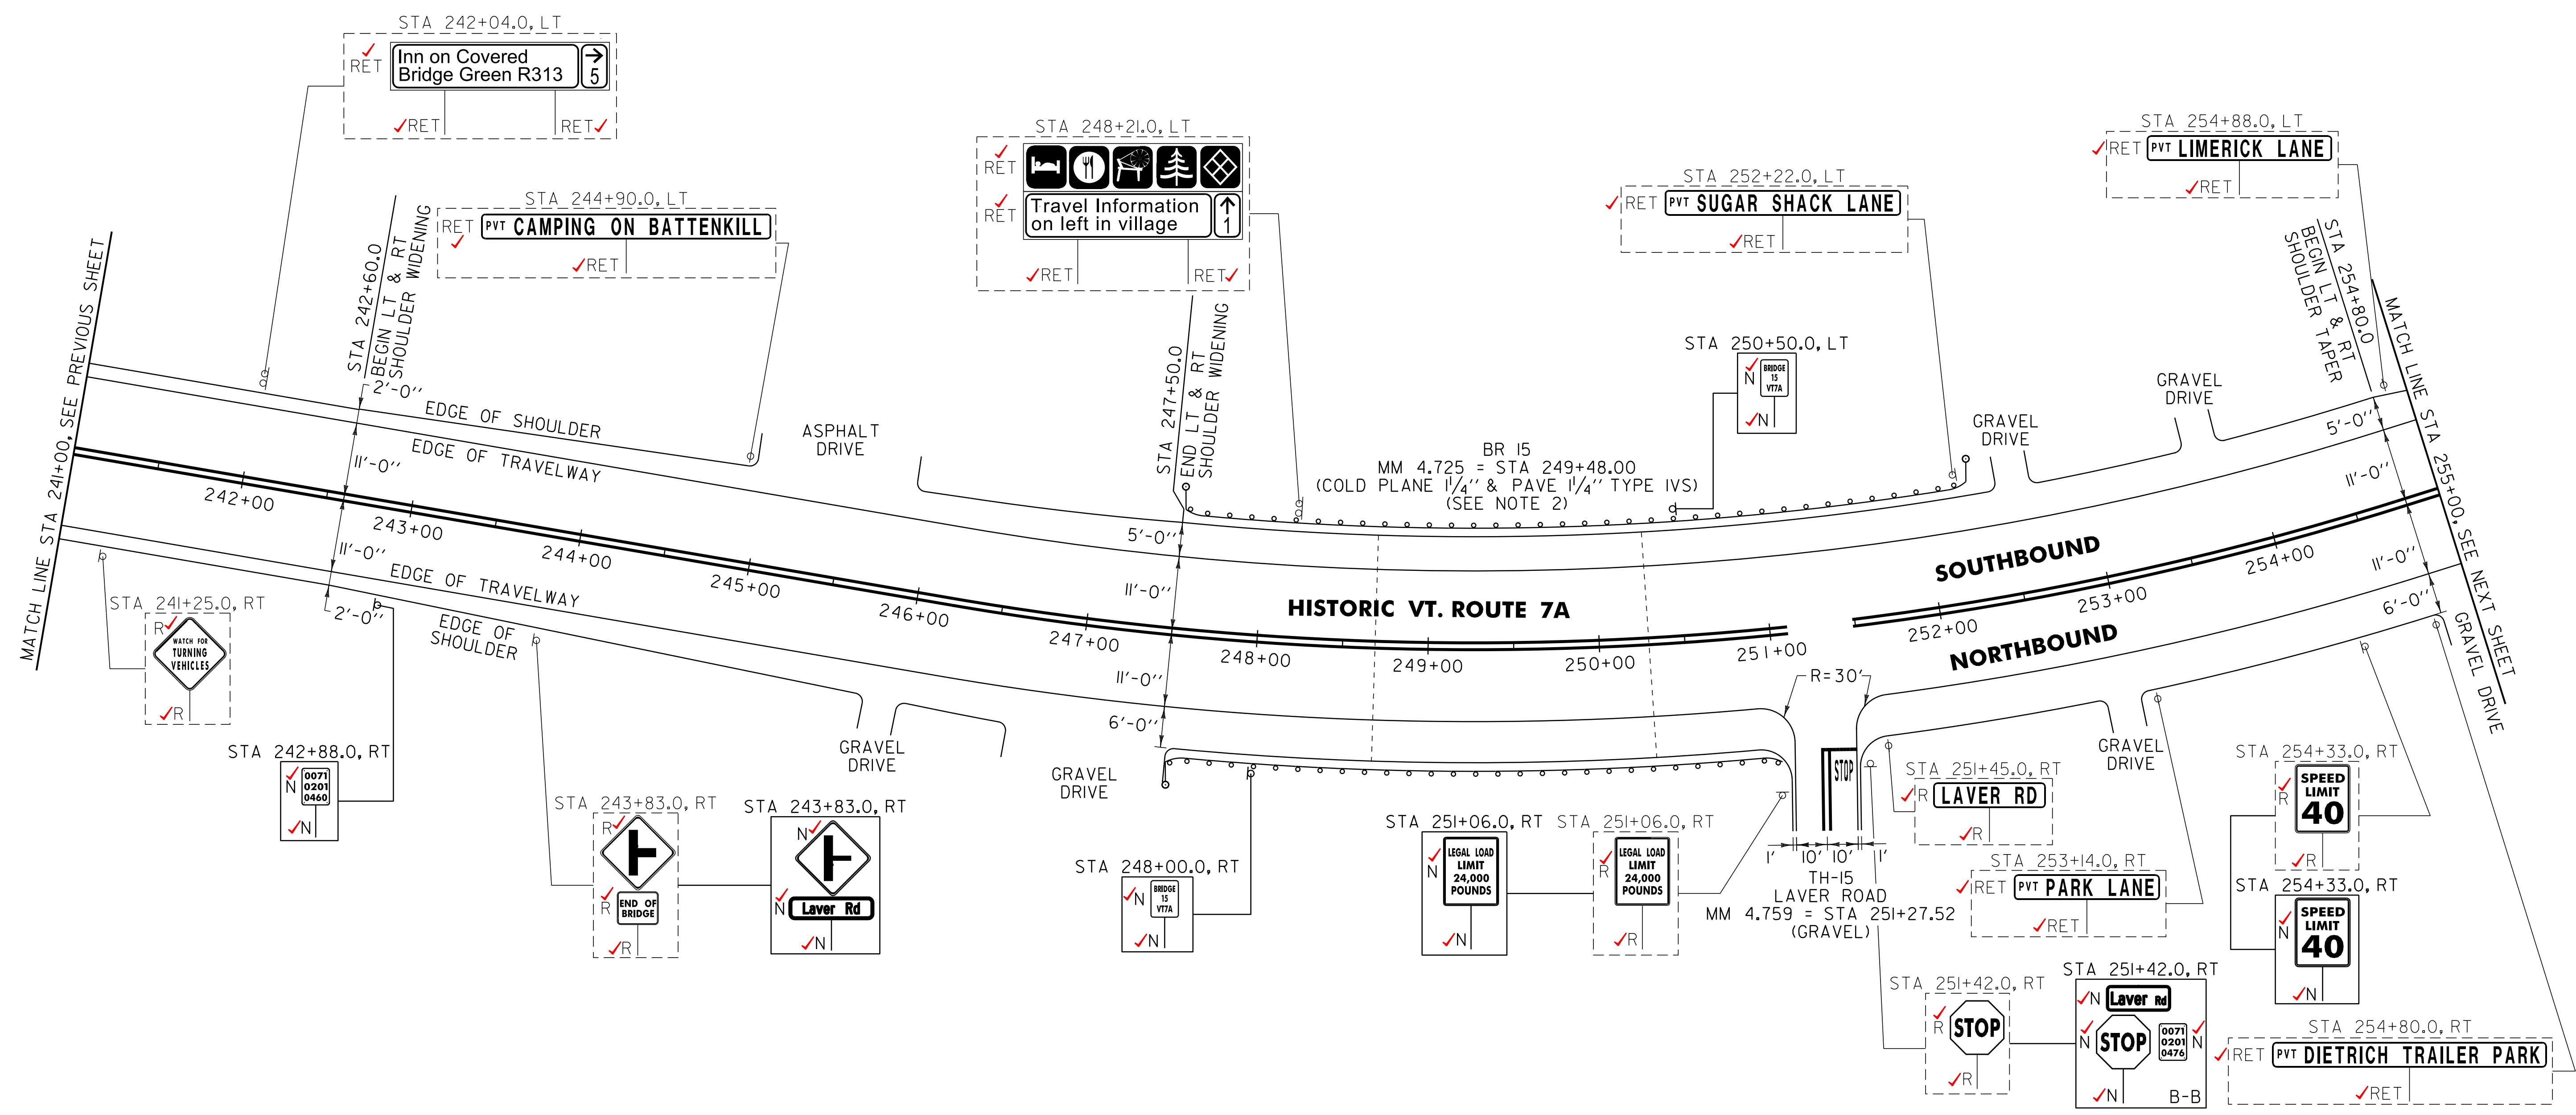

621.70 GUARDRAIL APPROACH SECTION, GALVANIZED TYPE I
ARLINGTON:
STA 248+01.0 ✓ - STA 248+51.0 ✓ LT ✓
STA 248+03.0 ✓ - STA 248+53.0 ✓ RT ✓
STA 250+46.0 ✓ - STA 250+96.0 ✓ RT ✓
STA 250+48.0 ✓ - STA 250+98.0 ✓ LT ✓

621.80 REMOVAL AND DISPOSAL OF GUARDRAIL
ARLINGTON:
STA 247+53.0 ✓ - STA 248+53.0 ✓ RT ✓ (100.0 LF) ✓
STA 247+88.0 ✓ - STA 248+51.0 ✓ LT ✓ (63.0 LF) ✓
STA 250+46.0 ✓ - STA 251+04.0 ✓ RT ✓ (58.0 LF) ✓
STA 250+48.0 ✓ - STA 252+11.0 ✓ LT ✓ (163.0 LF) ✓

676.10 DELINEATOR WITH STEEL POST
ARLINGTON:
STA 247+51.0 LT
STA 247+53.0 RT
STA 252+10.5 LT

621.20 STEEL BEAM GUARDRAIL, GALVANIZED
ARLINGTON:
STA 247+88.5 ✓ - STA 248+01.0 ✓ LT ✓ (12.5 LF) ✓
STA 247+90.5 ✓ - STA 248+03.0 ✓ RT ✓ (12.5 LF) ✓
STA 250+96.0 ✓ - STA 251+04.0 ✓ RT ✓ (14.5 LF) ✓
STA 250+98.0 ✓ - STA 251+73.0 ✓ LT ✓ (75.0 LF) ✓ 06.0

621.50 MANUFACTURED TERMINAL SECTION, FLARED
ARLINGTON:
STA 247+51.0 ✓ - STA 247+88.5 ✓ LT ✓
STA 247+53.0 ✓ - STA 247+90.5 ✓ RT ✓
STA 251+73.0 ✓ - STA 252+10.5 ✓ LT ✓

621.60 ANCHOR FOR STEEL BEAM RAIL
ARLINGTON:
STA 250+97.5 ✓ - STA 250+97.0

NOTES:
1. PAVING LIMIT ON ALL TOWN HIGHWAYS SHALL BE MEASURED 25 FT BACK FROM HISTORIC VT.ROUTE 7A EDGE OF SHOULDER UNLESS DENOTED OTHERWISE ON THE PLANS OR AS DIRECTED BY THE RESIDENT ENGINEER.
2. SEE SHEET 138 FOR BRIDGE 15 DETAILS.

SIGN LEGEND
R = REMOVE
S = SALVAGE
N = NEW
RET = RETAIN
B-B = BACK TO BACK
EXISTING = - - - - -
NEW = _____

NOT TO SCALE

PROJECT LAYOUT SHEET #8	PROJECT NAME: ARLINGTON-DORSET	FILE NAME: p06c218.dgn	PLOT DATE: \$DATE\$
	PROJECT NUMBER: STP 2625(1)	PROJECT LEADER: D.E.G.	DRAWN BY: C.A.K.
	DESIGNED BY: D.W.E.	CHECKED BY: M.J.L.	SHEET 76 OF 143
	IPARM FILE: p06c218108.1		