


646.406 DURABLE 4 INCH WHITE LINE, RECESSED POLYUREA
 (ALL LINES WILL INCLUDE EDGE LINE BREAKS AND
 RADIUS FOR TOWN HIGHWAYS)
 ARLINGTON:
 STA 297+50.00 - STA 312+50.00 EDGE LINE LT & RT

646.416 DURABLE 4 INCH YELLOW LINE, RECESSED POLYUREA
 (ALL LINES WILL INCLUDE C/L BREAKS FOR
 TOWN HIGHWAYS) S=SOLID, D=DASHED
 ARLINGTON:
 STA 297+50.00 - STA 312+50.00 LT ☐ RT
 S - S
 STA 306+29.28 DOUBLE SOLID LT, TH-19
 STA 311+36.16 DOUBLE SOLID LT, TH-18

646.481 DURABLE LETTER OR SYMBOL, TYPE ITAPE
 ARLINGTON:
 STA 306+29.28 LT, TH-19
 STA 311+36.16 LT, TH-18

646.491 DURABLE LETTER OR SYMBOL, TYPE ITAPE
 ARLINGTON:
 STA 306+29.28 LT, TH-19 "S,T,O,P" (4 EA)
 STA 311+36.16 LT, TH-18 "S,T,O,P" (4 EA)

675.50 REMOVING SIGNS
 AS SHOWN - #10 ✓

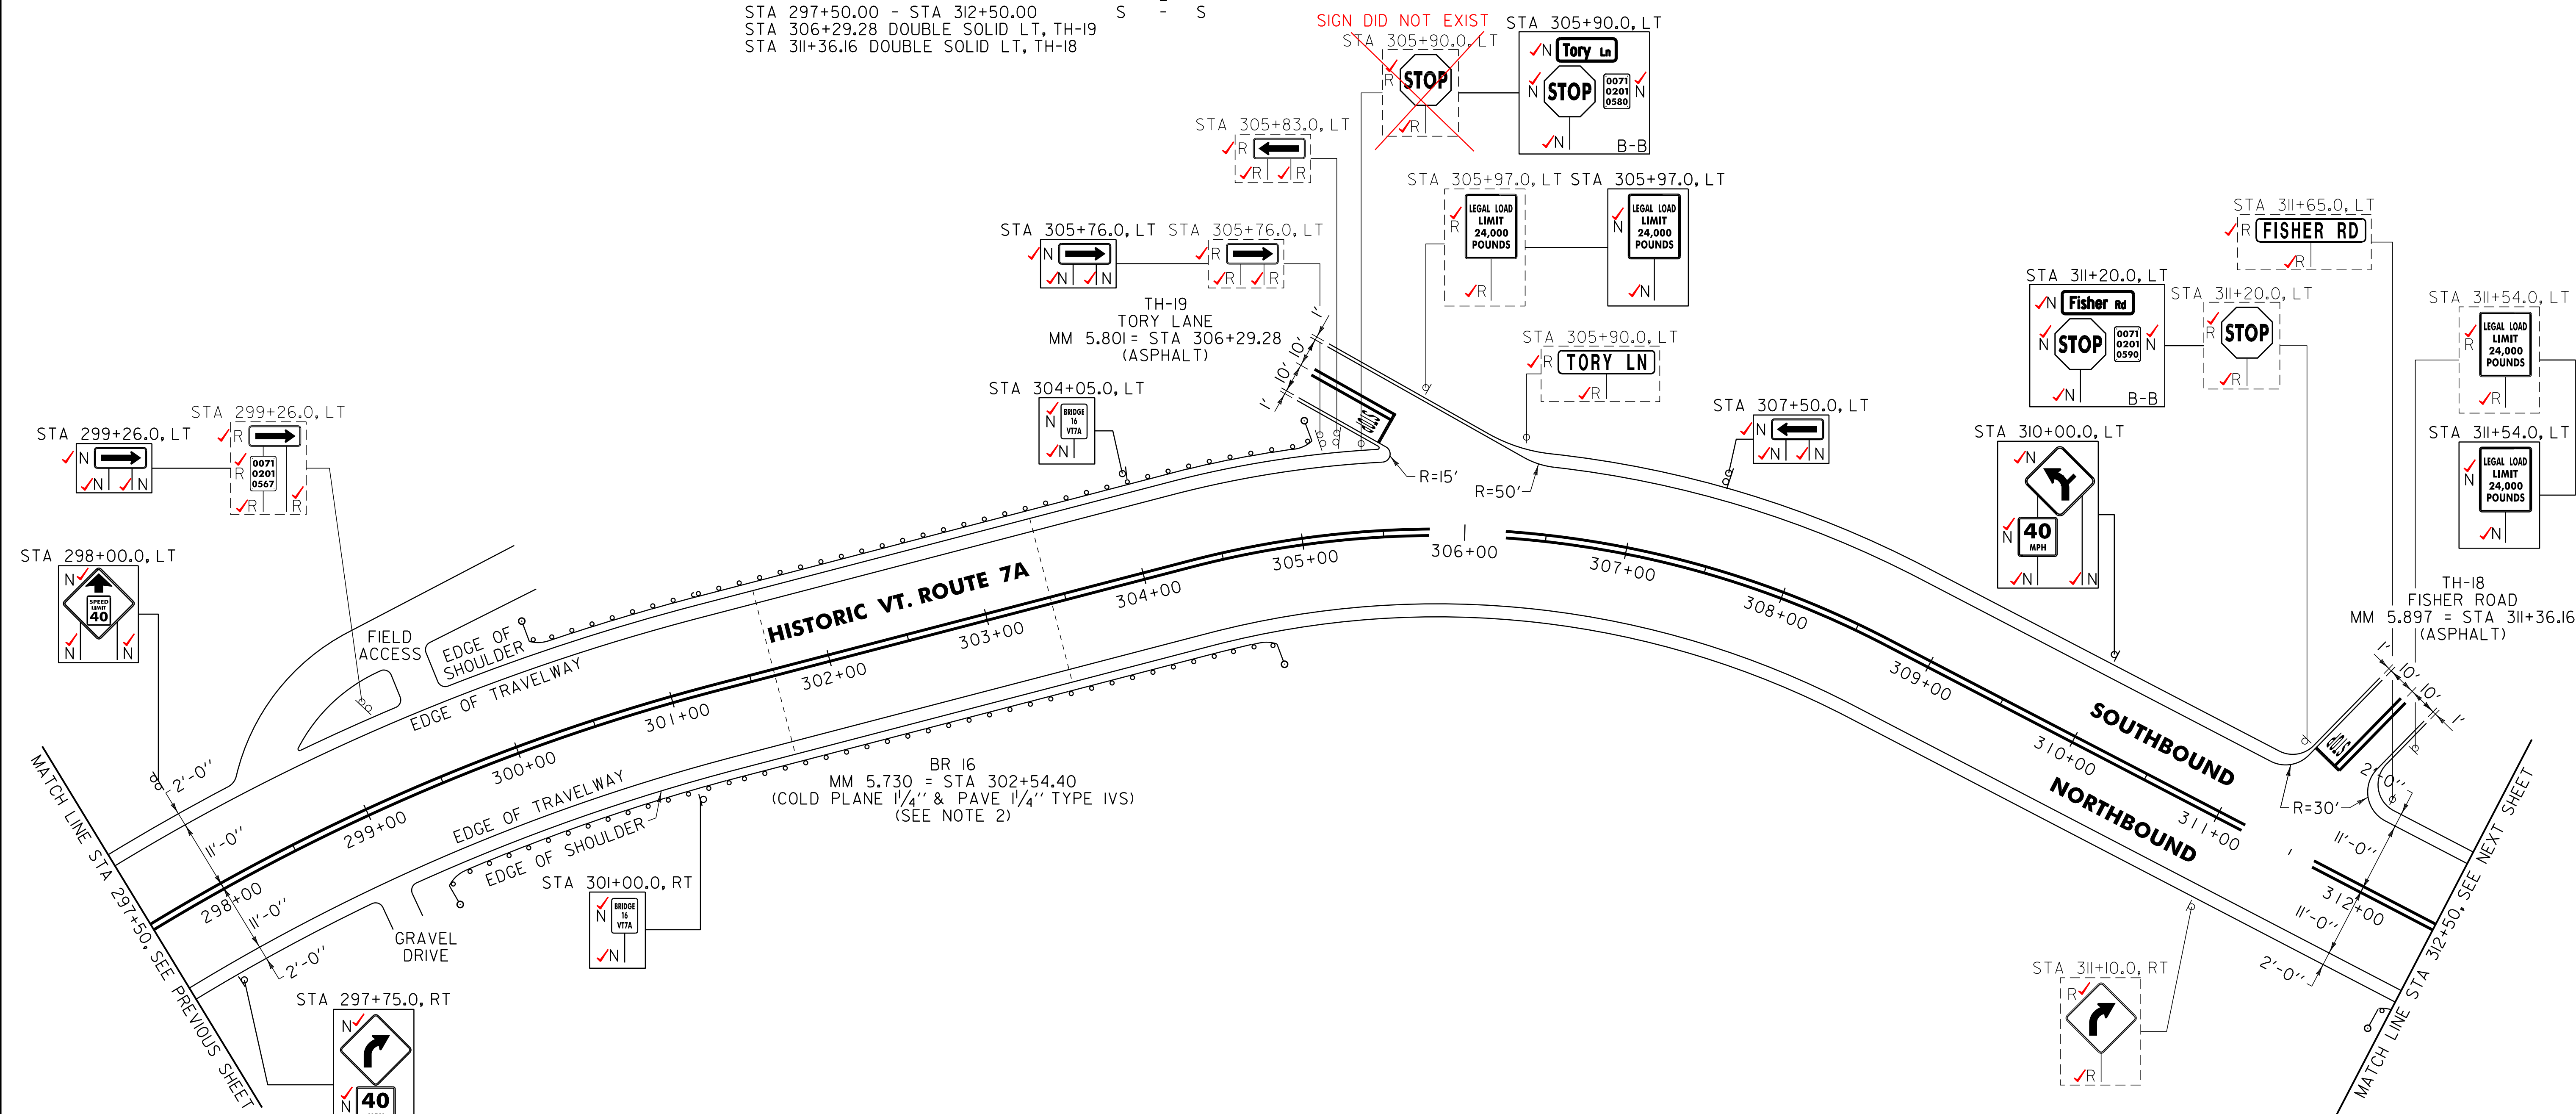

~~621.70 GUARDRAIL APPROACH SECTION, GALVANIZED TYPE I
 ARLINGTON:
 STA 301+15.0 - STA 301+65.0 LT
 STA 301+15.0 - STA 301+65.0 RT
 STA 303+41.0 - STA 303+91.0 RT
 STA 303+41.0 - STA 303+91.0 LT~~

~~621.80 REMOVAL AND DISPOSAL OF GUARDRAIL
 ARLINGTON:
 STA 300+71.0 - STA 301+65.0 LT (94.0 LF) ✓
 STA 300+76.0 - STA 301+65.0 RT (89.0 LF) ✓
 STA 303+41.0 - STA 305+13.0 LT (172.0 LF) ✓
 STA 303+41.0 - STA 304+64.0 RT (123.0 LF) ✓~~

676.10 DELINEATOR WITH STEEL POST
 ARLINGTON:
 STA 299+27.5 RT
 STA 300+27.5 LT
 STA 304+78.5 RT
 STA 305+16.0 LT
 STA 312+47.7 RT

621.30 BOX BEAM GUARDRAIL (ALTERNATE TREATMENT)
 ARLINGTON:
 STA 299+25.0 - STA 301+65.0 RT (241LF)
 STA 300+20.0 - STA 301+65.0 LT (145 LF)
 STA 301+41.0 - STA 302+86.0 RT (145 LF)
 STA 303+41.0 - STA 305+22.0 LT (181LF)

SIGN LEGEND
 R = REMOVE
 S = SALVAGE
 N = NEW
 RET = RETAIN
 B-B = BACK TO BACK
 EXISTING = - - - - -
 NEW = _____

NOTES:
 1. PAVING LIMIT ON ALL TOWN HIGHWAYS SHALL BE MEASURED 25 FT BACK FROM HISTORIC VT. ROUTE 7A EDGE OF SHOULDER UNLESS DENOTED OTHERWISE ON THE PLANS OR AS DIRECTED BY THE RESIDENT ENGINEER.
 2. SEE SHEET I39 FOR BRIDGE 16 DETAILS.

NOT TO SCALE

PROJECT LAYOUT SHEET #11	PROJECT NAME: ARLINGTON-DORSET	FILE NAME: p06c218.dgn	PLOT DATE: \$DATE\$
	PROJECT NUMBER: STP 2625(1)	PROJECT LEADER: D.E.G.	DRAWN BY: C.A.K.
		DESIGNED BY: D.W.E.	CHECKED BY: M.J.L.
		IPARM FILE: p06c218(1).i	SHEET 79 OF 143

~~621.20 STEEL BEAM GUARDRAIL, GALVANIZED
 ARLINGTON:
 STA 299+65.0 - STA 301+15.0 RT (150.0 LF)
 STA 300+65.0 - STA 301+15.0 LT (50.0 LF)
 STA 303+91.0 - STA 304+41.0 RT (50.0 LF)
 STA 303+91.0 - STA 304+78.5 LT (87.5 LF)~~

~~621.50 MANUFACTURED TERMINAL SECTION, FLARED
 ARLINGTON:
 STA 299+27.5 - STA 299+65.0 RT
 STA 300+27.5 - STA 300+65.0 LT
 STA 304+41.0 - STA 304+78.5 RT
 STA 304+78.5 - STA 305+16.0 LT
 STA 312+47.7 - STA 312+50.0 RT~~