

646.406 DURABLE 4 INCH WHITE LINE, RECESSED POLYUREA  
 (ALL LINES WILL INCLUDE EDGE LINE BREAKS AND  
 RADIUS FOR TOWN HIGHWAYS)  
 SUNDERLAND:  
 STA 72+50.00 - STA 86+50.00 EDGE LINE LT & RT

646.416 DURABLE 4 INCH YELLOW LINE, RECESSED POLYUREA  
 (ALL LINES WILL INCLUDE C/L BREAKS FOR  
 TOWN HIGHWAYS) S=SOLID, D=DASHED  
 SUNDERLAND:  
 STA 72+50.00 - STA 86+50.00


LT ☉ RT  
 S - S

646.602 TEMPORARY 4 INCH WHITE LINE, PAINT  
 (ALL LINES WILL INCLUDE EDGE LINE BREAKS AND  
 RADIUS FOR TOWN HIGHWAYS)  
 SUNDERLAND:  
 STA 74+18.40 - STA 86+50.00 EDGE LINE LT & RT

646.612 TEMPORARY 4 INCH YELLOW LINE, PAINT  
 (ALL LINES WILL INCLUDE C/L BREAKS FOR  
 TOWN HIGHWAYS) S=SOLID, D=DASHED  
 SUNDERLAND:  
 STA 74+18.40 - STA 86+50.00

LT ☉ RT  
 S - S

675.50 REMOVING SIGNS  
 AS SHOWN - 2 3 ✓

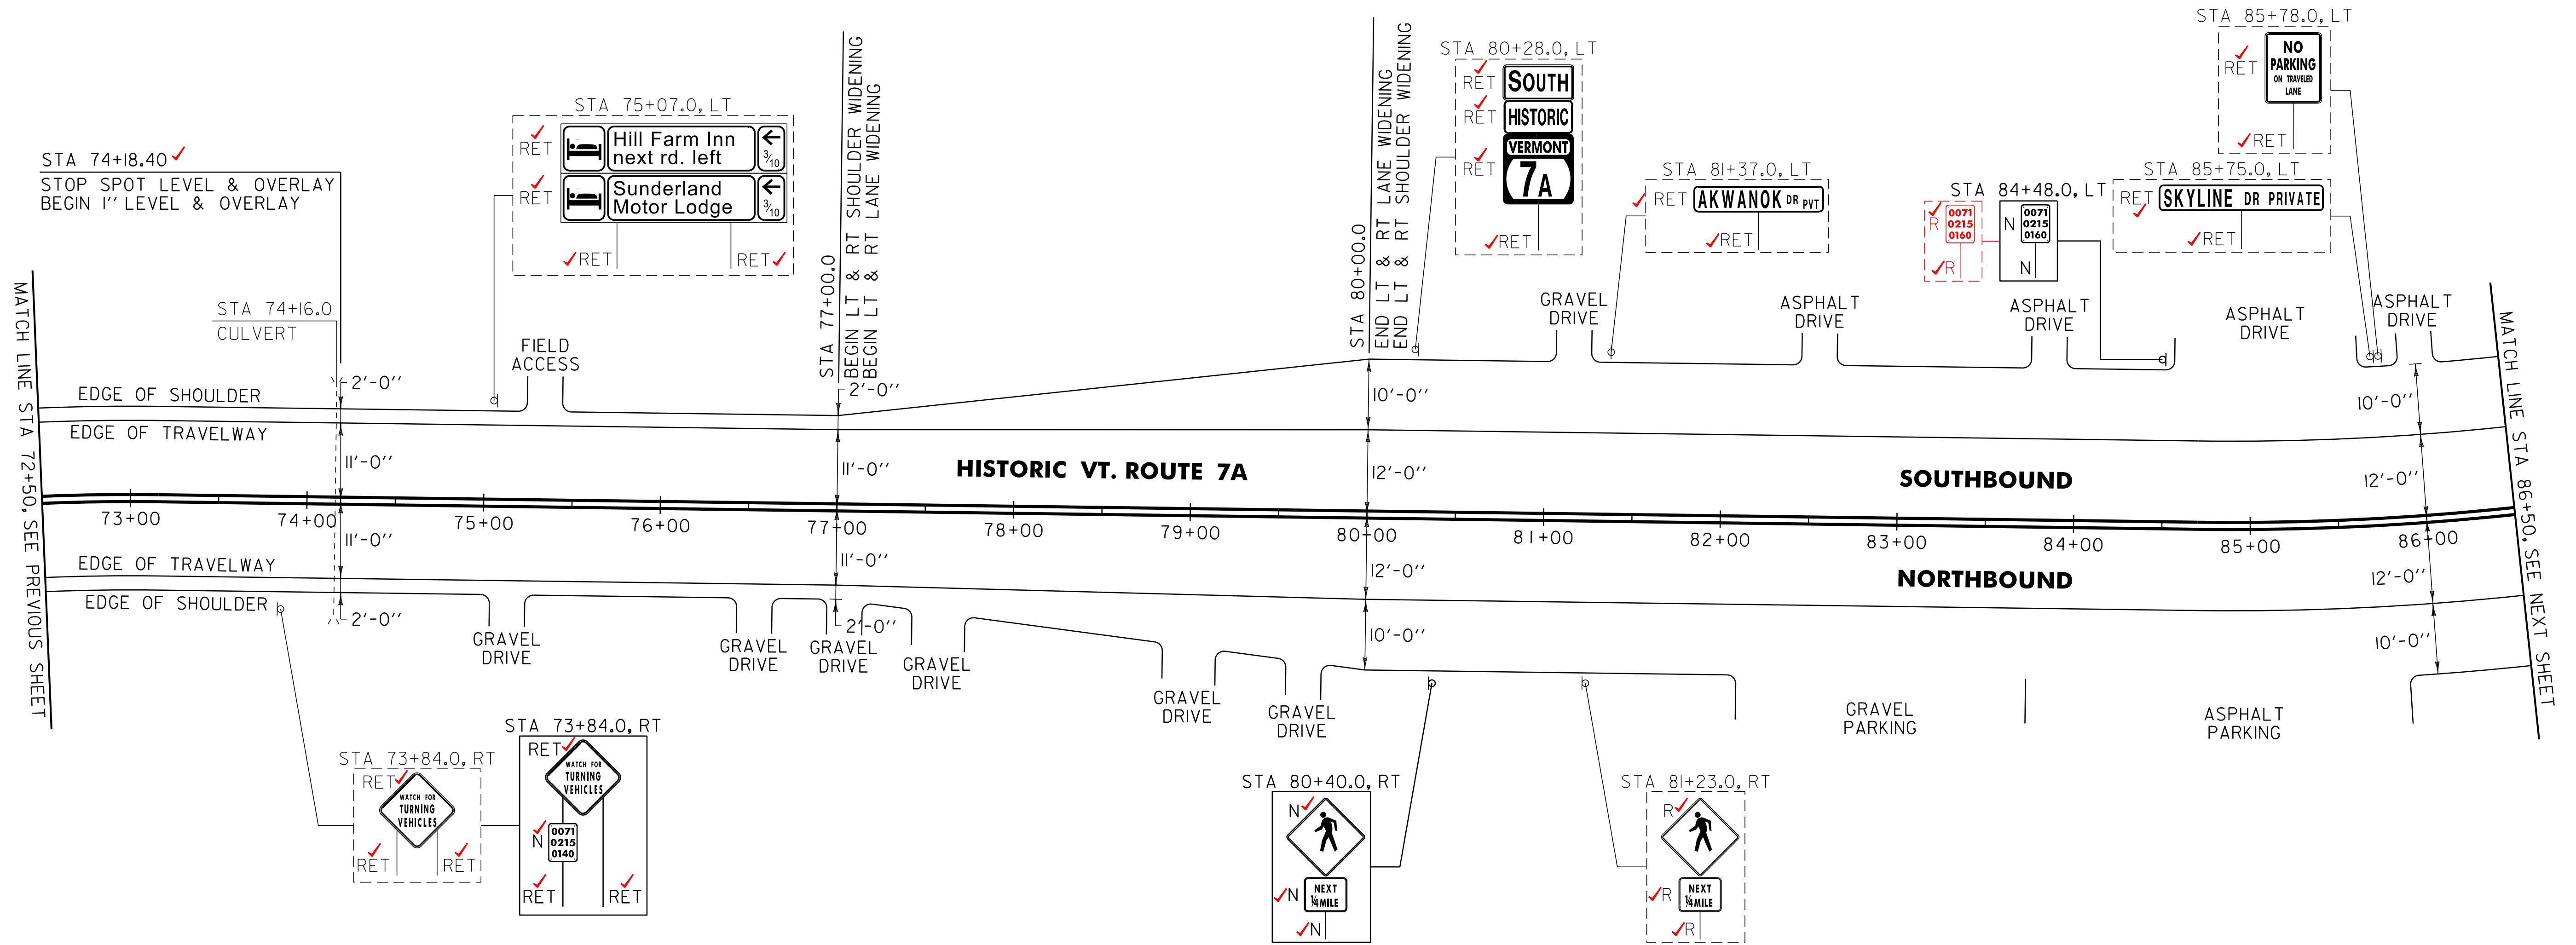

NOT TO SCALE

**SIGN LEGEND**  
 R = REMOVE  
 S = SALVAGE  
 N = NEW  
 RET = RETAIN  
 B-B = BACK TO BACK  
 EXISTING = - - - - -  
 NEW = \_\_\_\_\_

<b>PROJECT LAYOUT SHEET #16</b>	PROJECT NAME: ARLINGTON-DORSET	PLOT DATE: \$DATE\$
	PROJECT NUMBER: STP 2625(1)	DRAWN BY: C.A.K.
	FILE NAME: p06c218.dgn	CHECKED BY: M.J.L.
	PROJECT LEADER: D.E.G.	SHEET 84 OF 143
	DESIGNED BY: D.W.E.	
	IPARM FILE: p06c2181016.i	