


646.406 DURABLE 4 INCH WHITE LINE, RECESSED POLYUREA  
 (ALL LINES WILL INCLUDE EDGE LINE BREAKS AND  
 RADIUS FOR TOWN HIGHWAYS)  
 MANCHESTER:  
 STA 72+50.00 - STA 86+50.00 EDGE LINE LT & RT

646.416 DURABLE 4 INCH YELLOW LINE, RECESSED POLYUREA  
 (ALL LINES WILL INCLUDE C/L BREAKS FOR  
 TOWN HIGHWAYS) S=SOLID, D=DASHED  
 MANCHESTER:  
 STA 72+50.00 - STA 86+50.00

675.50 REMOVING SIGNS  
 AS SHOWN - 4 ✓

LT C RT  
 S - S

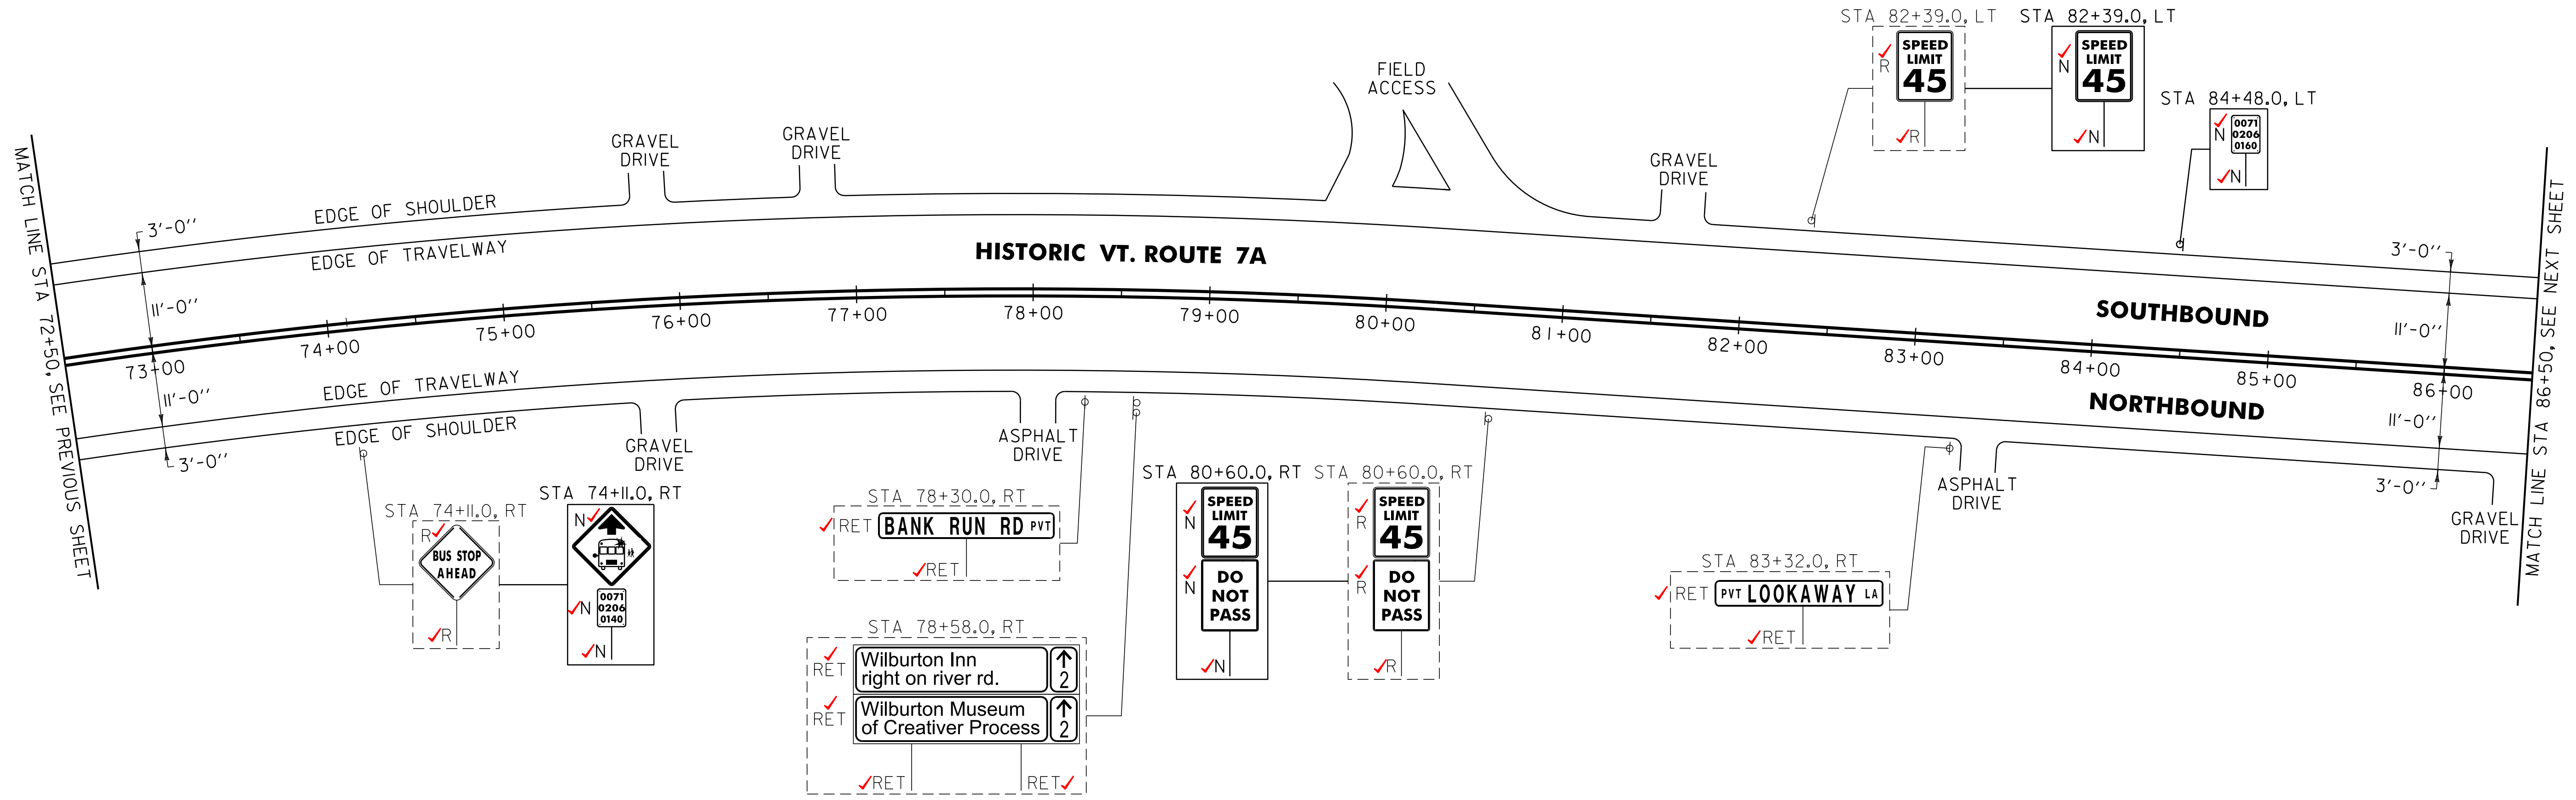

NOT TO SCALE

**SIGN LEGEND**  
 R = REMOVE  
 S = SALVAGE  
 N = NEW  
 RET = RETAIN  
 B-B = BACK TO BACK  
 EXISTING = - - - - -  
 NEW = \_\_\_\_\_

<b>PROJECT LAYOUT SHEET #23</b>	PROJECT NAME: ARLINGTON-DORSET	PLOT DATE: \$DATE\$
	PROJECT NUMBER: STP 2625(1)	DRAWN BY: C.A.K.
	FILE NAME: p06c218.dgn	CHECKED BY: M.J.L.
	PROJECT LEADER: D.E.G. DESIGNED BY: D.W.E. IPARM FILE: p06c218i023.i	SHEET 91 OF 143