


646.406 DURABLE 4 INCH WHITE LINE, RECESSED POLYUREA  
 (ALL LINES WILL INCLUDE EDGE LINE BREAKS AND  
 RADIUS FOR TOWN HIGHWAYS)  
 MANCHESTER:  
 STA 86+50.00 - STA 100+50.00 EDGE LINE LT & RT

646.416 DURABLE 4 INCH YELLOW LINE, RECESSED POLYUREA  
 (ALL LINES WILL INCLUDE C/L BREAKS FOR  
 TOWN HIGHWAYS) S=SOLID, D=DASHED  
 MANCHESTER:  
 STA 86+50.00 - STA 100+50.00 LT C RT  
 S - S

675.50 REMOVING SIGNS  
 AS SHOWN - 4 ✓

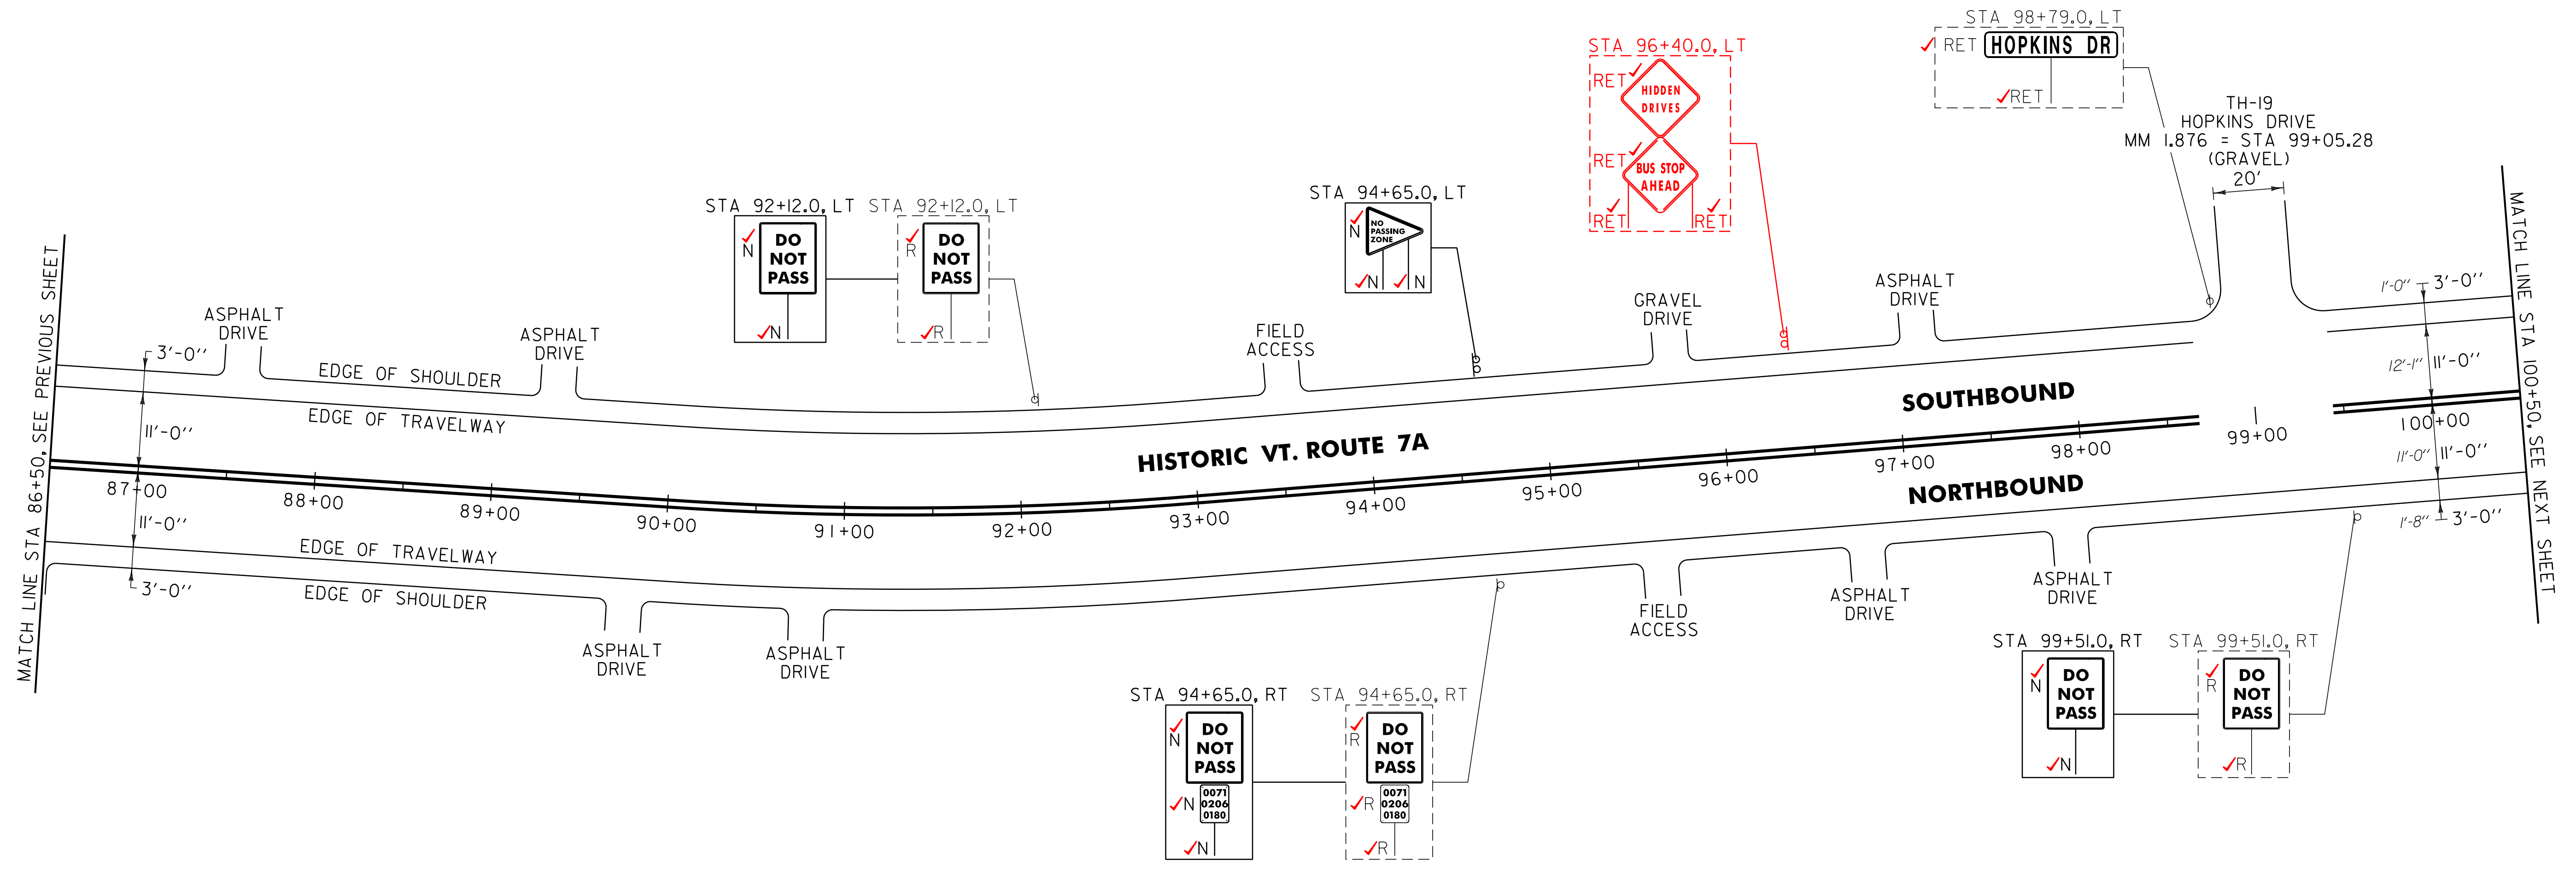

NOTE:  
 1. PAVING LIMIT ON ALL TOWN HIGHWAYS SHALL BE MEASURED 25 FT BACK FROM HISTORIC VT. ROUTE 7A EDGE OF SHOULDER UNLESS DENOTED OTHERWISE ON THE PLANS OR AS DIRECTED BY THE RESIDENT ENGINEER.

**SIGN LEGEND**  
 R = REMOVE  
 S = SALVAGE  
 N = NEW  
 RET = RETAIN  
 B-B = BACK TO BACK  
 EXISTING = - - - - -  
 NEW = \_\_\_\_\_

<b>PROJECT LAYOUT SHEET #24</b>	PROJECT NAME: ARLINGTON-DORSET	PLOT DATE: \$DATE\$
	PROJECT NUMBER: STP 2625(1)	DRAWN BY: C.A.K.
	FILE NAME: p06c218.dgn	CHECKED BY: M.J.L.
	DESIGNED BY: D.W.E.	SHEET 92 OF 143
	IPARM FILE: p06c218i024.i	