


646.406 DURABLE 4 INCH WHITE LINE, RECESSED POLYUREA
 (ALL LINES WILL INCLUDE EDGE LINE BREAKS AND
 RADIUS FOR TOWN HIGHWAYS)
 MANCHESTER:
 STA 100+50.00 - STA 114+50.00 EDGE LINE LT & RT

646.416 DURABLE 4 INCH YELLOW LINE, RECESSED POLYUREA
 (ALL LINES WILL INCLUDE C/L BREAKS FOR
 TOWN HIGHWAYS) S=SOLID, D=DASHED
 MANCHESTER:
 STA 100+50.00 - STA 114+50.00

LT ☉ RT
 S - S

675.50 REMOVING SIGNS
 AS SHOWN - 5 ✓

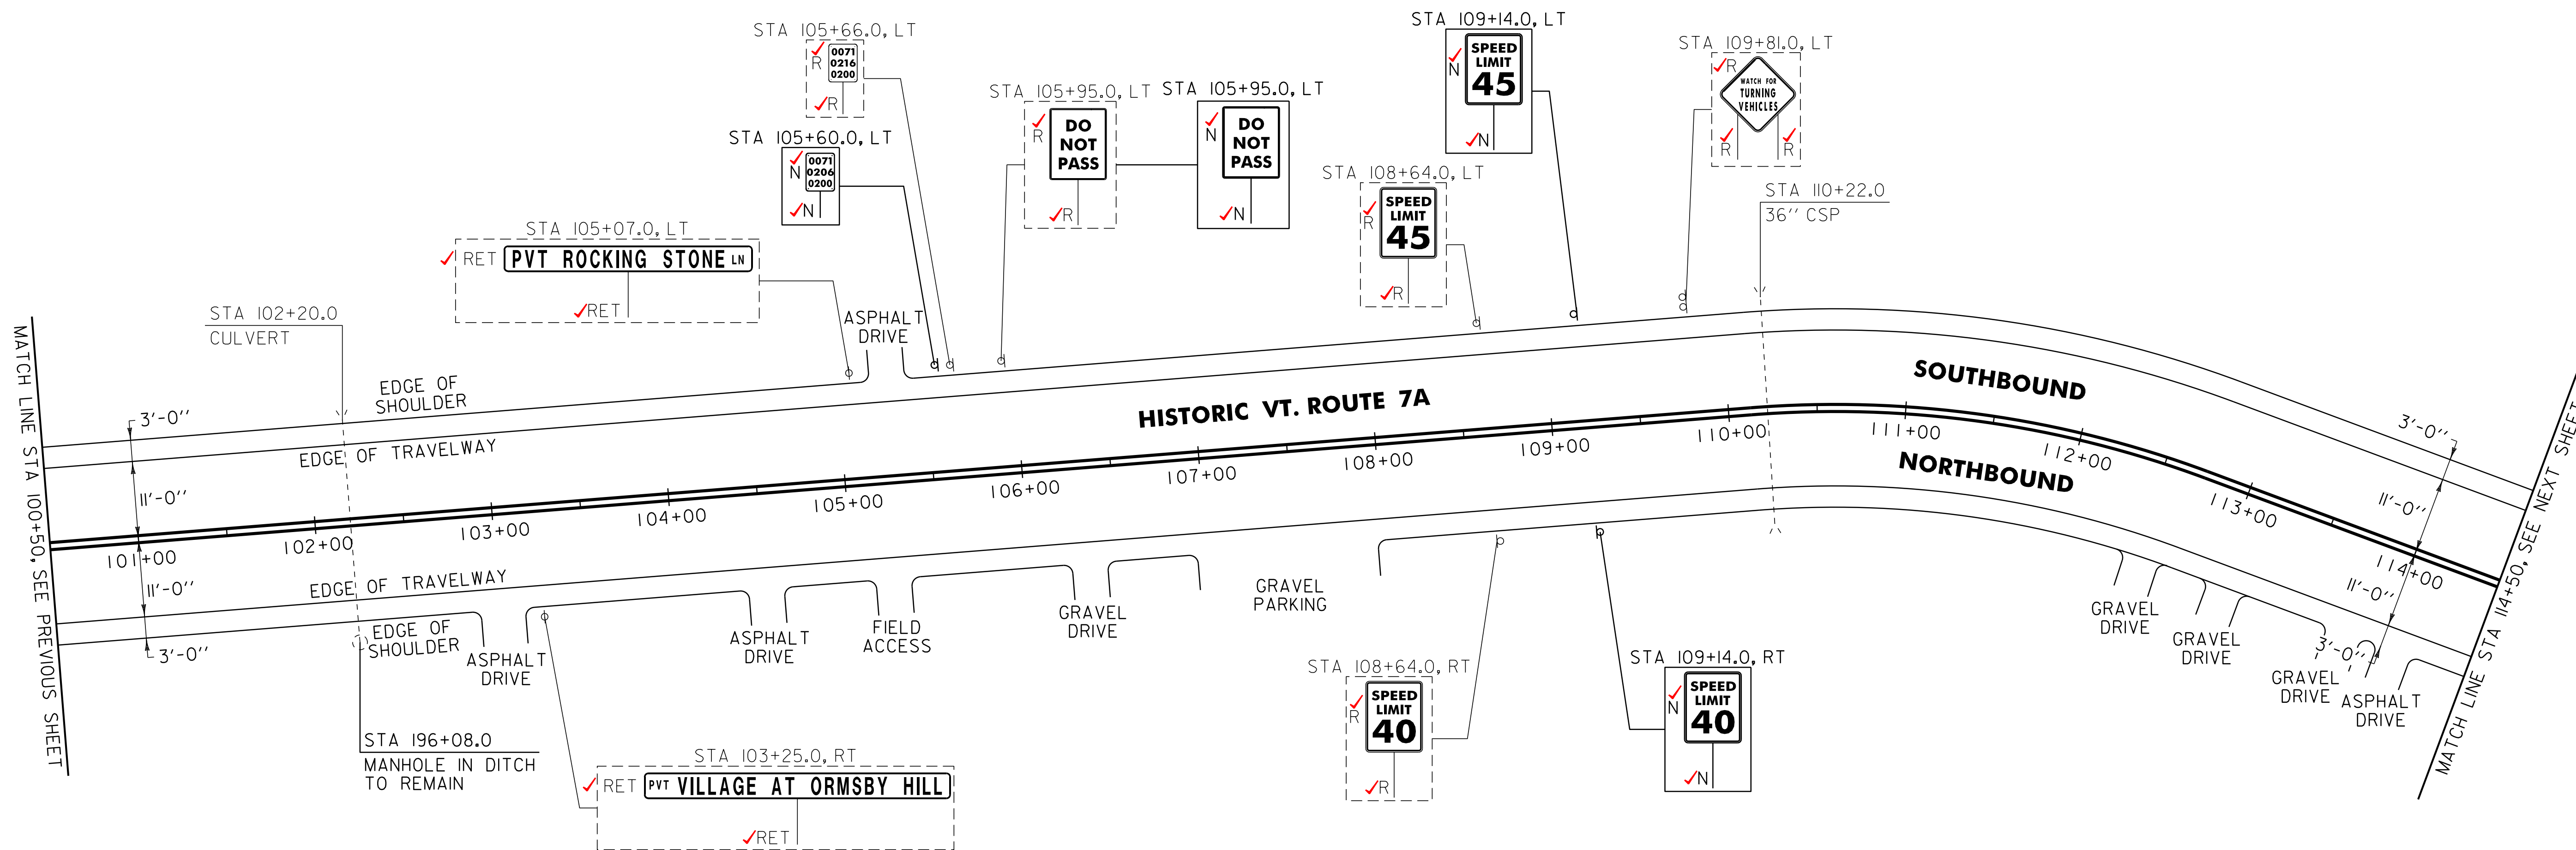

SIGN LEGEND
 R = REMOVE
 S = SALVAGE
 N = NEW
 RET = RETAIN
 B-B = BACK TO BACK
 EXISTING = - - - - -
 NEW = _____

NOT TO SCALE

PROJECT LAYOUT SHEET #25	PROJECT NAME: ARLINGTON-DORSET	FILE NAME: p06c218.dgn	PLOT DATE: \$DATE\$
	PROJECT NUMBER: STP 2625(1)	PROJECT LEADER: D.E.G.	DRAWN BY: C.A.K.
	DESIGNED BY: D.W.E.	CHECKED BY: M.J.L.	SHEET 93 OF 143
	IPARM FILE: p06c218i025.i		