

646.406 DURABLE 4 INCH WHITE LINE, RECESSED POLYUREA  
 (ALL LINES WILL INCLUDE EDGE LINE BREAKS AND RADIUS FOR TOWN HIGHWAYS)  
 MANCHESTER:  
 STA 405+50.00 - STA 426+25.44 EDGE LINE LT & RT  
 DORSET:  
 STA 0+00.00 - STA 7+50.00 EDGE LINE LT & RT

646.416 DURABLE 4 INCH YELLOW LINE, RECESSED POLYUREA  
 (ALL LINES WILL INCLUDE C/L BREAKS FOR TOWN HIGHWAYS) S=SOLID, D=DASHED  
 MANCHESTER:  
 STA 405+50.00 - STA 406+30.00  
 STA 406+30.00 - STA 426+25.44  
 DORSET:  
 STA 0+00.00 - STA 7+50.00



646.602 TEMPORARY 4 INCH WHITE LINE, PAINT  
 (ALL LINES WILL INCLUDE EDGE LINE BREAKS AND RADIUS FOR TOWN HIGHWAYS)  
 MANCHESTER:  
 STA 405+50.00 - STA 426+25.44 EDGE LINE LT & RT  
 DORSET:  
 STA 0+00.00 - STA 7+50.00 EDGE LINE LT & RT

646.612 TEMPORARY 4 INCH YELLOW LINE, PAINT  
 (ALL LINES WILL INCLUDE C/L BREAKS FOR TOWN HIGHWAYS) S=SOLID, D=DASHED  
 MANCHESTER:  
 STA 405+50.00 - STA 406+30.00  
 STA 406+30.00 - STA 426+25.44  
 DORSET:  
 STA 0+00.00 - STA 7+50.00

675.50 REMOVING SIGNS AS SHOWN - 2 ✓

LT C RT  
 S - D  
 - D -  
 - D -

LT C RT  
 S - D  
 - D -  
 - D -

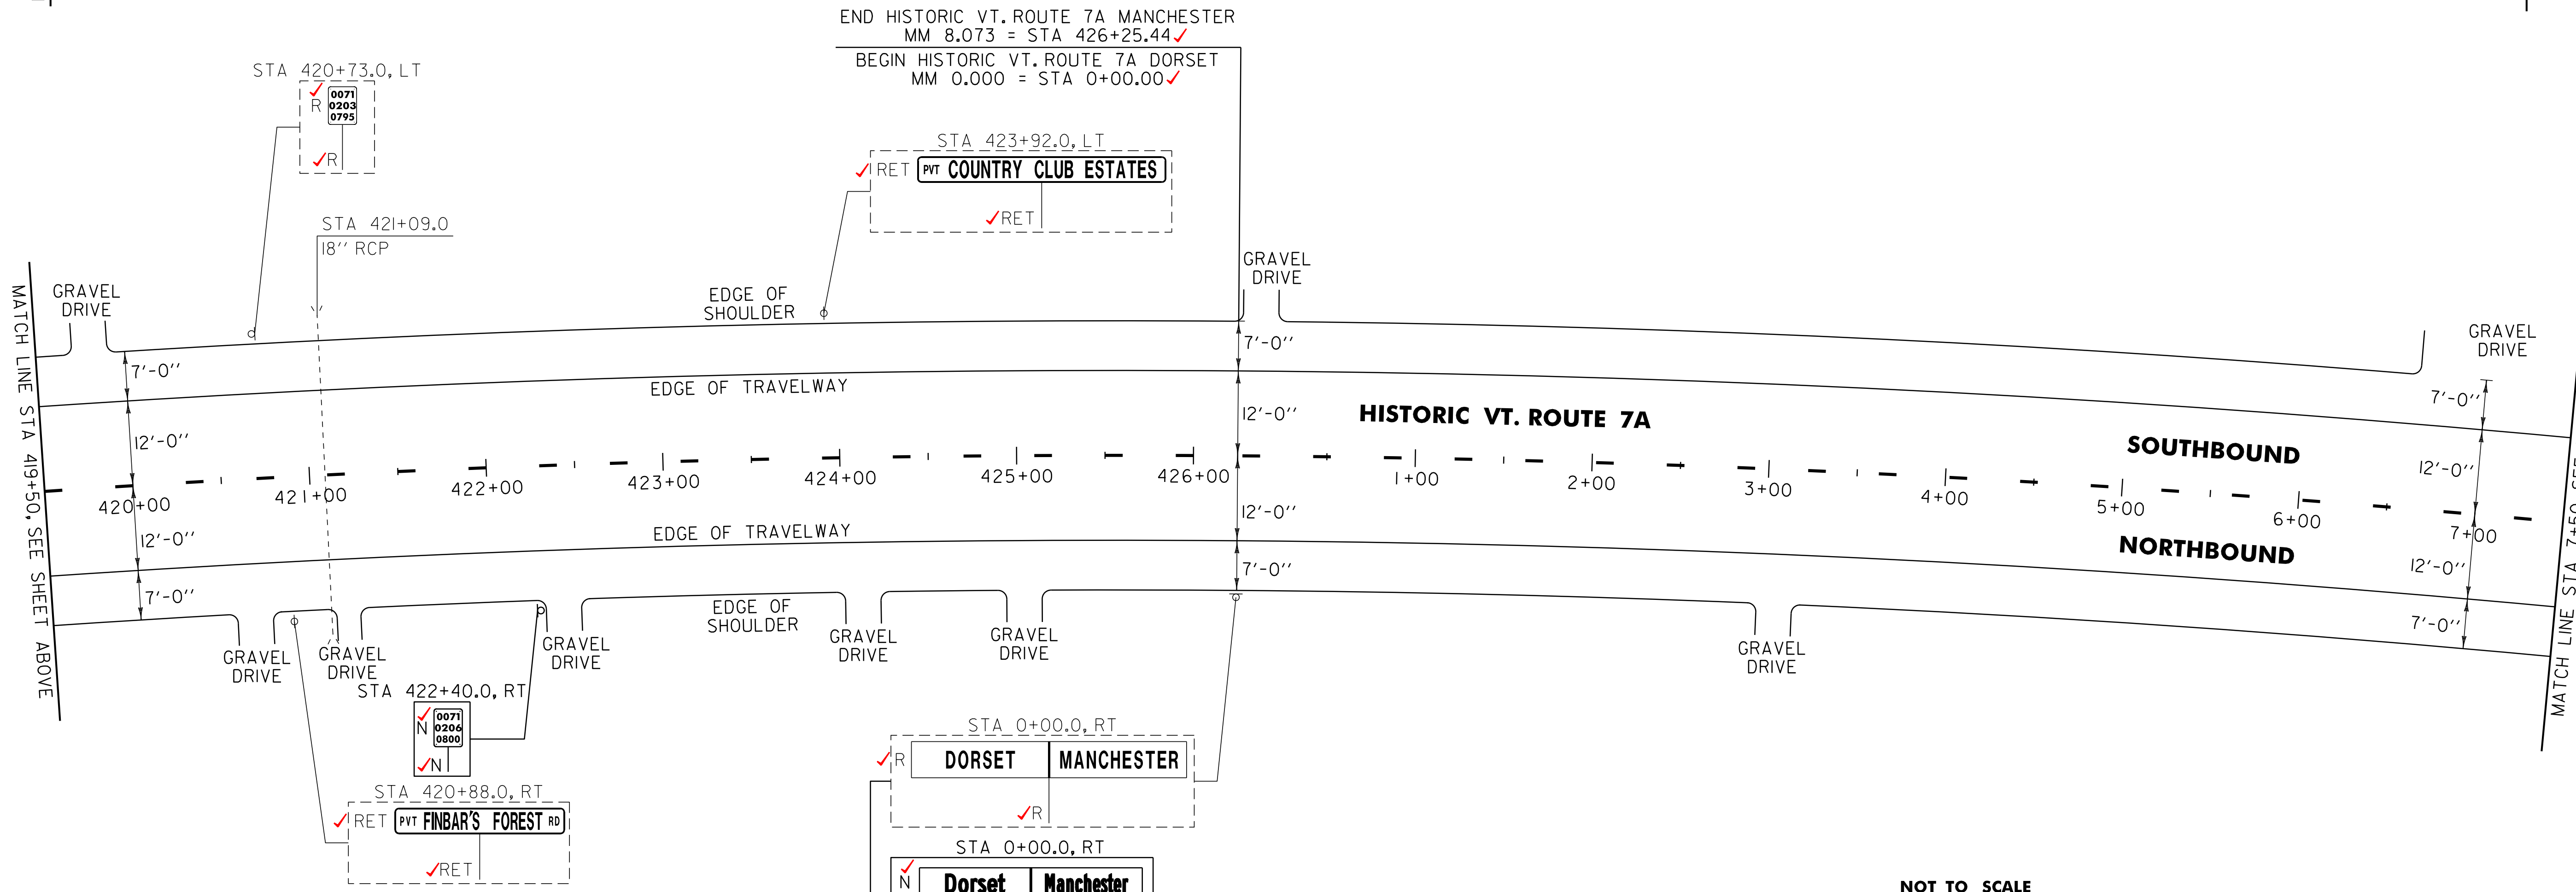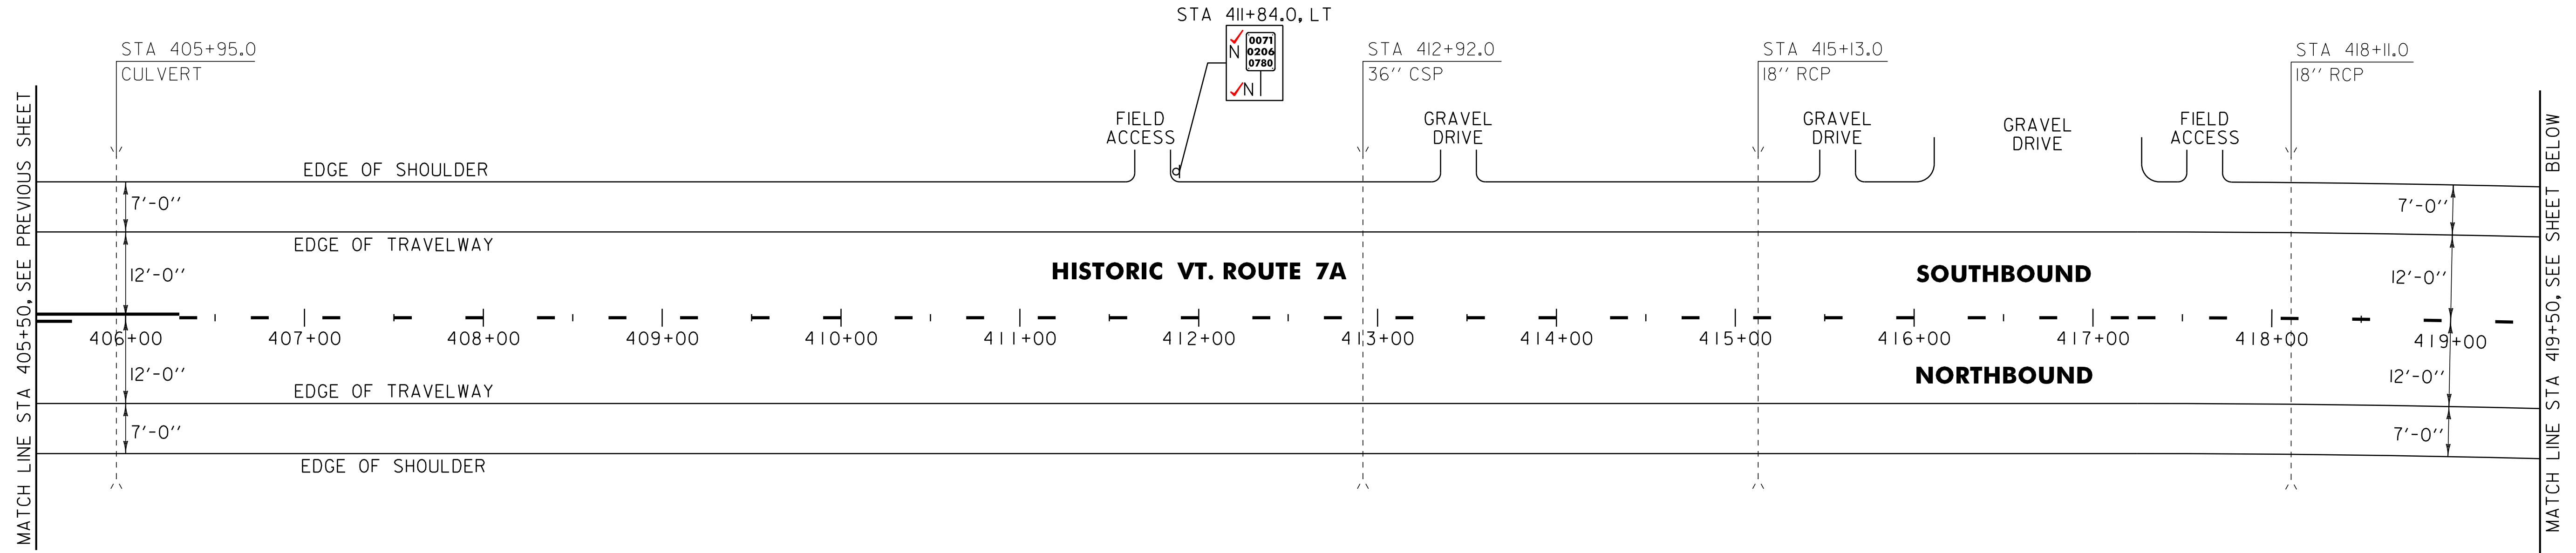

END HISTORIC VT. ROUTE 7A MANCHESTER  
 MM 8.073 = STA 426+25.44 ✓  
 BEGIN HISTORIC VT. ROUTE 7A DORSET  
 MM 0.000 = STA 0+00.00 ✓

**SIGN LEGEND**  
 R = REMOVE  
 S = SALVAGE  
 N = NEW  
 RET = RETAIN  
 B-B = BACK TO BACK  
 EXISTING = - - - - -  
 NEW = \_\_\_\_\_

**NOT TO SCALE**

<b>PROJECT LAYOUT SHEET #28</b>	PROJECT NAME: ARLINGTON-DORSET	PLOT DATE: \$DATE\$
	PROJECT NUMBER: STP 2625(1)	DRAWN BY: C.A.K.
	FILE NAME: p06c218.dgn	CHECKED BY: M.J.L.
	DESIGNED BY: D.W.E.	SHEET 96 OF 143
	IPARM FILE: p06c218i028.i	