


646.406 DURABLE 4 INCH WHITE LINE, RECESSED POLYUREA
(ALL LINES WILL INCLUDE EDGE LINE BREAKS AND RADIUS FOR TOWN HIGHWAYS)
DORSET:
STA 7+50.00 - STA 35+50.00 EDGE LINE LT & RT

646.416 DURABLE 4 INCH YELLOW LINE, RECESSED POLYUREA
(ALL LINES WILL INCLUDE C/L BREAKS FOR TOWN HIGHWAYS) S=SOLID, D=DASHED
DORSET:
STA 7+50.00 - STA 12+10.00 LT C RT - D -
STA 12+10.00 - STA 21+60.00 D - S
STA 21+60.00 - STA 30+60.00 S - S
STA 30+60.00 - STA 35+50.00 S - D

646.602 TEMPORARY 4 INCH WHITE LINE, PAINT
(ALL LINES WILL INCLUDE EDGE LINE BREAKS AND RADIUS FOR TOWN HIGHWAYS)
DORSET:
STA 7+50.00 - STA 35+50.00 EDGE LINE LT & RT

646.612 TEMPORARY 4 INCH YELLOW LINE, PAINT
(ALL LINES WILL INCLUDE C/L BREAKS FOR TOWN HIGHWAYS) S=SOLID, D=DASHED
DORSET:
STA 7+50.00 - STA 12+10.00 LT C RT - D -
STA 12+10.00 - STA 21+60.00 D - S
STA 21+60.00 - STA 30+60.00 S - S
STA 30+60.00 - STA 35+50.00 S - D

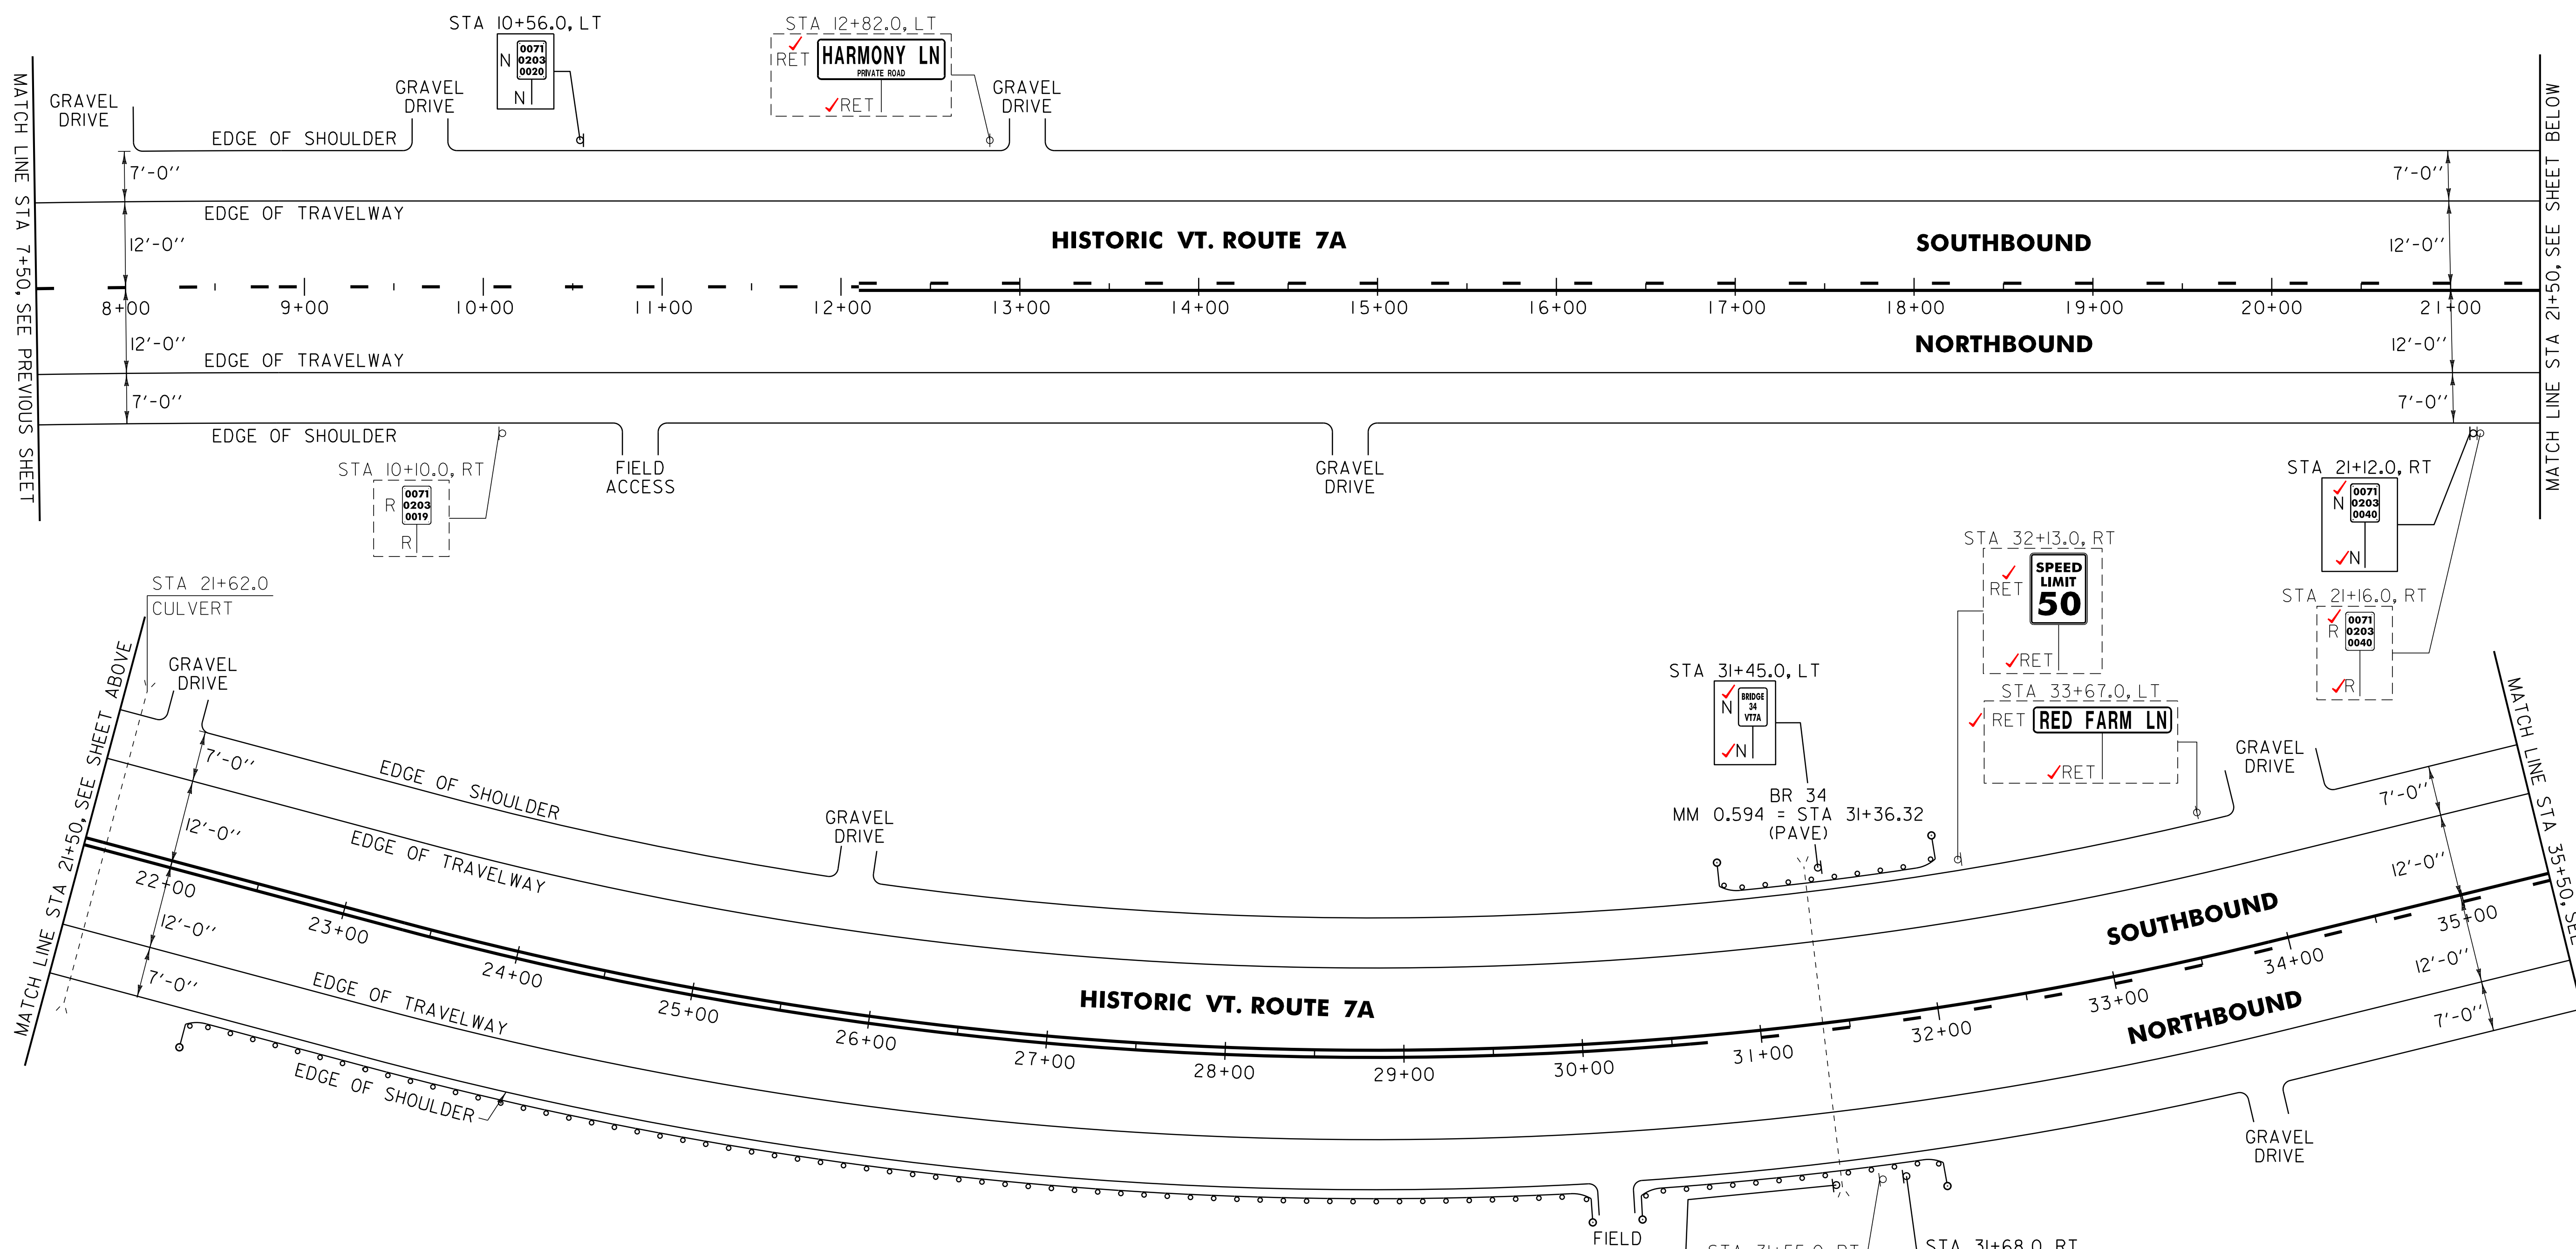


621.20 STEEL BEAM GUARDRAIL, GALVANIZED
DORSET:
STA 22+62.5 ✓ - STA 29+62.5 ✓ RT (700.0 LF) ✓
STA 30+65.0 ✓ - STA 31+52.5 ✓ RT (87.5 LF) ✓
STA 31+17.5 ✓ - STA 31+80.0 ✓ LT (62.5 LF) ✓

621.50 MANUFACTURED TERMINAL SECTION, FLARED
DORSET:
STA 22+25.0 ✓ - STA 22+62.5 ✓ RT ✓
STA 29+62.5 ✓ - STA 30+00.0 ✓ RT ✓
STA 30+27.5 ✓ - STA 30+65.0 ✓ RT ✓
STA 30+80.0 ✓ - STA 31+17.5 ✓ LT ✓
STA 31+52.5 ✓ - STA 31+90.0 ✓ RT ✓
STA 31+80.0 ✓ - STA 32+17.5 ✓ LT ✓

621.80 REMOVAL AND DISPOSAL OF GUARDRAIL
DORSET:
STA 22+32.0 ✓ - STA 30+00.0 ✓ RT (775 LF) ✓
STA 22+32.0 ✓ - STA 30+00.0 ✓ RT (768.0 LF) ✓
STA 30+27.0 ✓ - STA 31+90.0 ✓ RT (89.0) (162.5 LF) ✓
STA 30+85.0 ✓ - STA 32+12.0 ✓ LT (127.0 LF) ✓
10.0 (125 LF)

676.10 DELINEATOR WITH STEEL POST
DORSET:
STA 22+25.0 RT
STA 30+00.0 RT
STA 30+27.5 RT
STA 30+80.0 LT
STA 31+90.0 RT
STA 32+17.5 LT

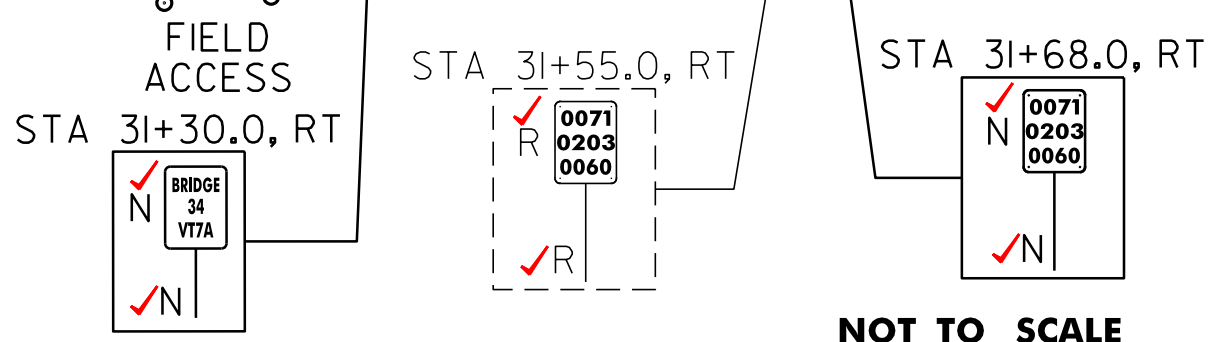

SIGN LEGEND
R = REMOVE
S = SALVAGE
N = NEW
RET = RETAIN
B-B = BACK TO BACK
EXISTING = - - - - -
NEW = _____

NOT TO SCALE

PROJECT LAYOUT SHEET #29

PROJECT NAME: ARLINGTON-DORSET	PLOT DATE: \$DATE\$
PROJECT NUMBER: STP 2625(1)	DRAWN BY: C.A.K.
FILE NAME: p06c218.dgn	CHECKED BY: M.J.L.
PROJECT LEADER: D.E.G.	SHEET 97 OF 143
DESIGNED BY: D.W.E.	
IPARM FILE: p06c2181029.i	