

646.406 DURABLE 4 INCH WHITE LINE, RECESSED POLYUREA
 (ALL LINES WILL INCLUDE EDGE LINE BREAKS AND RADIUS FOR TOWN HIGHWAYS)
 DORSET:
 STA 62+50.00 - STA 79+20.00 EDGE LINE LT & RT

646.602 TEMPORARY 4 INCH WHITE LINE, PAINT
 (ALL LINES WILL INCLUDE EDGE LINE BREAKS AND RADIUS FOR TOWN HIGHWAYS)
 DORSET:
 STA 62+50.00 - STA 79+20.00 EDGE LINE LT & RT

646.481 DURABLE LETTER OR SYMBOL, TYPE I TAPE
 DORSET:
 STA 70+91.04 LT, TH-3

646.682 TEMPORARY LETTER OR SYMBOL, PAINT
 DORSET:
 STA 70+91.04 LT, TH-3






675.50 REMOVING SIGNS
 AS SHOWN - 16 15 ✓

646.416 DURABLE 4 INCH YELLOW LINE, RECESSED POLYUREA
 (ALL LINES WILL INCLUDE C/L BREAKS FOR TOWN HIGHWAYS) S=SOLID, D=DASHED
 DORSET:
 STA 62+50.00 - STA 64+40.00 LT - D -
 STA 64+40.00 - STA 71+10.00 D - S
 STA 71+10.00 - STA 79+20.00 S - S
 STA 70+91.04 DOUBLE SOLID LT, TH-3

646.612 TEMPORARY 4 INCH YELLOW LINE, PAINT
 (ALL LINES WILL INCLUDE C/L BREAKS FOR TOWN HIGHWAYS) S=SOLID, D=DASHED
 DORSET:
 STA 62+50.00 - STA 64+40.00 LT - D -
 STA 64+40.00 - STA 71+10.00 D - S
 STA 71+10.00 - STA 79+20.00 S - S
 STA 70+91.04 DOUBLE SOLID LT, TH-3

646.491 DURABLE LETTER OR SYMBOL, TYPE I TAPE
 DORSET:
 STA 70+91.04 LT, TH-3 "S,T,O,P" (4 EA)

646.692 TEMPORARY LETTER OR SYMBOL, PAINT
 DORSET:
 STA 70+91.04 LT, TH-3 "S,T,O,P" (4 EA)

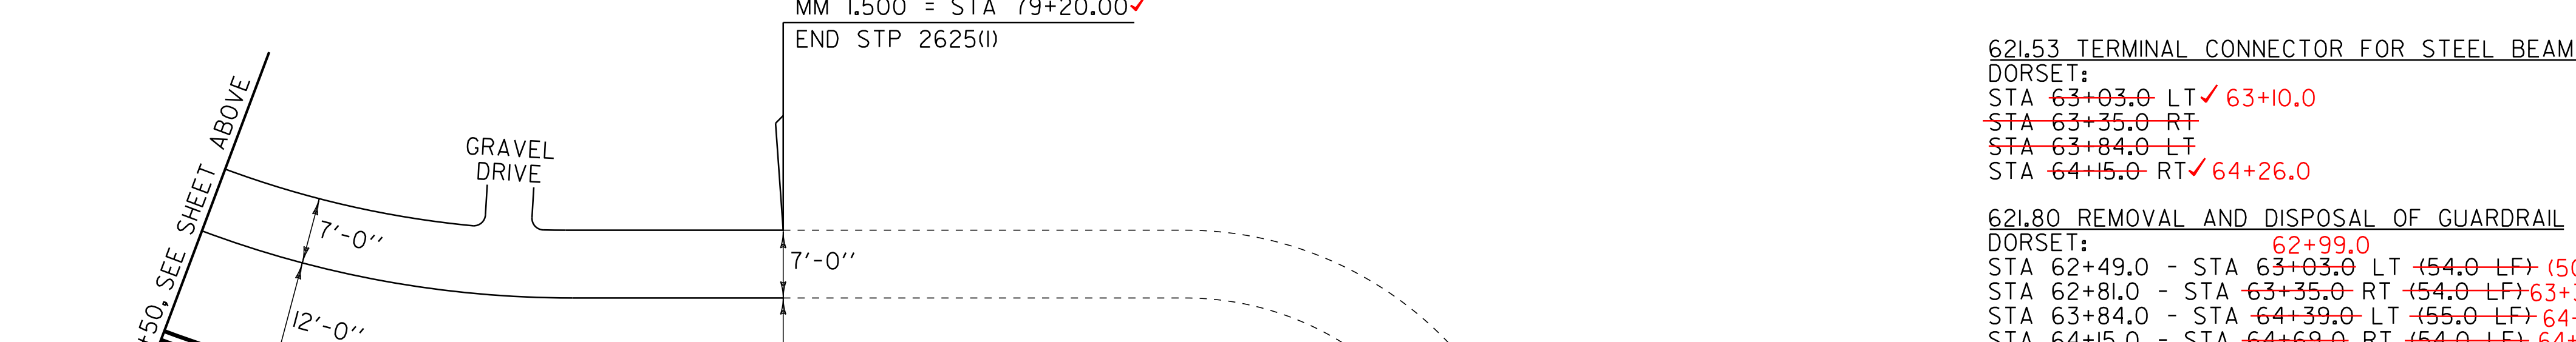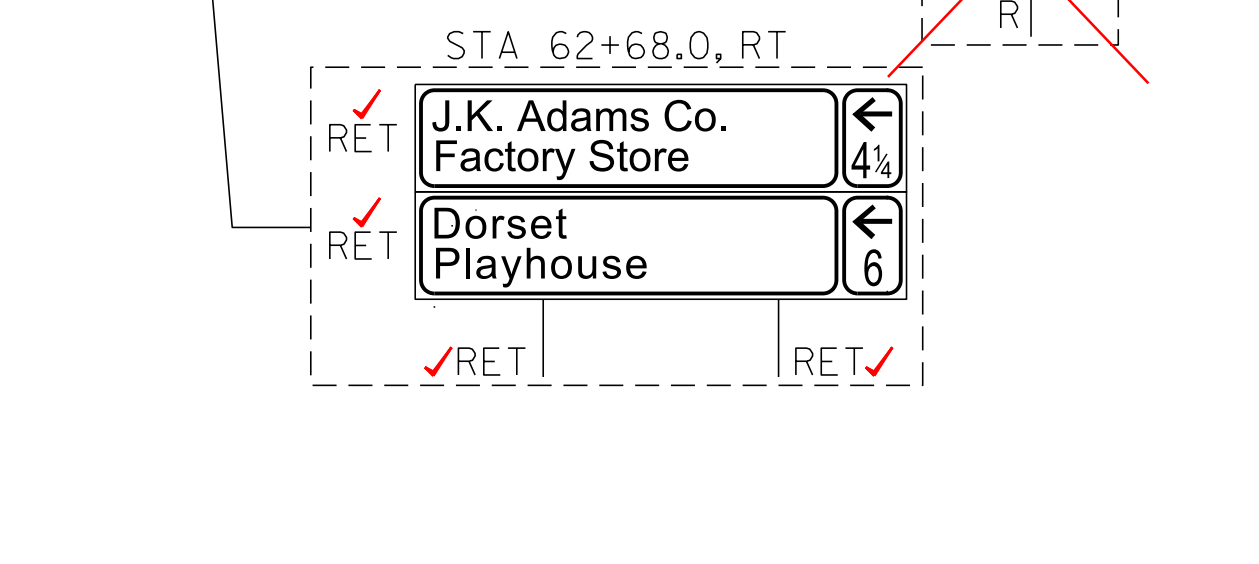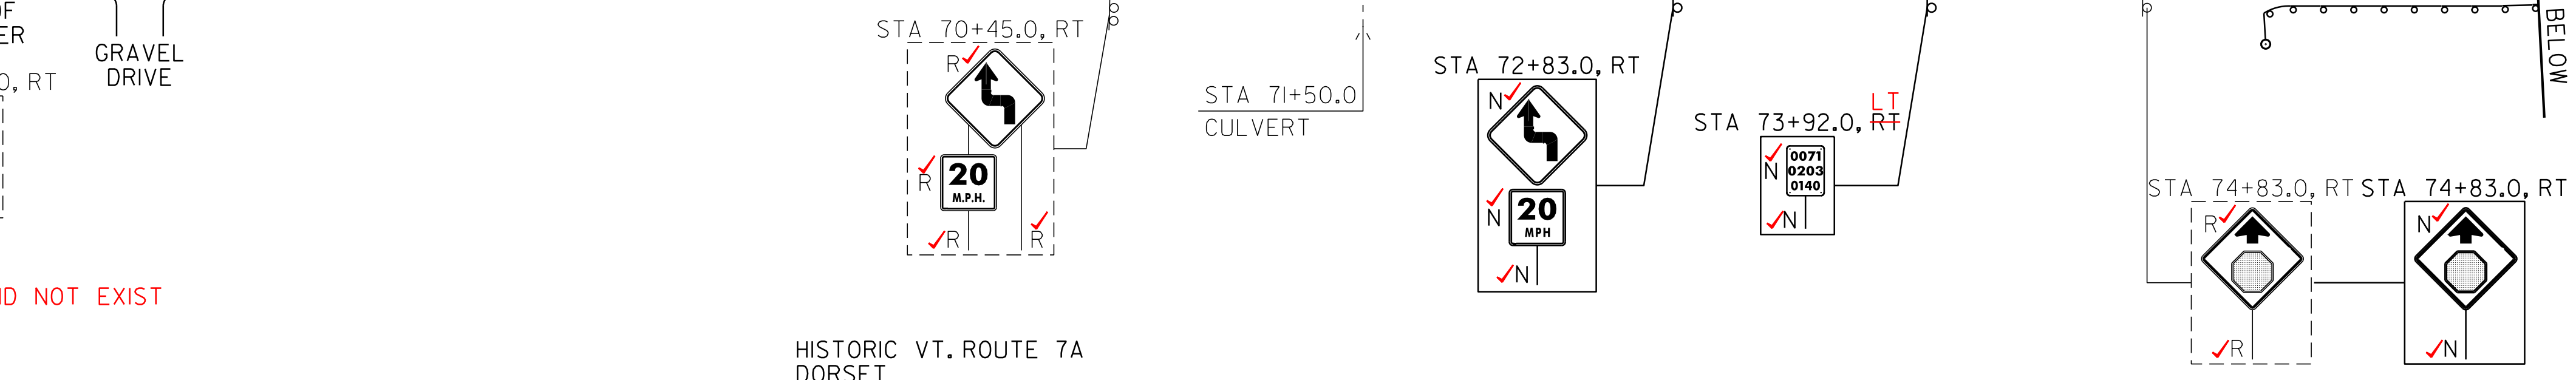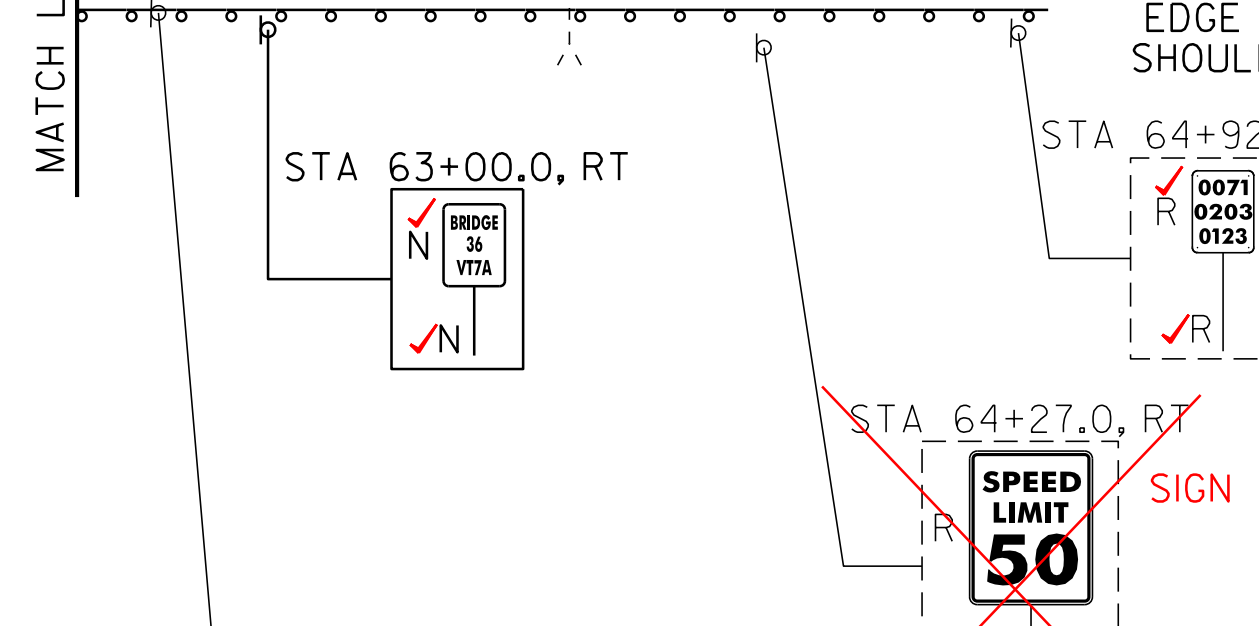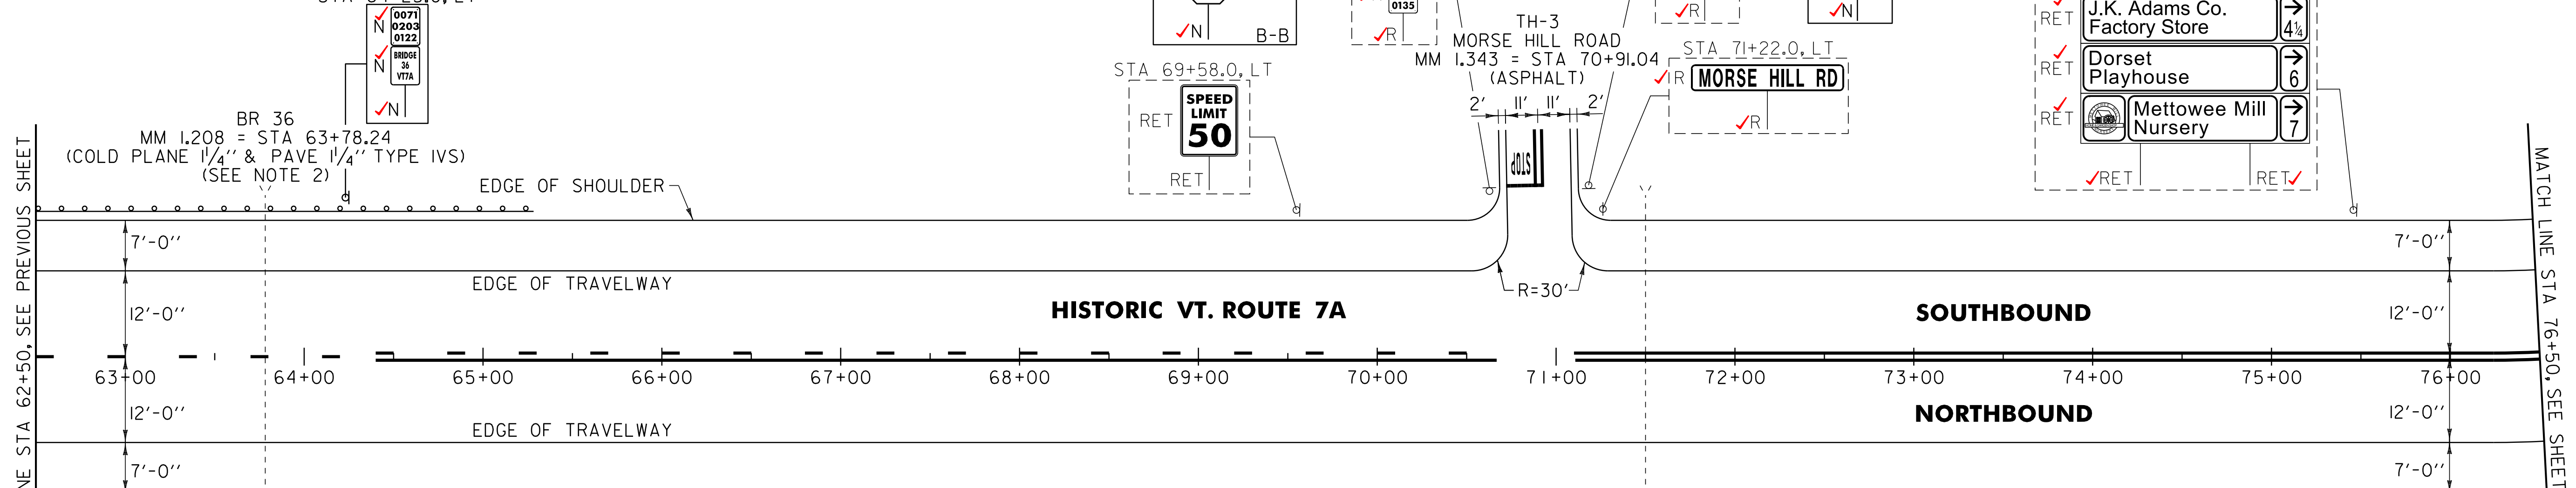


621.20 STEEL BEAM GUARDRAIL, GALVANIZED
 DORSET:
 STA 62+50.0 - STA 63+08.0 RT (58.0 LF) 62+64.0 63+14.0 (50.0 LF)
 STA 62+63.5 - STA 62+76.0 LT (12.5 LF) 62+69.5 62+82.0
 STA 64+11.0 - STA 64+73.5 LT (62.5 LF) 64+20.0 64+82.5
 STA 64+42.0 - STA 64+54.5 RT (12.5 LF) 64+54.0 64+66.5
 STA 75+72.5 - STA 78+22.5 RT (250.0 LF) 75+80.0 79+30.0 (350.0 LF)

621.21 HD STEEL BEAM GUARDRAIL, GALVANIZED
 DORSET:
 STA 62+76.0 - STA 63+01.0 LT (25.0 LF) 62+82.0 63+07.0
 STA 63+08.0 - STA 63+33.0 RT (25.0 LF) 63+14.0 63+39.0
 STA 63+86.0 - STA 64+11.0 LT (25.0 LF) 63+95.0 64+20.0
 STA 64+17.0 - STA 64+42.0 RT (25.0 LF) 64+29.0 64+54.0

621.50 MANUFACTURED TERMINAL SECTION, FLARED
 DORSET:
 STA 62+50.0 - STA 62+63.5 LT ✓
 STA 75+35.0 - STA 75+72.5 RT ✓ 75+42.5 75+80.0
 STA 78+22.5 - STA 78+60.0 RT

621.51 MANUFACTURED TERMINAL SECTION, TANGENT
 DORSET:
 STA 64+73.5 - STA 65+23.5 LT ✓ 64+82.5 65+32.5
 STA 64+54.5 - STA 65+04.5 RT ✓ 64+66.5 65+16.5
 STA 62+50.0 - STA 62+64.0 RT

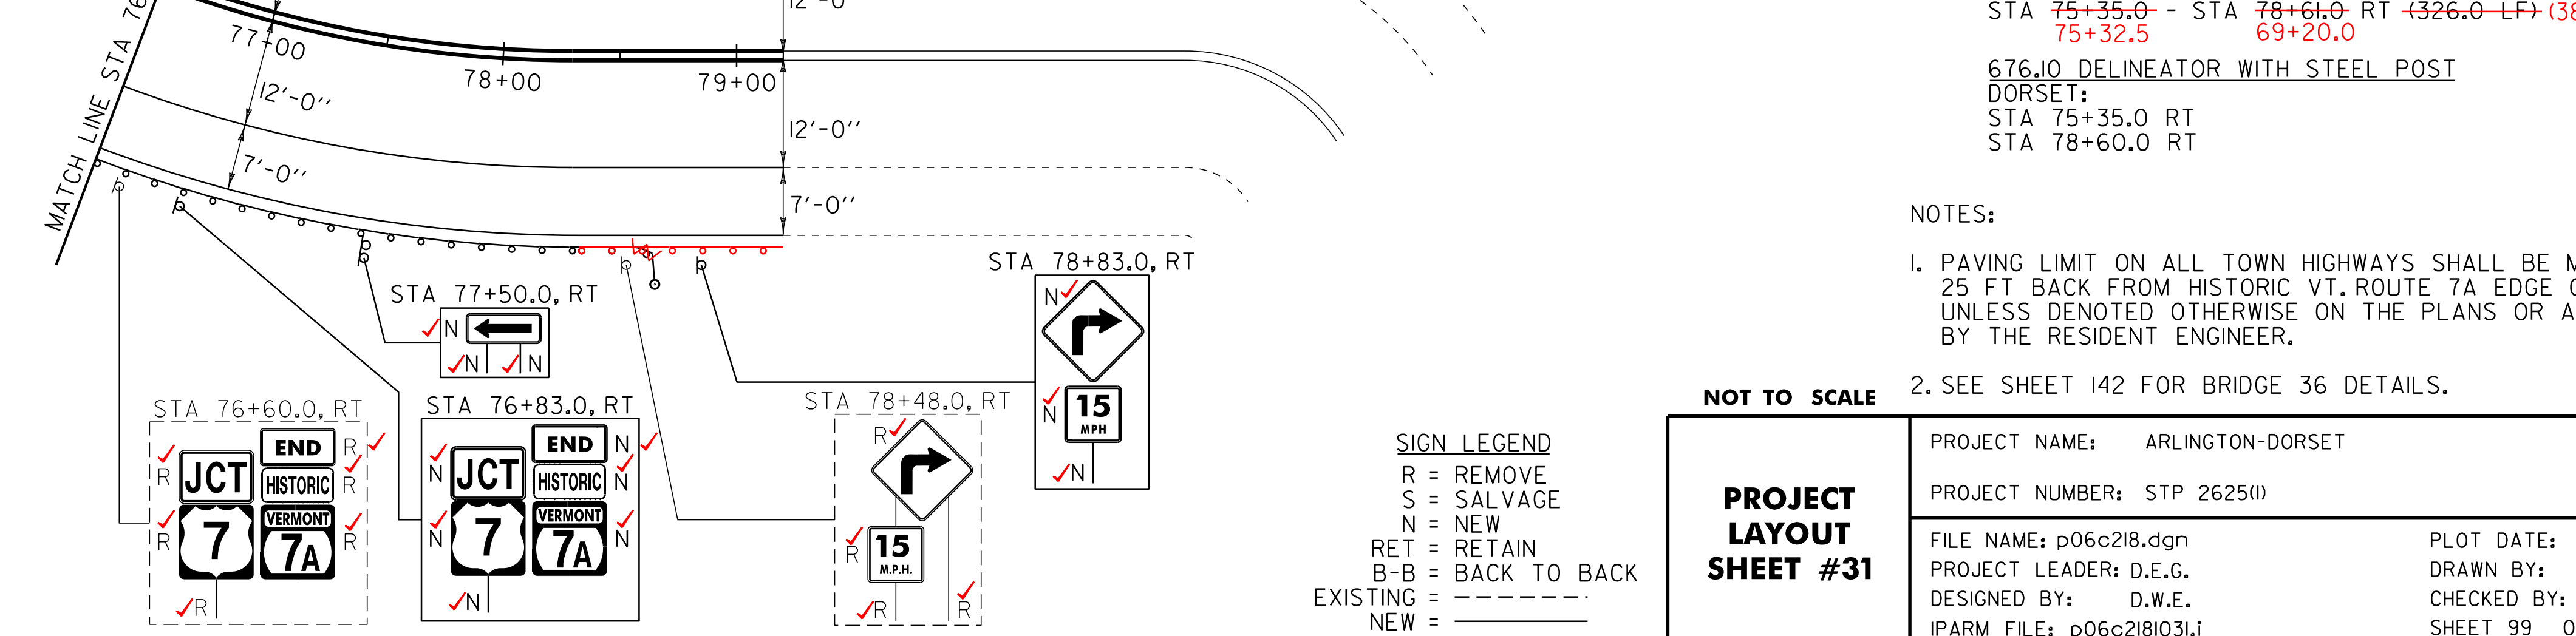

621.53 TERMINAL CONNECTOR FOR STEEL BEAM GUARDRAIL
 DORSET:
 STA 63+03.0 LT ✓ 63+10.0
 STA 63+35.0 RT
 STA 63+84.0 LT
 STA 64+15.0 RT ✓ 64+26.0

621.80 REMOVAL AND DISPOSAL OF GUARDRAIL
 DORSET:
 STA 62+49.0 - STA 62+99.0 LT (54.0 LF) (50 LF)
 STA 62+81.0 - STA 63+35.0 RT (54.0 LF) 63+31.0 (50.0 LF)
 STA 63+84.0 - STA 64+39.0 LT (55.0 LF) 64+34.0 (50.0 LF)
 STA 64+15.0 - STA 64+69.0 RT (54.0 LF) 64+65.0 (50.0 LF)
 STA 75+35.0 - STA 78+61.0 RT (326.0 LF) (387.5 LF)
 75+32.5 69+20.0

676.10 DELINEATOR WITH STEEL POST
 DORSET:
 STA 75+35.0 RT
 STA 78+60.0 RT

NOTES:
 1. PAVING LIMIT ON ALL TOWN HIGHWAYS SHALL BE MEASURED 25 FT BACK FROM HISTORIC VT. ROUTE 7A EDGE OF SHOULDER UNLESS DENOTED OTHERWISE ON THE PLANS OR AS DIRECTED BY THE RESIDENT ENGINEER.
 2. SEE SHEET 142 FOR BRIDGE 36 DETAILS.

NOT TO SCALE

PROJECT LAYOUT SHEET #31

PROJECT NAME: ARLINGTON-DORSET	FILE NAME: p06c218.dgn	PLOT DATE: \$DATE\$
PROJECT NUMBER: STP 2625(1)	PROJECT LEADER: D.E.G.	DRAWN BY: C.A.K.
	DESIGNED BY: D.W.E.	CHECKED BY: M.J.L.
	IPARM FILE: p06c218i03.i	SHEET 99 OF 143

SIGN LEGEND
 R = REMOVE
 S = SALVAGE
 N = NEW
 RET = RETAIN
 B-B = BACK TO BACK
 EXISTING = _____
 NEW = _____