


COLOR: WHITE BORDER & TEXT (REFLECTORIZED)  
GREEN BACKGROUND (REFLECTORIZED)

MATERIAL: PER VAOT STANDARD E-123


LOCATION: HISTORIC VT. ROUTE 7A  
SUNDERLAND:  
STA 67+10.0, RT

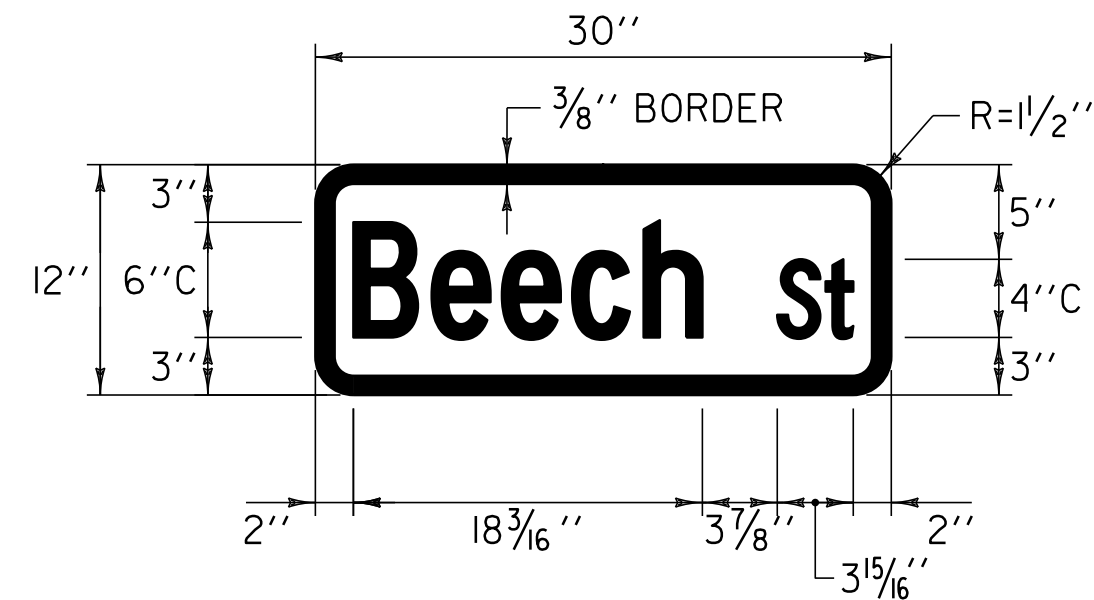

COLOR: WHITE BORDER & TEXT (REFLECTORIZED)  
GREEN BACKGROUND (REFLECTORIZED)

MATERIAL: PER VAOT STANDARD E-123


LOCATION: HISTORIC VT. ROUTE 7A  
MANCHESTER:  
STA 393+06.0, RT

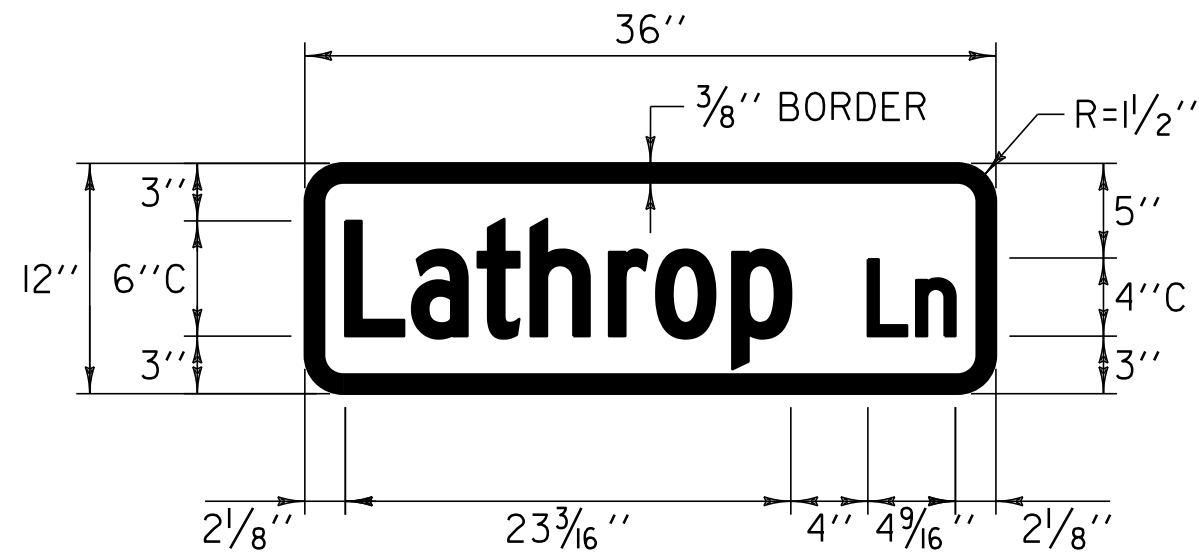

COLOR: WHITE BORDER & TEXT (REFLECTORIZED)  
GREEN BACKGROUND (REFLECTORIZED)

MATERIAL: PER VAOT STANDARD E-123


LOCATION: HISTORIC VT. ROUTE 7A  
SUNDERLAND:  
STA 98+07.0, LT

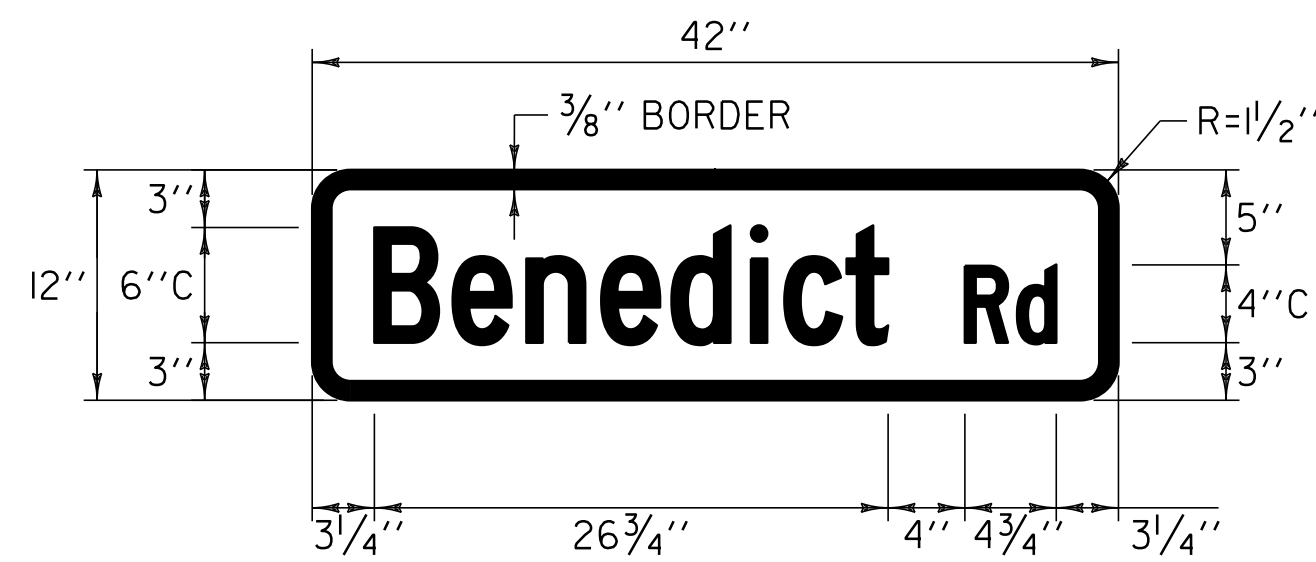

COLOR: WHITE BORDER & TEXT (REFLECTORIZED)  
GREEN BACKGROUND (REFLECTORIZED)

MATERIAL: PER VAOT STANDARD E-123


LOCATION: HISTORIC VT. ROUTE 7A  
DORSET:  
STA 49+03.0, LT

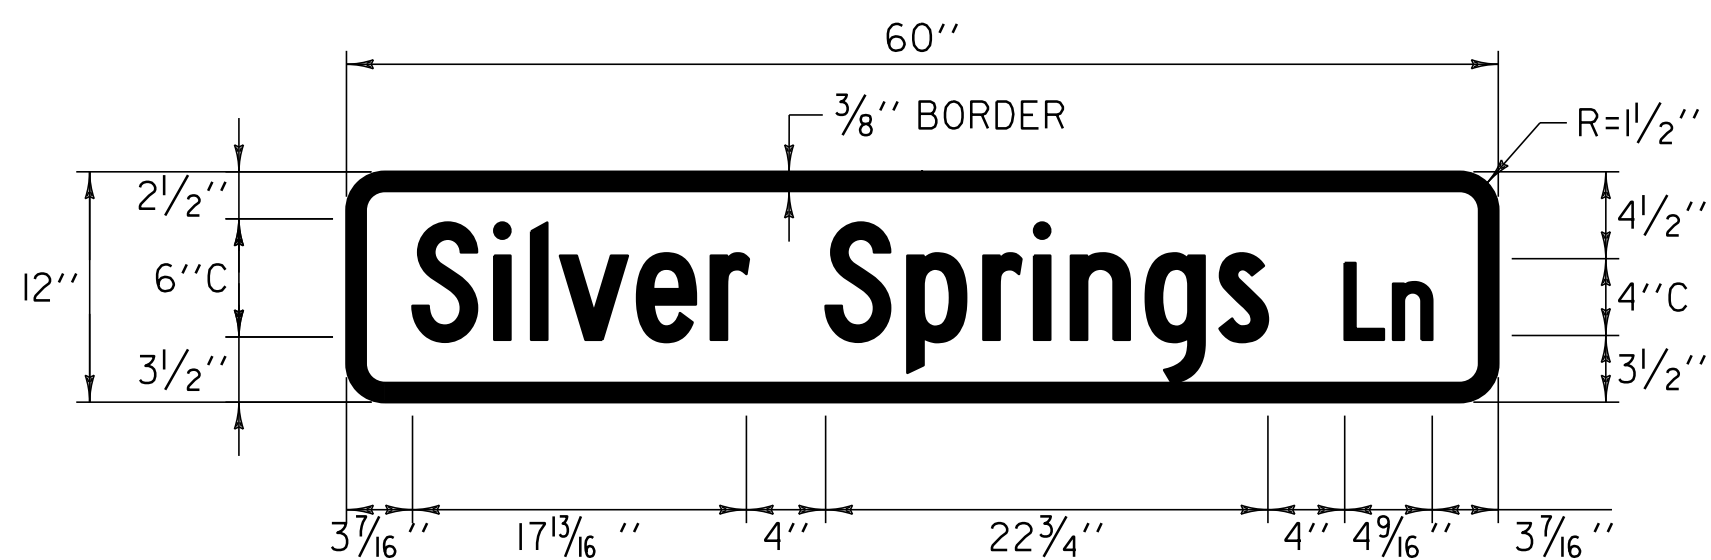

COLOR: WHITE BORDER & TEXT (REFLECTORIZED)  
GREEN BACKGROUND (REFLECTORIZED)

MATERIAL: PER VAOT STANDARD E-123


LOCATION: HISTORIC VT. ROUTE 7A  
MANCHESTER:  
STA 34+93.0, LT

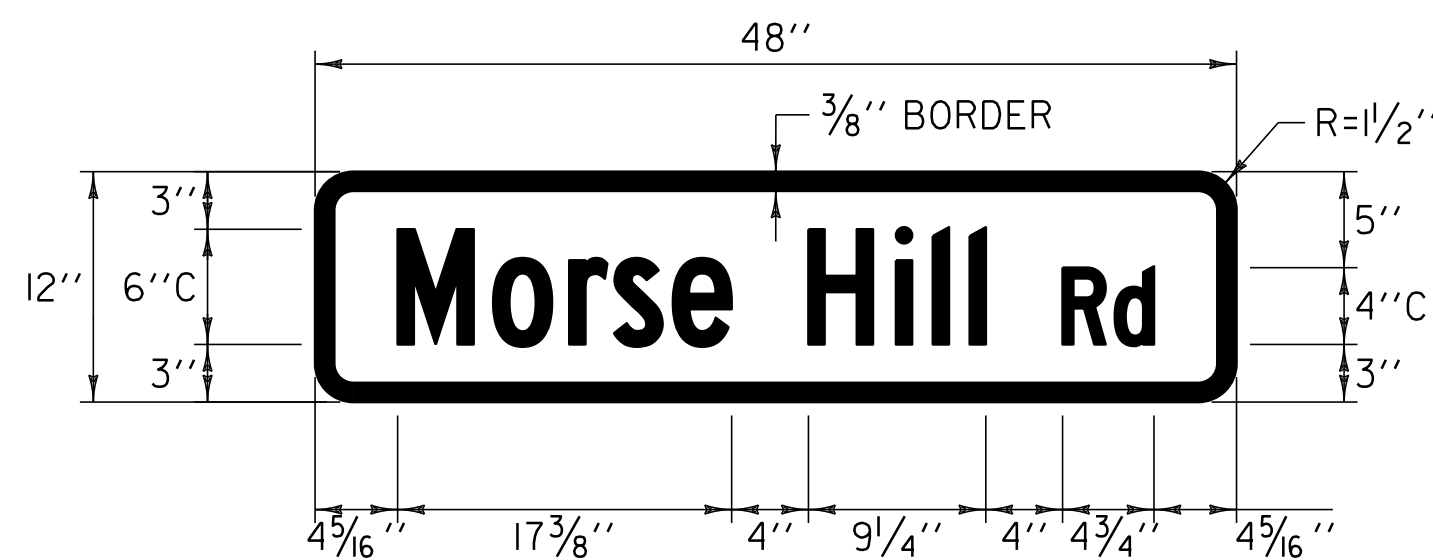

COLOR: WHITE BORDER & TEXT (REFLECTORIZED)  
GREEN BACKGROUND (REFLECTORIZED)

MATERIAL: PER VAOT STANDARD E-123


LOCATION: HISTORIC VT. ROUTE 7A  
DORSET:  
STA 70+62.0, LT

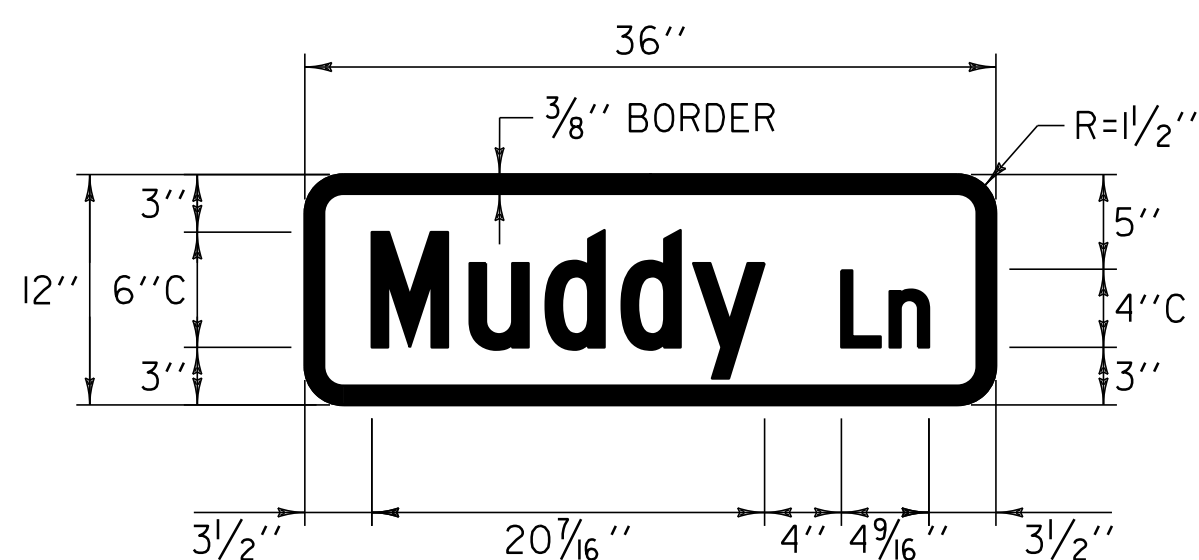

COLOR: WHITE BORDER & TEXT (REFLECTORIZED)  
GREEN BACKGROUND (REFLECTORIZED)

MATERIAL: PER VAOT STANDARD E-123

LOCATION: HISTORIC VT. ROUTE 7A  
MANCHESTER:  
STA 52+35.0, RT

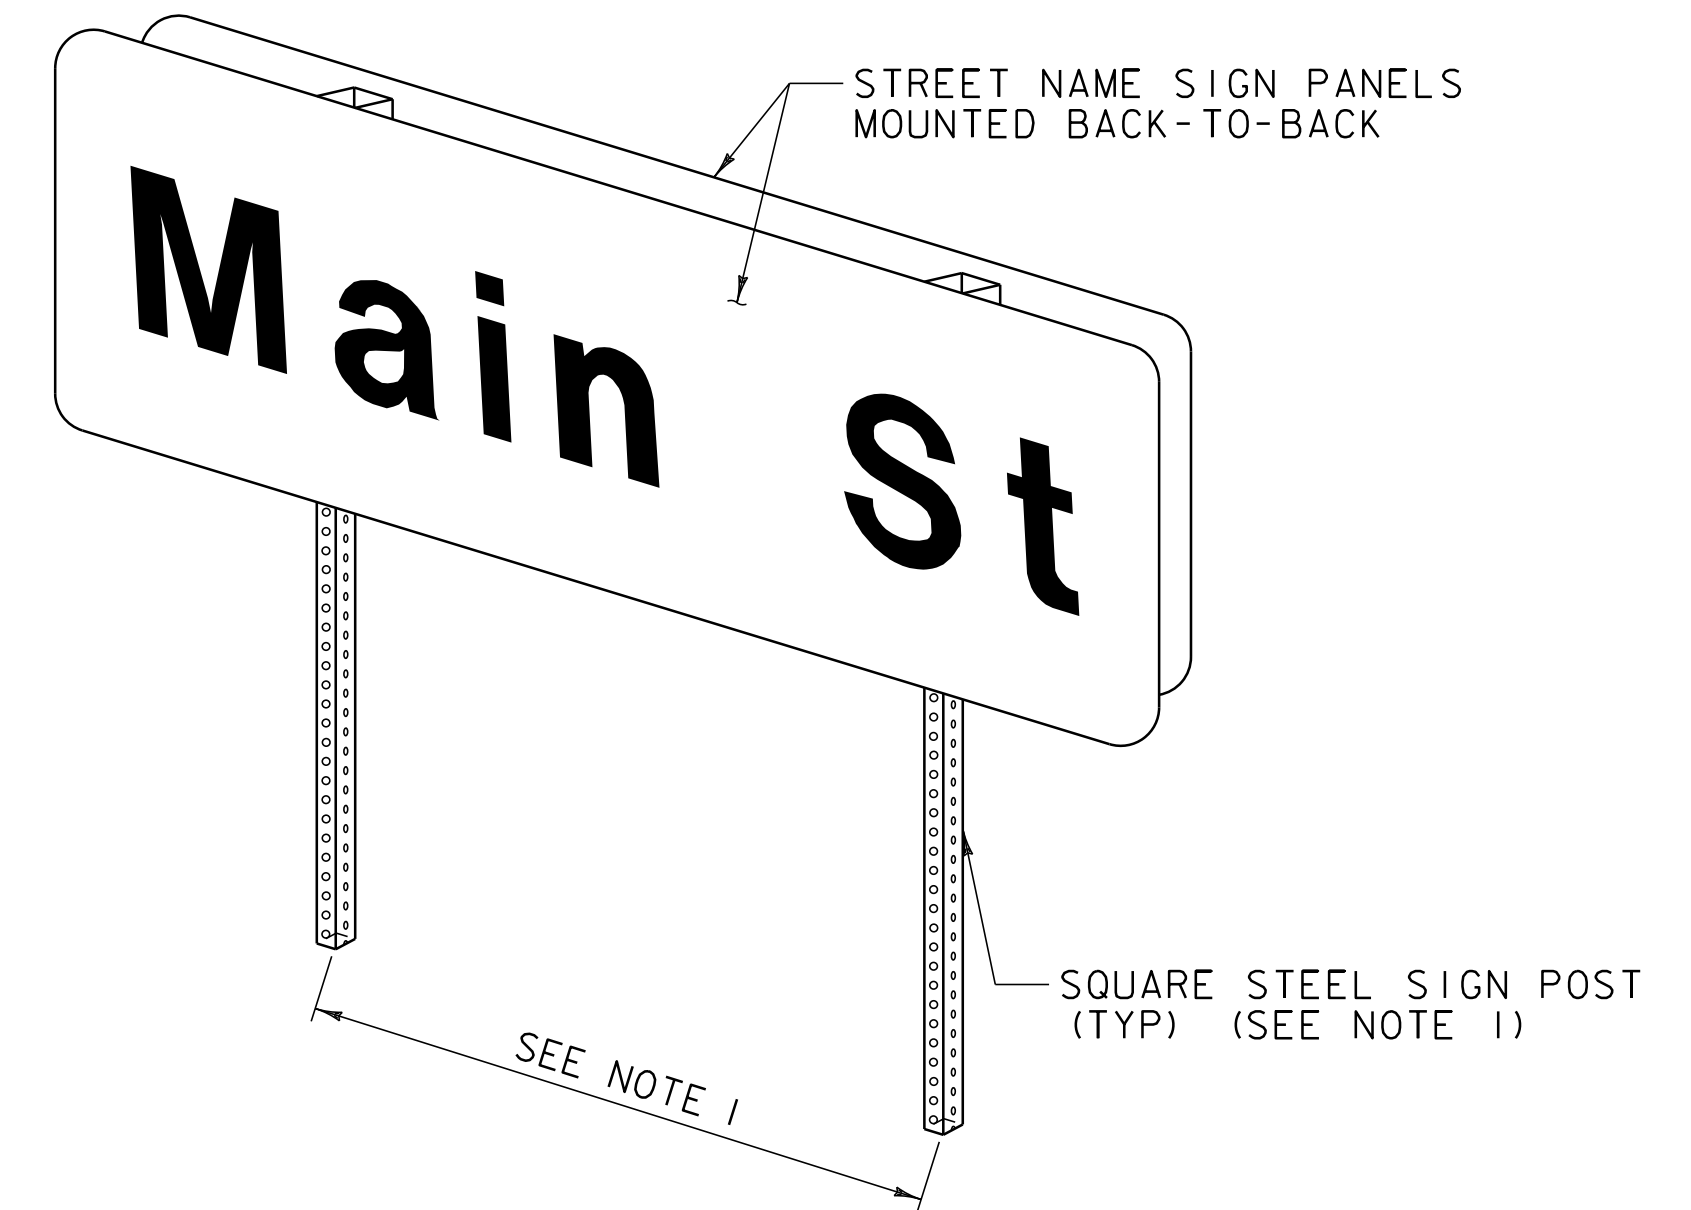

**TWO POST STREET NAME SIGN INSTILLATION  
FOR STREET NAME > 48"**

NOTE:

1. SEE VAOT STD E-164 FOR SQUARE STEEL SIGN  
POST DETAILS & POST SPACING REQUIREMENTS.

**NOT TO SCALE**

**TRAFFIC  
SIGN  
DETAILS  
SHEET #2**

PROJECT NAME: ARLINGTON-DORSET

PROJECT NUMBER: STP 2625(1)

FILE NAME: p06c218.dgn

PROJECT LEADER: D.E.G.

DESIGNED BY: D.W.E.

IPARM FILE: p06c218+sd.i

PLOT DATE: \$DATE\$

DRAWN BY: C.A.K.

CHECKED BY: M.J.L.

SHEET 132 OF 143

ALL SIGNS SIZES WERE INSTALLED PER  
PLAN. SEE LAYOUT SHEETS FOR LOCATIONS