


COLOR: WHITE BORDER & TEXT (REFLECTORIZED)
GREEN BACKGROUND (REFLECTORIZED)

MATERIAL: PER VAOT STANDARD E-I23


LOCATION: HISTORIC VT. ROUTE 7A
ARLINGTON:
STA 203+59.0, LT

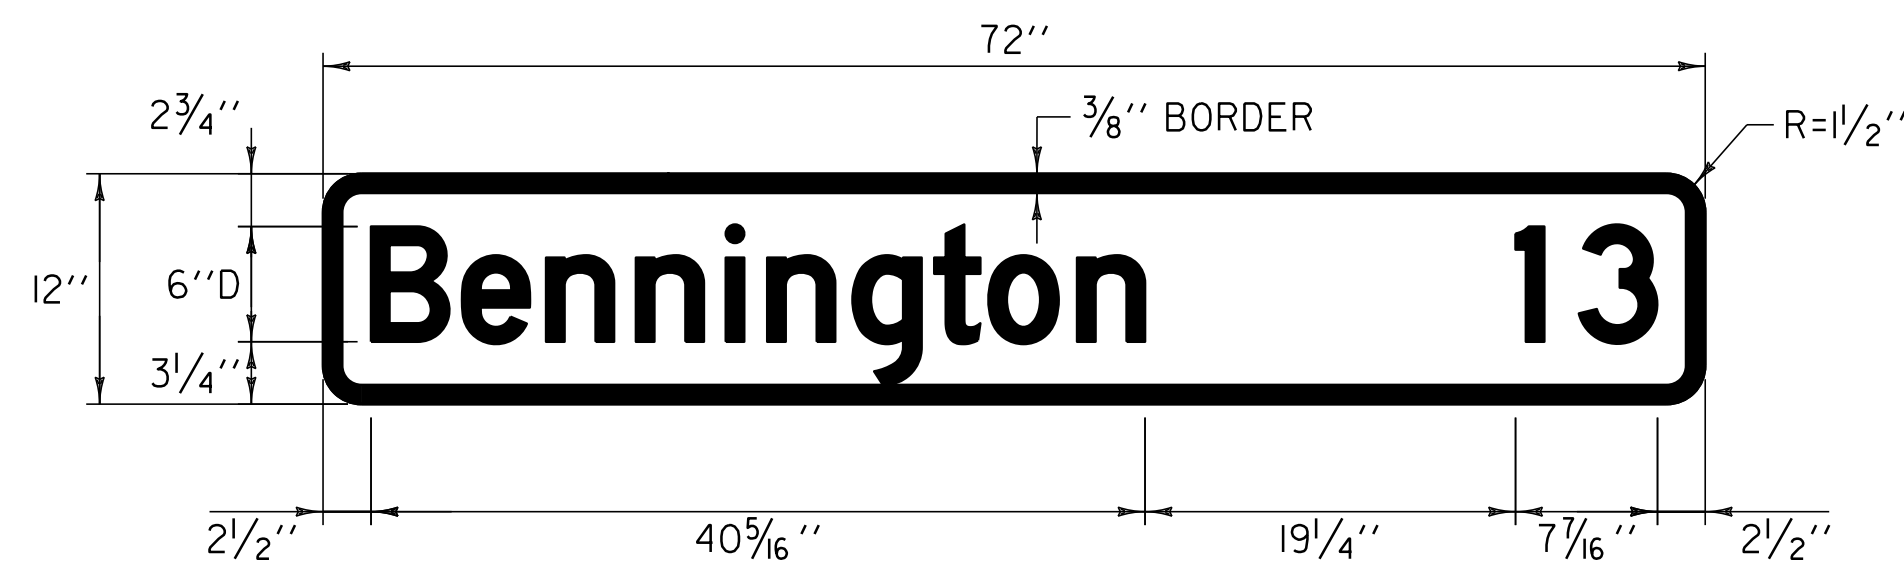

COLOR: WHITE BORDER & TEXT (REFLECTORIZED)
GREEN BACKGROUND (REFLECTORIZED)

MATERIAL: PER VAOT STANDARD E-I23


LOCATION: HISTORIC VT. ROUTE 7A
ARLINGTON:
STA 203+59.0, LT

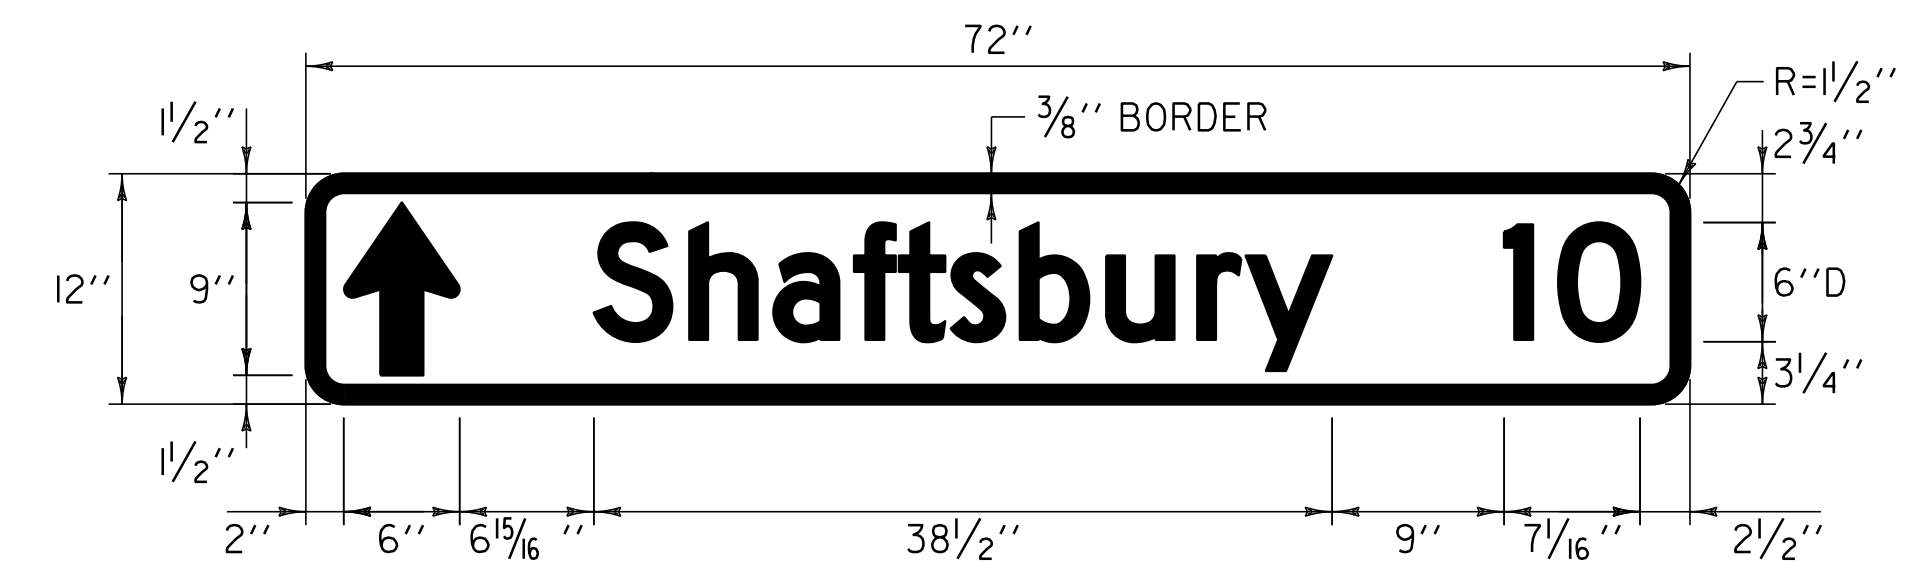

COLOR: WHITE BORDER & TEXT (REFLECTORIZED)
GREEN BACKGROUND (REFLECTORIZED)

MATERIAL: PER VAOT STANDARD E-I23


LOCATION: HISTORIC VT. ROUTE 7A
ARLINGTON:
STA 207+50.0, LT

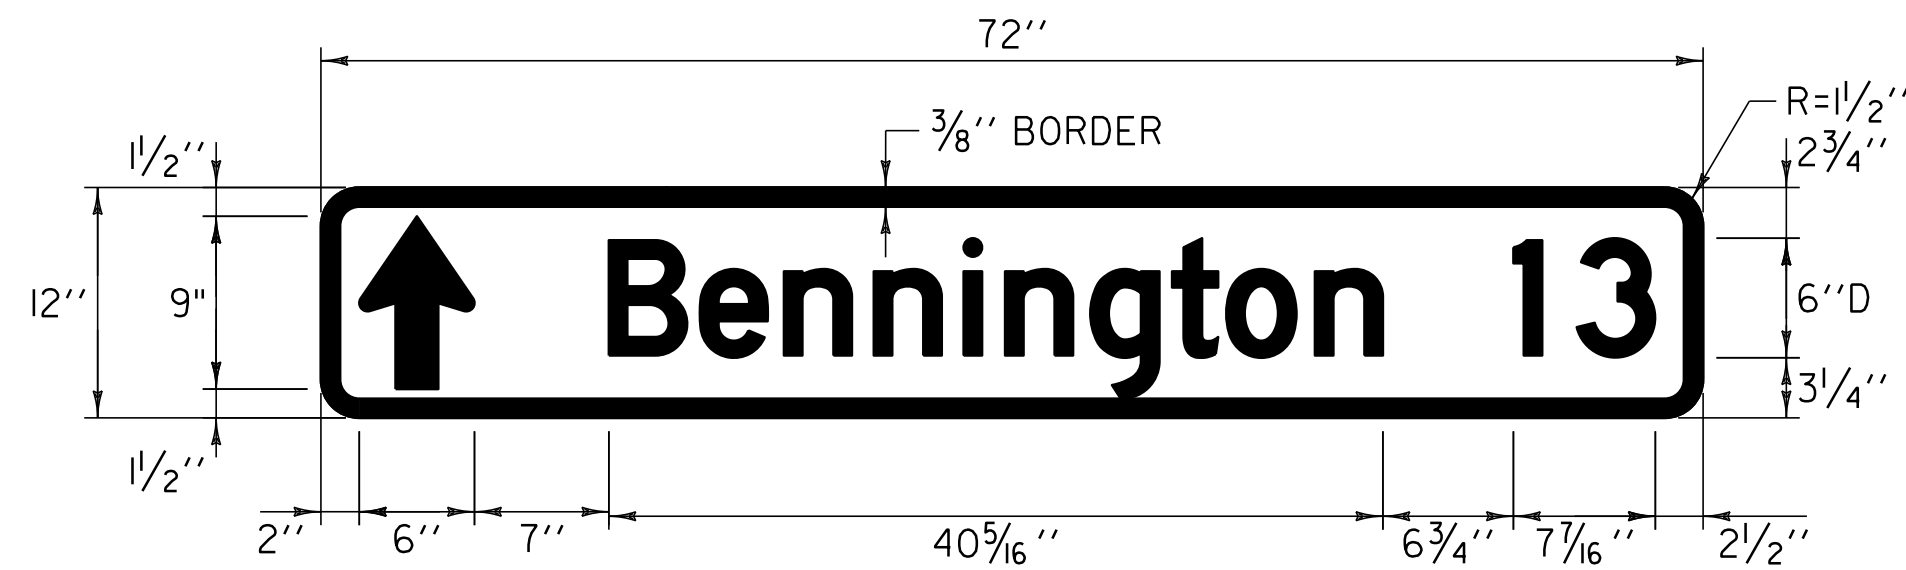

WHITE BORDER & TEXT (REFLECTORIZED)
GREEN BACKGROUND (REFLECTORIZED)

PER VAOT STANDARD E-I23


HISTORIC VT. ROUTE 7A
ARLINGTON:
STA 207+50.0, LT

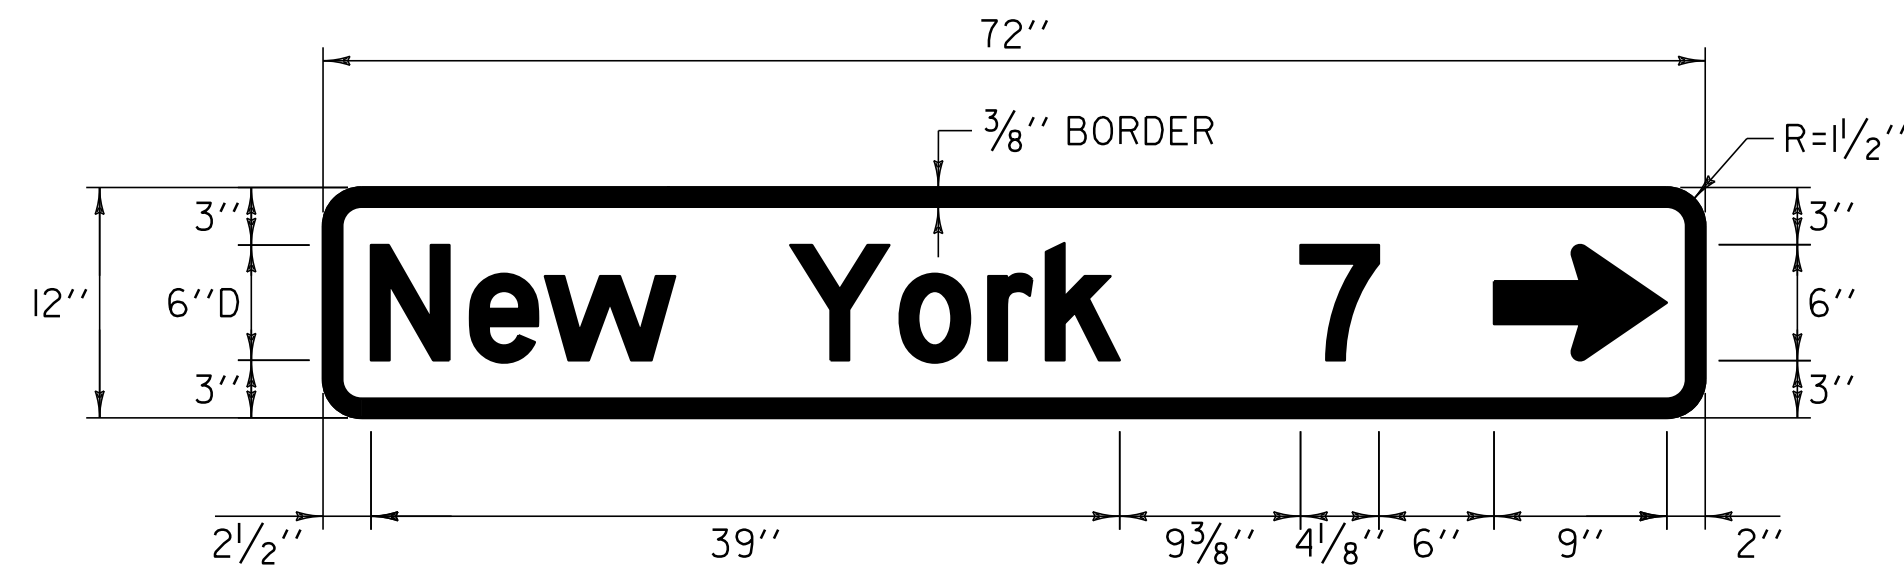

COLOR: WHITE BORDER & TEXT (REFLECTORIZED)
GREEN BACKGROUND (REFLECTORIZED)

MATERIAL: PER VAOT STANDARD E-I23


LOCATION: HISTORIC VT. ROUTE 7A
ARLINGTON:
STA 207+50.0, LT

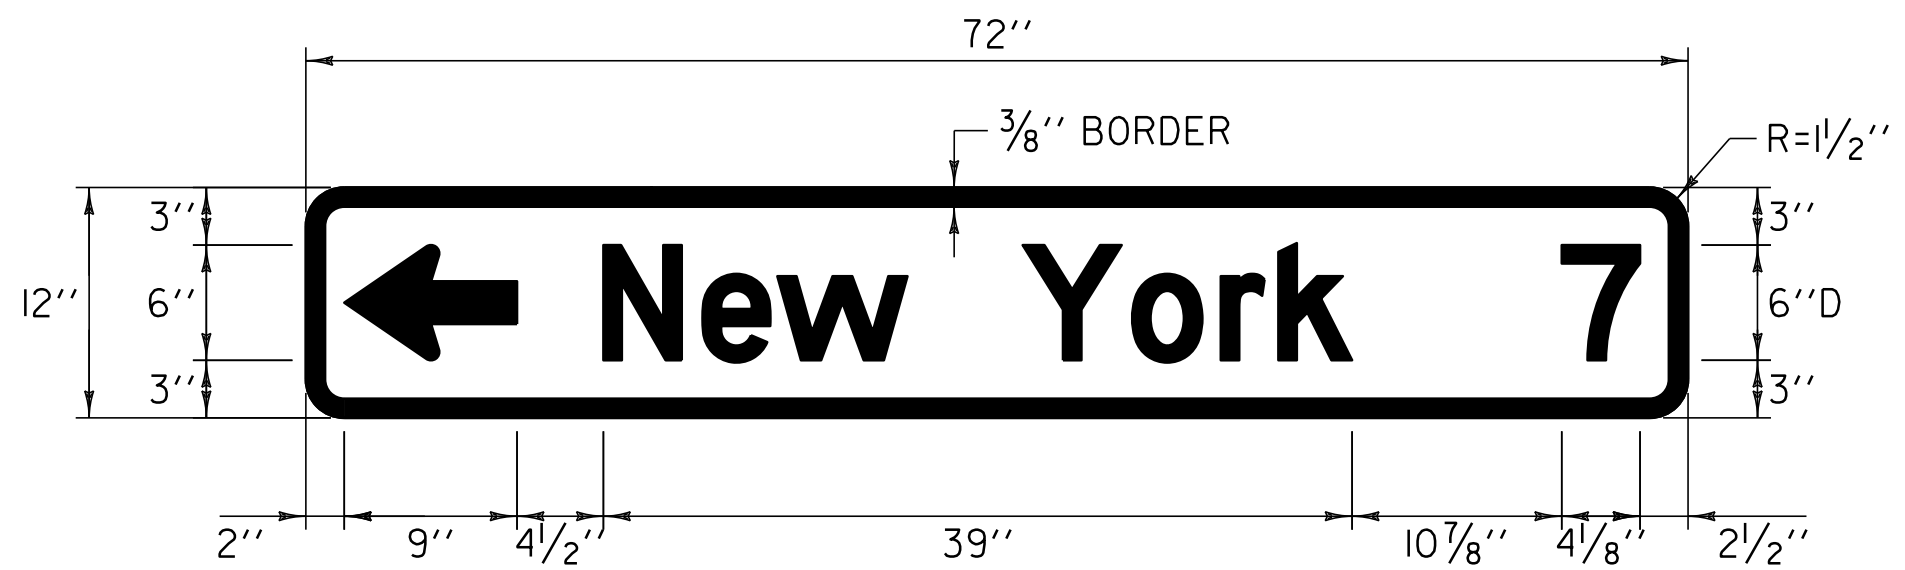

COLOR: WHITE BORDER & TEXT (REFLECTORIZED)
GREEN BACKGROUND (REFLECTORIZED)

MATERIAL: PER VAOT STANDARD E-I23


LOCATION: HISTORIC VT. ROUTE 7A
ARLINGTON:
STA 204+25.0, RT

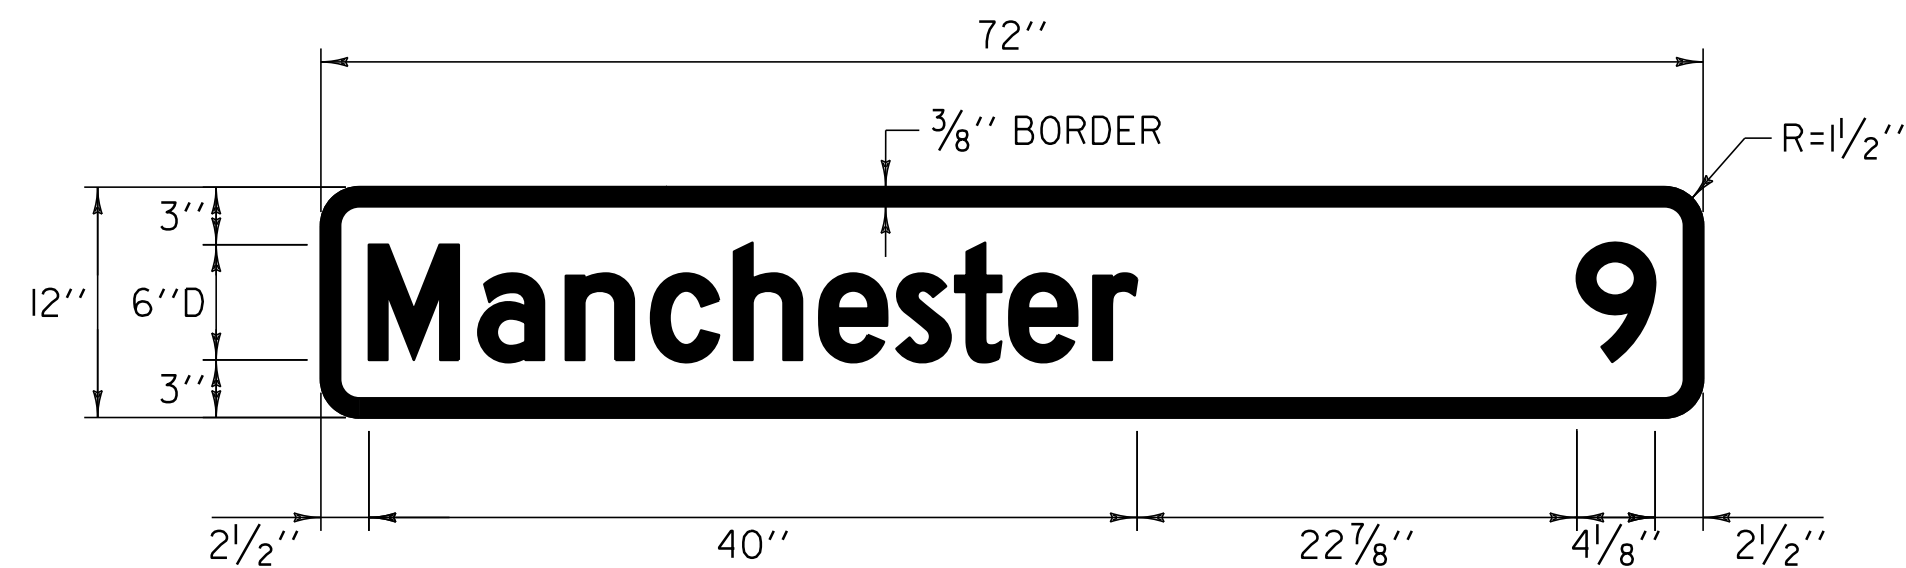

COLOR: WHITE BORDER & TEXT (REFLECTORIZED)
GREEN BACKGROUND (REFLECTORIZED)

MATERIAL: PER VAOT STANDARD E-I23


LOCATION: HISTORIC VT. ROUTE 7A
ARLINGTON:
STA 208+15.0, RT

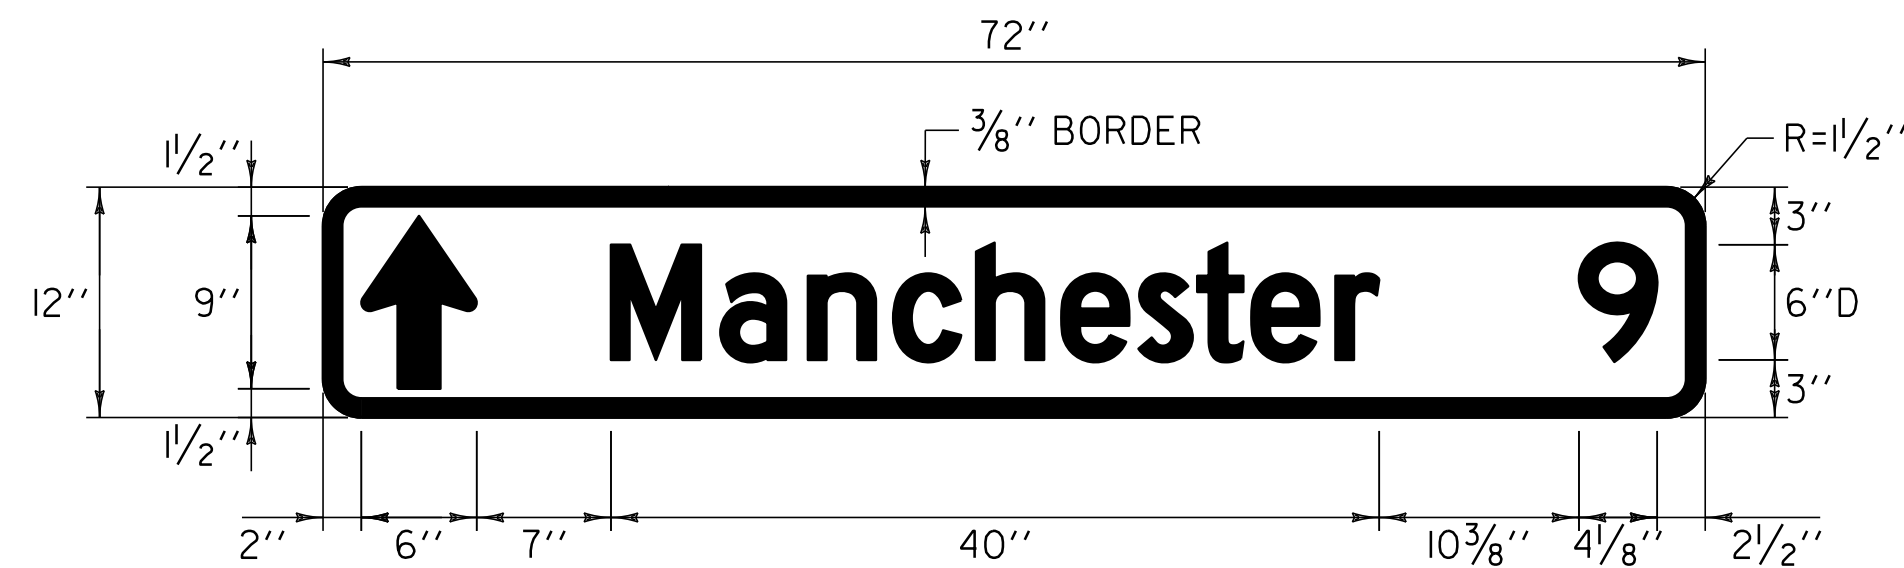

COLOR: WHITE BORDER & TEXT (REFLECTORIZED)
GREEN BACKGROUND (REFLECTORIZED)

MATERIAL: PER VAOT STANDARD E-I23

LOCATION: HISTORIC VT. ROUTE 7A
ARLINGTON:
STA 204+25.0, RT

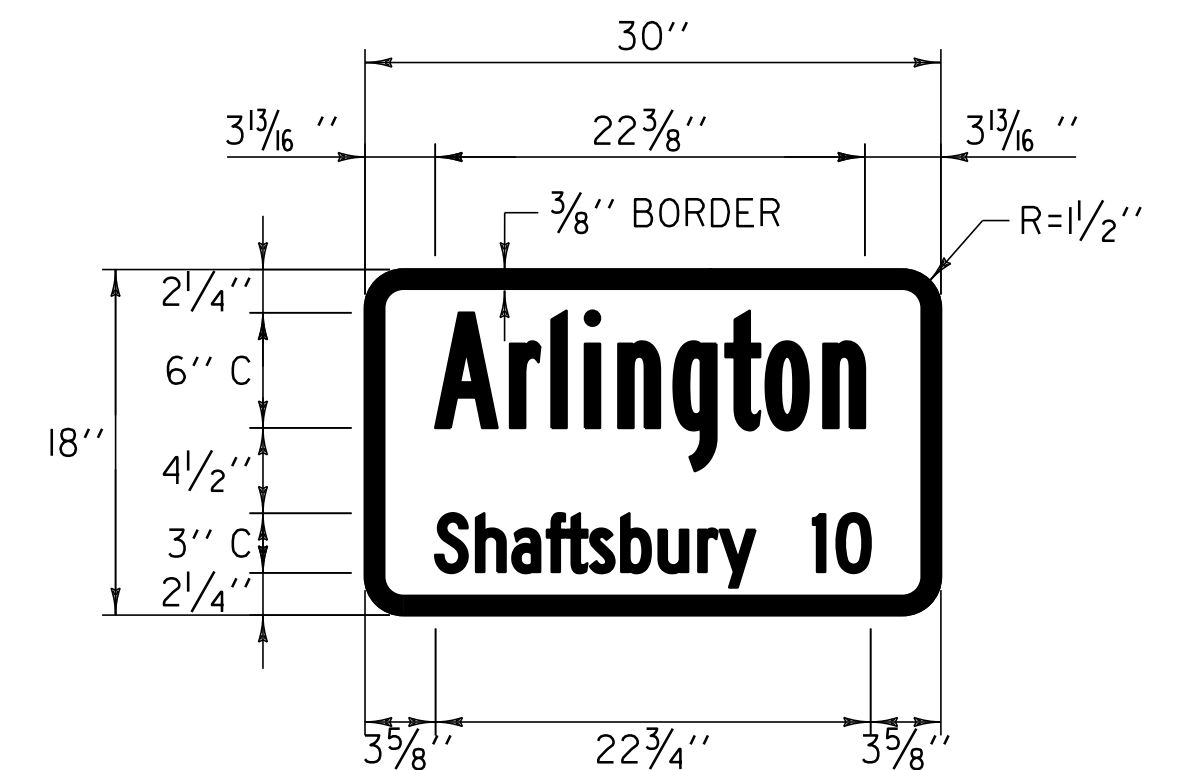

COLOR: WHITE BORDER & TEXT (REFLECTORIZED)
GREEN BACKGROUND (REFLECTORIZED)

MATERIAL: PER VAOT STANDARD E-I28A

LOCATION: HISTORIC VT. ROUTE 7A
ARLINGTON:
STA 219+00.0, LT

NOT TO SCALE

**TRAFFIC
SIGN
DETAILS
SHEET #3**

PROJECT NAME: ARLINGTON-DORSET

PROJECT NUMBER: STP 2625(1)

FILE NAME: p06c218.dgn

PROJECT LEADER: D.E.G.

DESIGNED BY: D.W.E.

IPARM FILE: p06c218+sd.i

PLOT DATE: \$DATE\$

DRAWN BY: C.A.K.

CHECKED BY: M.J.L.

SHEET 133 OF 143

ALL SIGNS SIZES WERE INSTALLED PER
PLAN. SEE LAYOUT SHEETS FOR LOCATIONS