

INDEX OF SHEETS

- 1 COMPOSITE TITLE SHEET
- 2-4 COMPOSITE QUANTITY SHEETS

COVENTRY-NEWPORT STP 2308(1) COVENTRY STATE HIGHWAY

- 5 TITLE SHEET
- 6 PROJECT TIE SHEET
- 7-9 PROJECT TYPICAL SHEETS I-3
- 10-12 QUANTITY SHEETS I-3
- 13 ITEM DETAIL SUMMARY SHEET
- 14 UNDERDRAIN DETAIL SHEET
- 15 DRIVE DETAIL SHEET
- 16&17 BRIDGE DETAIL SHEETS I&2
- 18 MISCELLANEOUS DETAIL SHEET
- 19 DITCH CLEANING DETAIL SHEET
- 20-32 PROJECT LAYOUT SHEETS I-13
- 33-36 TRAFFIC SIGN SUMMARY SHEETS I-4
- 37 TRAFFIC SIGN DETAIL SHEET
- 38-43 SUPERELEVATION BANKING TRANSITION DIAGRAM SHEETS I-6
- 44 HORIZONTAL ALIGNMENT TABLE SHEET
- 45-49 VERTICAL ALIGNMENT TABLE SHEETS I-5
- 50 PAVEMENT CORE AND TEST PIT DATA SHEET
- 51-102 CROSS SECTION SHEETS I-52
- 103 CONSTRUCTION APPROACH SIGNING SHEET

COVENTRY AV-FY13-001 NEWPORT STATE AIRPORT

- 104 TITLE SHEET
- 105 PROJECT TYPICAL SHEET
- 106 QUANTITY SHEET
- 107 PROJECT PLAN SHEET

STRUCTURES DETAIL SHEETS

SD-516.10 BRIDGE JOINT ASPHALTIC PLUG

VAOT STANDARDS

- B-1 06-01-94
- D-3 06-01-94
- E-100 01-02-04
- E-100A 01-02-04
- E-101 05-30-03
- E-102 06-30-03
- E-102A 05-01-04
- E-106 03-01-04
- E-107 06-30-03
- E-107A 06-08-09
- E-108 06-08-09
- E-108A 06-08-09
- E-110 08-08-95
- E-121 08-08-95
- E-123 03-16-04
- E-134 08-08-95
- E-138 05-30-03
- E-140 08-30-96
- E-141 09-20-95
- E-150 05-01-04
- E-151 05-01-04
- E-153 05-01-04
- E-164 06-08-09
- E-191 02-01-99
- E-192 10-12-00
- E-193 08-18-95
- G-1 01-03-2000
- G-1d 01-03-2000
- J-3 08-07-95

QUALITY ASSURANCE PROGRAM: **LEVEL 3**


CONVENTIONAL SYMBOLS

| | |
|--------------------|--|
| COUNTY LINE | |
| TOWN LINE | |
| LIMITS OF ACCESS | |
| POINT OF ACCESS | |
| FENCE LINE | |
| STONE WALL | |
| TRAVELED WAY | |
| GUARDRAIL | |
| RAILROAD | |
| SURVEY LINE | |
| CULVERT | |
| UTILITY POLE | |
| TREES | |
| CONTROL OF ACCESS | |
| PROPERTY LINE | |
| R.O.W. TAKING LINE | |
| SLOPE RIGHTS | |
| TOP OF CUT | |
| TOE OF SLOPE | |

SURVEYED BY : VERMONT SURVEY & ENGINEERING
 SURVEYED DATE : 2010

DATUM
 VERTICAL NAVD88
 HORIZONTAL NAD83 (2007)


STATE OF VERMONT
 AGENCY OF TRANSPORTATION

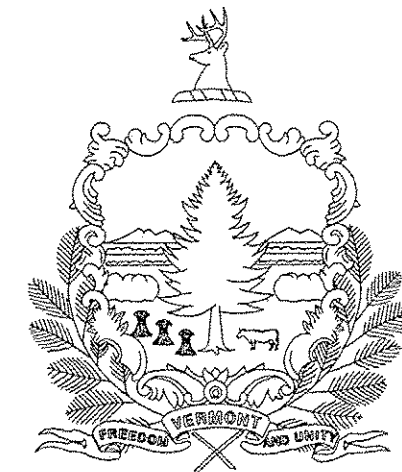


PROPOSED IMPROVEMENT
 TOWN OF COVENTRY & CITY OF NEWPORT
 COUNTY OF ORLEANS

**COVENTRY-NEWPORT CITY
 STP 2308(1)
 COVENTRY STATE HIGHWAY**
 SEE SHEET 5 OF 107

**COVENTRY
 AV-FY13-001
 NEWPORT STATE AIRPORT**
 SEE SHEET 104 OF 107

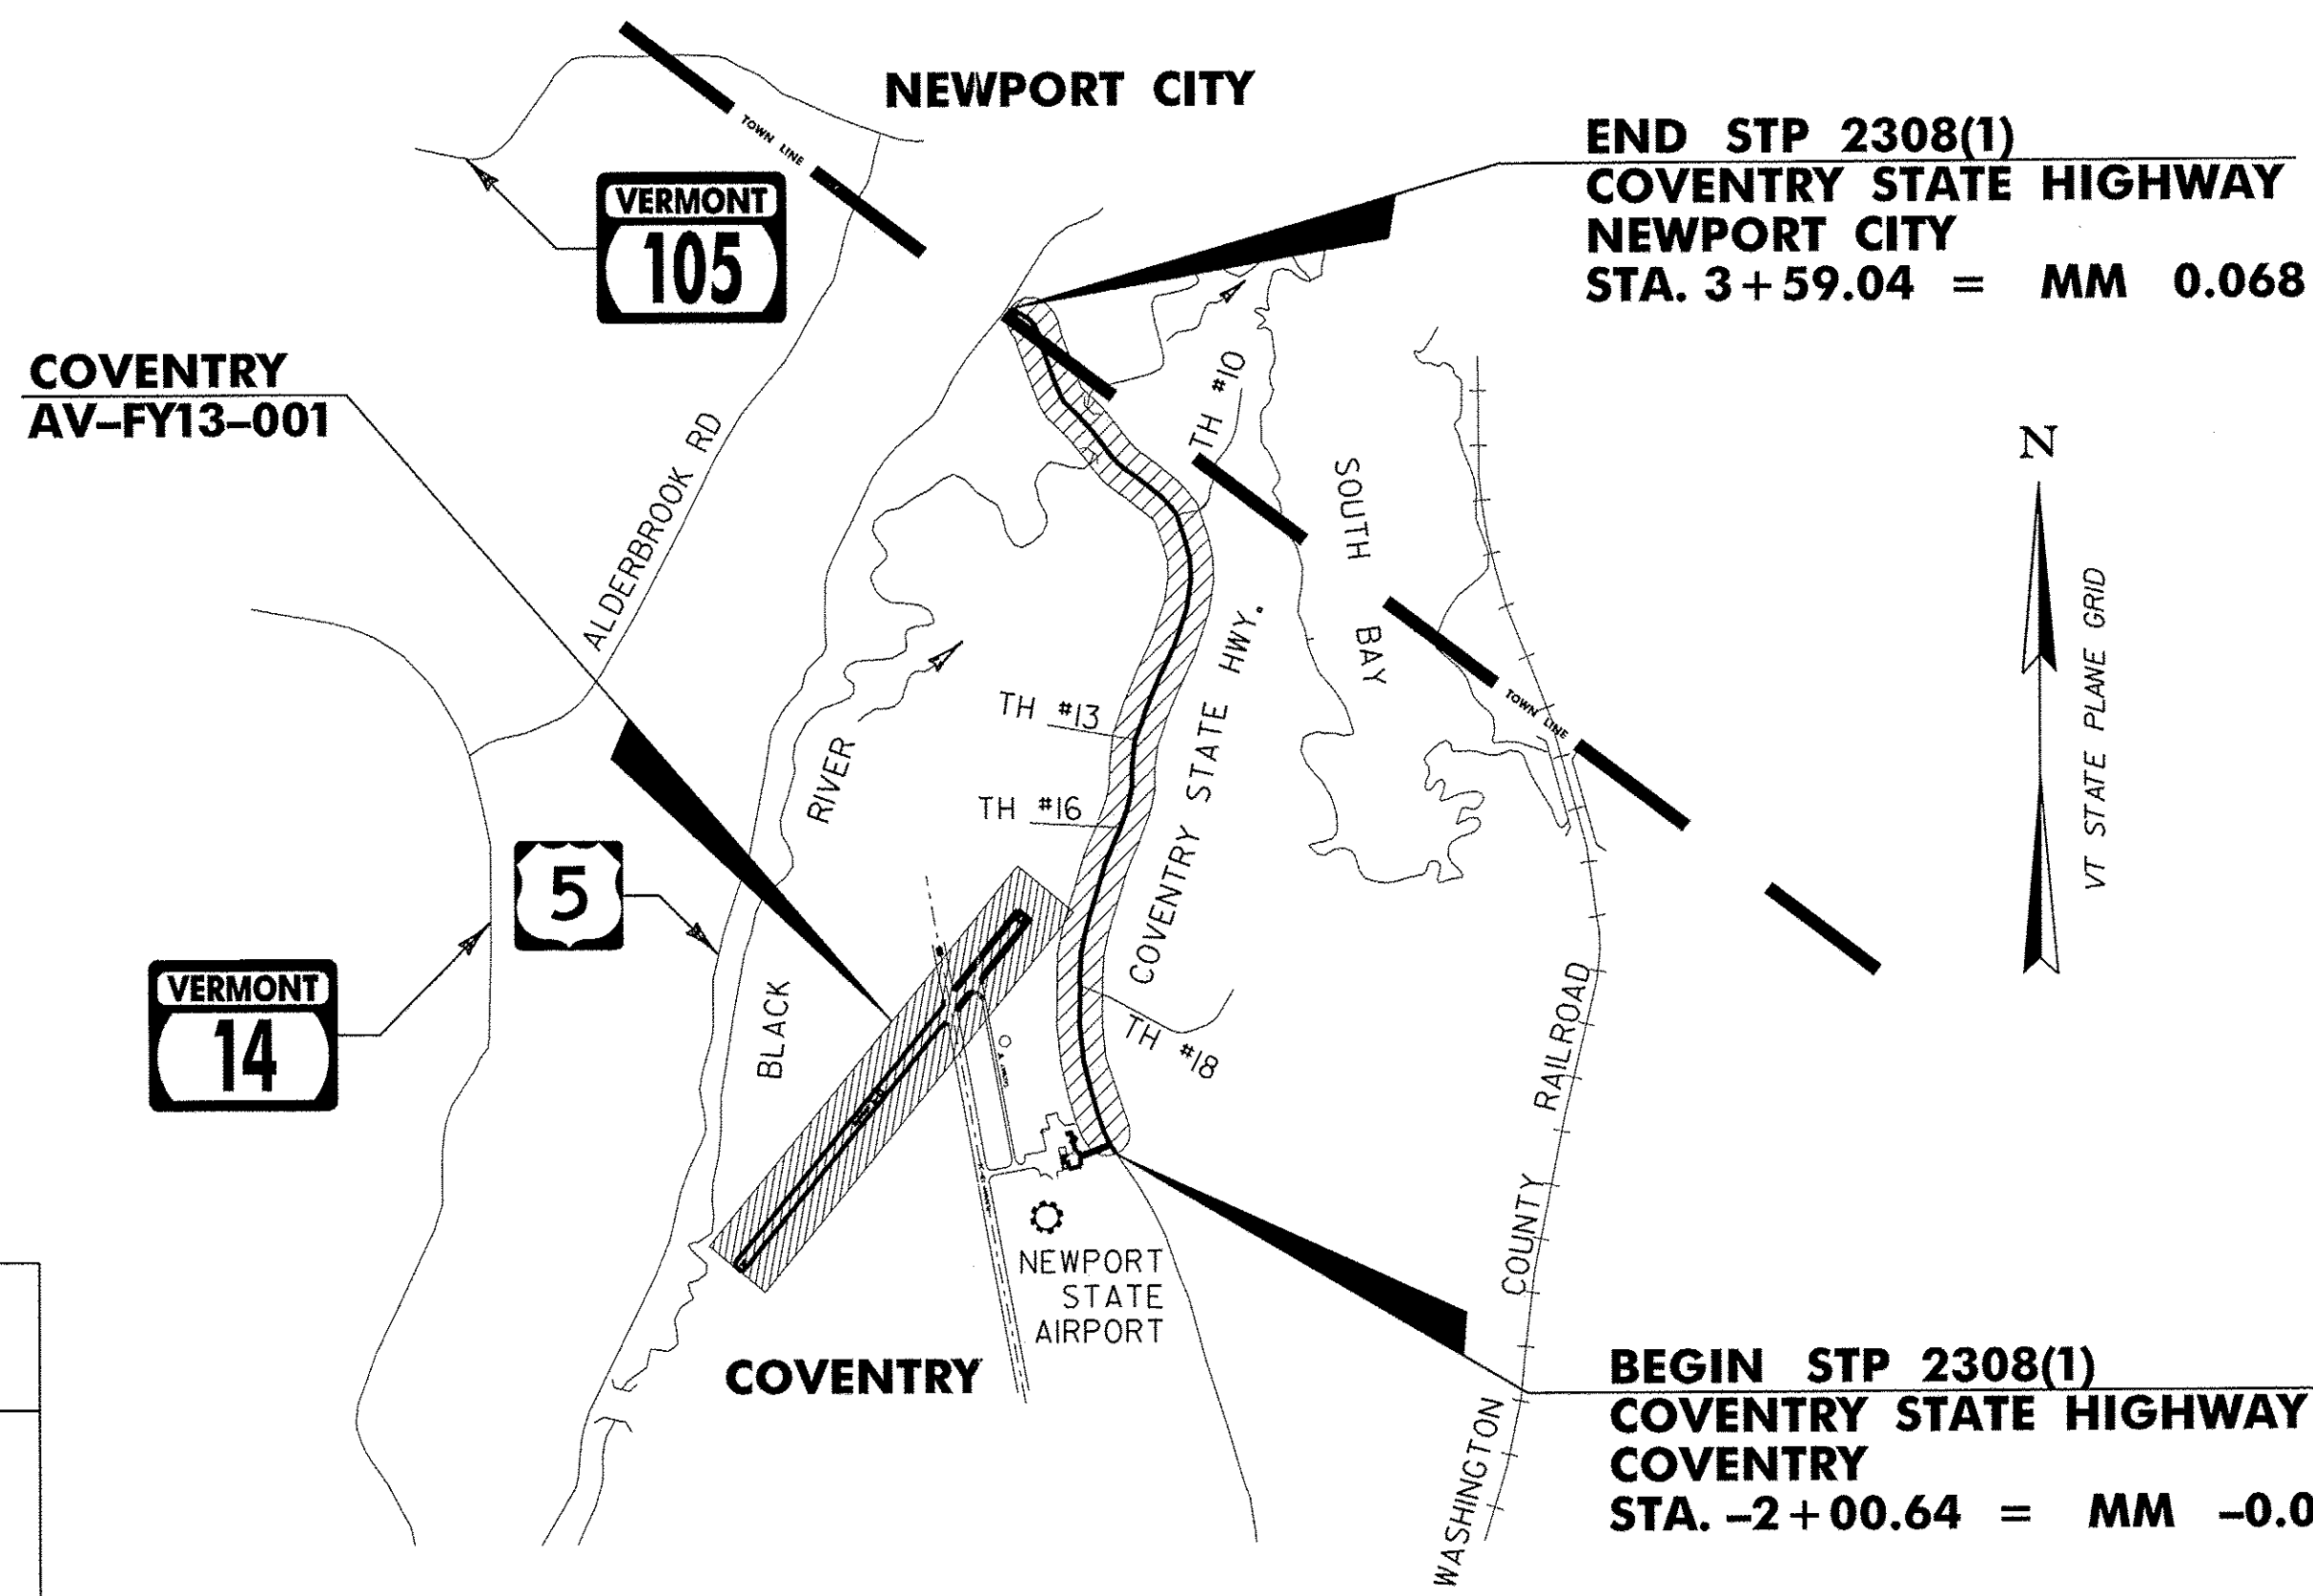

**COVENTRY-NEWPORT CITY
 STP 2308(1)
 AV-FY13-001**

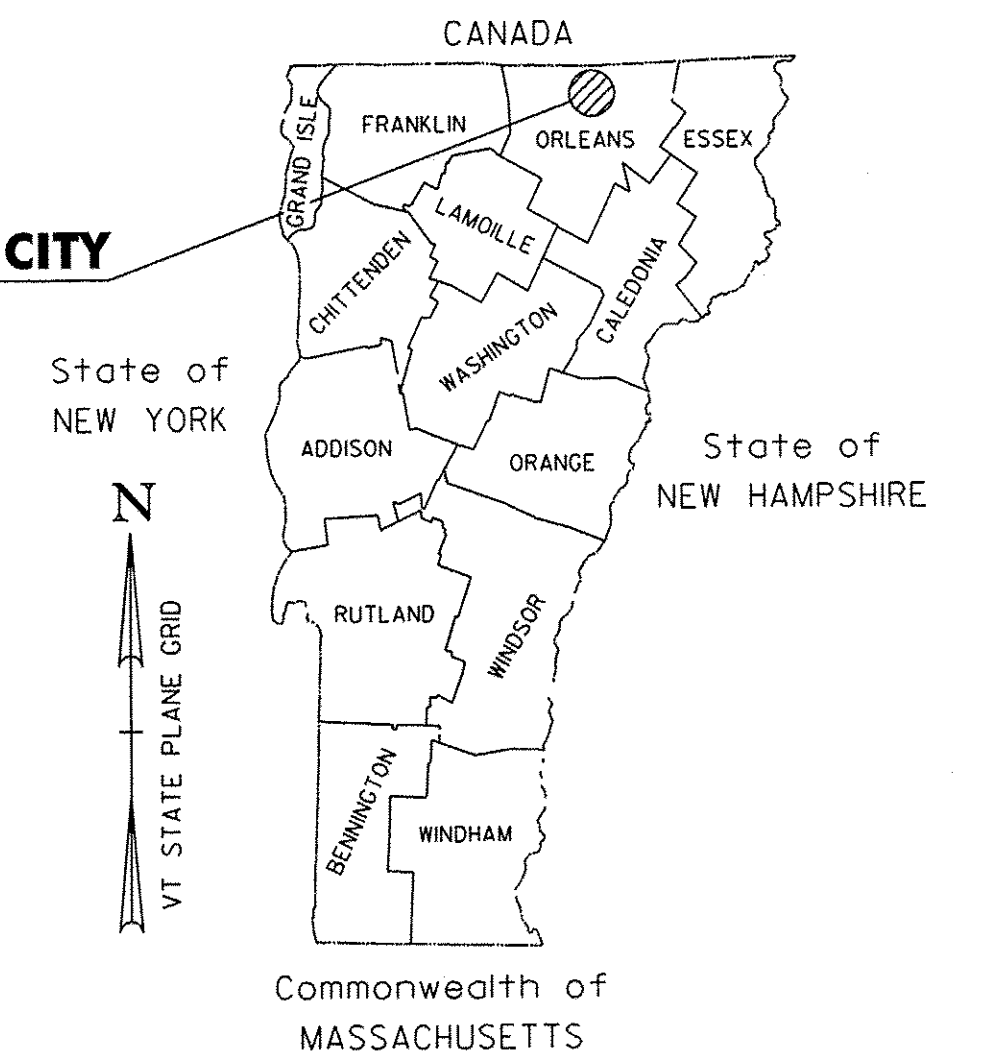

RECORD PLANS

| | |
|--|------------------------------------|
| CONTRACTOR: | PIKE INDUSTRIES, INC. - BERLIN, VT |
| RESIDENT ENGINEER: | JOHN SLADYK |
| CONSTRUCTION BEGAN: | AUGUST 6, 2012 |
| CONSTRUCTION COMPLETE: | OCTOBER 19, 2012 |
| RECORD PLANS BY: | JOHN SLADYK & JENNA HYDE |
| I HEREBY CERTIFY THAT ALL THE CONSTRUCTION REQUIRED BY THIS SET OF DRAWINGS HAS BEEN ACCOMPLISHED AS INDICATED HEREIN. | |
| BY: | RESIDENT ENGINEER |
| DATE: | 01-15-14 |

NOTE: Any further information concerning final quantities, amounts or other details relative to this project may be found at Central Files in the electronic archives.

RIGHT-OF-WAY LIMITS, IF APPLICABLE, ARE PROVIDED SOLELY FOR THE CONVENIENCE OF THE STATE AND ITS CONTRACTOR DURING THE COURSE OF THIS PAVING PROJECT. ANY REFERENCES TO OFFSETS IN THESE PLANS ARE APPROXIMATE AND SHOULD NOT BE RELIED UPON FOR ANY PURPOSES.

THESE PLANS ARE SUBJECT TO SUCH ENGINEERING CHANGES AS MAY BE REQUIRED BY THE FEDERAL HIGHWAY ADMINISTRATION OR THE DIRECTOR OF PROGRAM DEVELOPMENT.

CONSTRUCTION IS TO BE CARRIED ON IN ACCORDANCE WITH THESE PLANS AND THE STANDARD SPECIFICATIONS FOR CONSTRUCTION DATED 2006, AS APPROVED BY THE FEDERAL HIGHWAY ADMINISTRATION ON JUNE 15, 2006 FOR USE ON THIS PROJECT, INCLUDING ALL SUBSEQUENT REVISIONS AND SUCH REVISED SPECIFICATIONS AND SPECIAL PROVISIONS AS ARE INCORPORATED IN THESE PLANS.

UNLESS OTHERWISE NOTED, ALL DRAWINGS AND DETAILS ON THESE PLANS ARE DRAWN "NOT TO SCALE".

| | |
|---------------------------------|--------------------------------|
| DIRECTOR OF PROGRAM DEVELOPMENT | |
| APPROVED | DATE 5-16-12 |
| PROJECT MANAGER : | MICHAEL FOWLER |
| PROJECT NAME: | COVENTRY-NEWPORT CITY/COVENTRY |
| PROJECT NUMBER : | STP 2308 (1) , AV-FY13-001 |
| SHEET 1 OF 107 SHEETS | |