

RECLAMATION / COLD PLANING TRANSITION DETAIL AT BRIDGE #1

COVENTRY STA. 118+14.63 TO 119+64.63
 COVENTRY STA. 121+08.21 TO 122+58.21

SEEDING FORMULA

RATE: DOUBLE IF HYDROSEEDING

% WT.	LBS./A.	NAME	PUR %	GERM %
38	32	CREEPING RED FESCUE	98	90
29	24	SPARTAN HARD FESCUE	95	85
15	12	AZAY SHEEP'S FESCUE	95	87
15	12	ANNUAL RYE GRASS	95	90
3	--	INERTS	--	--
100.0	80 LB/A			

NOTES

SEED MIXTURE: SHALL NOT HAVE A WEED CONTENT EXCEEDING 0.40% BY WEIGHT AND SHALL BE FREE OF ALL NOXIOUS SEED.


SEED ITEM 651.15: TO BE APPLIED PER SEEDING FORMULAS OR AS DIRECTED BY THE RESIDENT ENGINEER.

FERTILIZER ITEM 651.18: FORMULA 10-20-10, TO BE USED WITH SEED, APPLIED AT THE RATE OF 500 LBS./ACRE. (HYDRO SEEDERS MAY USE 19-19-19 FORMULA)

AGRICULTURAL LIMESTONE ITEM 651.20: TO BE APPLIED AT THE RATE OF 2 TONS/ACRE, OR AS DIRECTED BY THE RESIDENT ENGINEER.

HAY MULCH ITEM 651.25: TO BE PLACED ON THE EARTH SLOPES AT THE RATE OF 2 TONS/ACRE, OR AS DIRECTED BY THE RESIDENT ENGINEER.

TOPSOIL ITEM 651.35: TO BE USED WITH SEED AS INDICATED ON THE PLANS, OR AS DIRECTED BY THE RESIDENT ENGINEER.

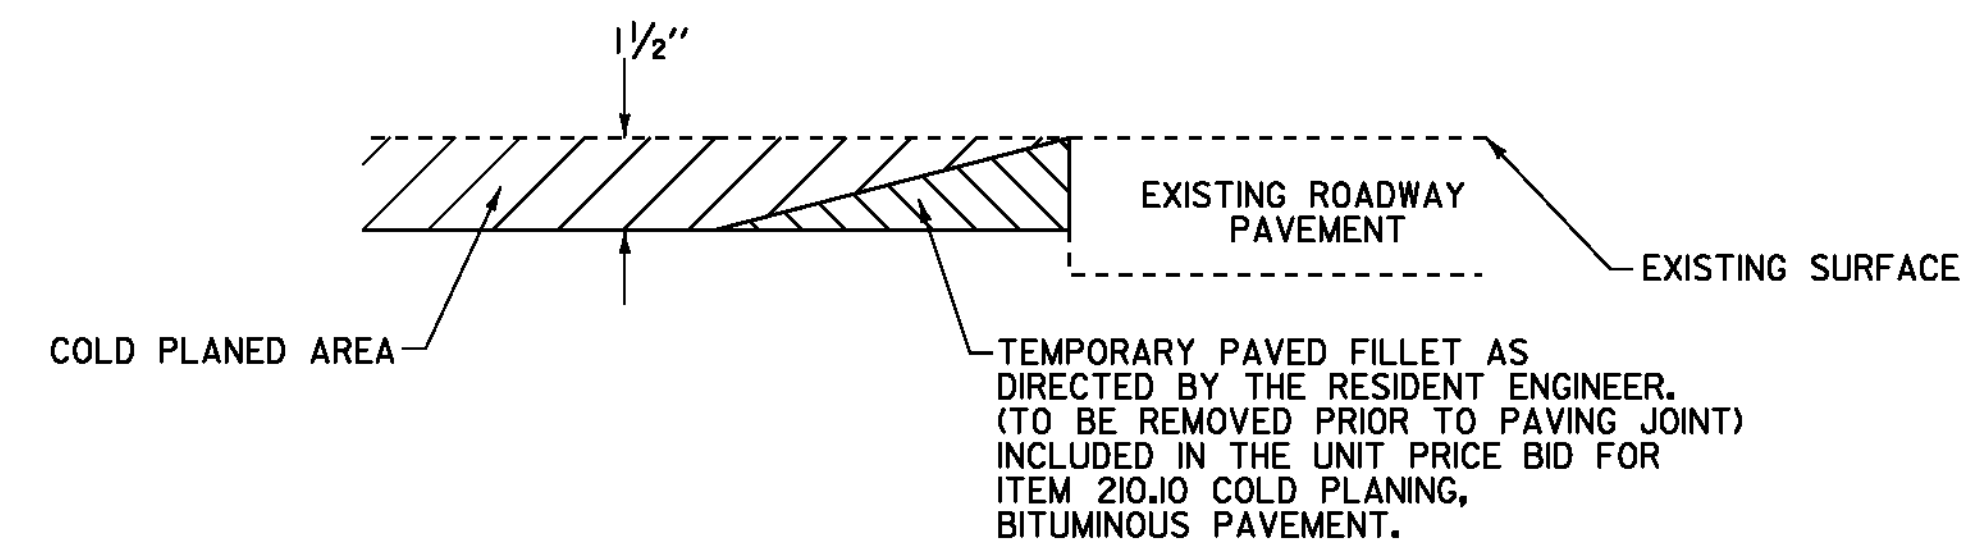

DETAIL AT VERTICAL COLD PLANE JOINTS (1 1/2" DEPTH)

FULL ROADWAY WIDTH

COVENTRY STA. -2+00.64 (BEGIN PROJECT)
 NEWPORT CITY STA. 3+59.04 (END PROJECT)



NOT TO SCALE

**PROJECT
TYPICAL
SHEET #3**

PROJECT NAME: COVENTRY-NEWPORT CITY

PROJECT NUMBER: STP 2308(I)

FILE NAME: p01c052.dgn

PROJECT LEADER: JLL

DESIGNED BY: STANTEC

IPARM FILE: p01c052pts03.1

PLOT DATE: 18-MAY-2012

DRAWN BY: STANTEC

CHECKED BY: STANTEC

SHEET 9 OF 107