
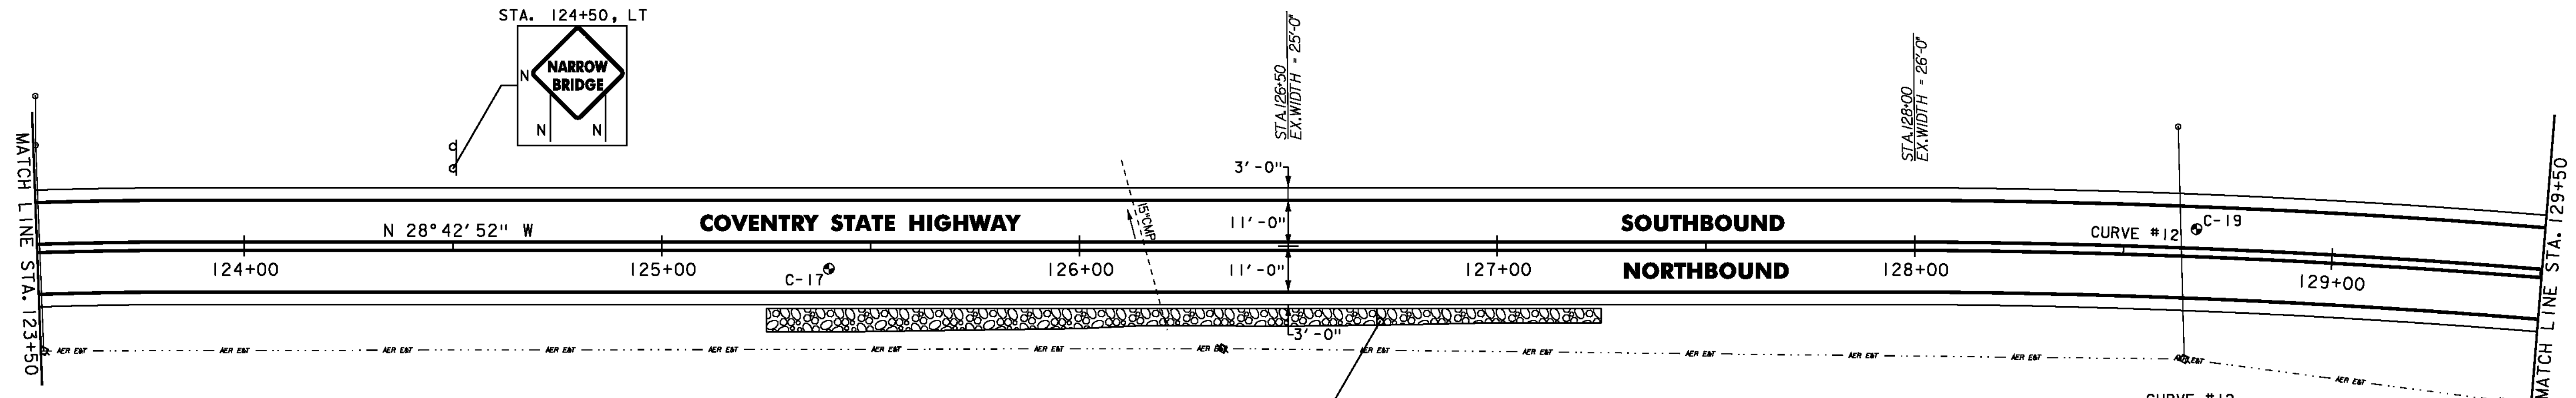


DURABLE 4 INCH WHITE LINE
 (ALL LINES WILL INCLUDE EDGE LINE BREAKS AND
 RADII FOR SIDE ROADS)
 STA. 123+50 TO 129+50, SOLID LT & RT

TEMPORARY 4 INCH WHITE LINE, PAINT
 (ALL LINES WILL INCLUDE EDGE LINE BREAKS AND
 RADII FOR SIDE ROADS)
 STA. 123+50 TO 129+50, SOLID LT & RT

DURABLE 4 INCH YELLOW LINE
 (ALL LINES WILL INCLUDE C BREAKS FOR SIDE ROADS)
 STA. 123+50 TO 129+50, SOLID LT & RT

TEMPORARY 4 INCH YELLOW LINE, PAINT
 (ALL LINES WILL INCLUDE C BREAKS FOR SIDE ROADS)
 STA. 123+50 TO 129+50, SOLID LT & RT

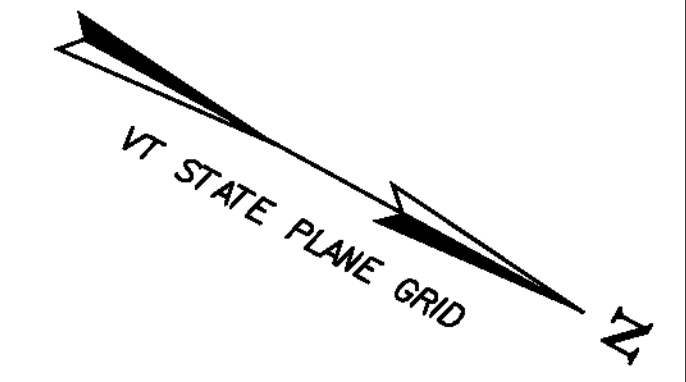

CURVE #12
 PC = 127+87.72
 PT = 130+64.71
 R = 2000'
 $\Delta = 7^\circ 56' 07''$, RT
 $D = 2^\circ 51' 53''$
 $e = 5.1\%$
 $L = 276.99'$
 SEE SHEET 42.

PAVEMENT CORE DATA			
CORE#	DEPTH (FT.)	PCC	COMMENTS
C-17	9"	NO	
C-19	5"	NO	BOTTOM 1" STRIPPED

DURABLE 4 INCH WHITE LINE
 (ALL LINES WILL INCLUDE EDGE LINE BREAKS AND
 RADII FOR SIDE ROADS)
 COVENTRY STA. 129+50 TO NEWPORT CITY STA. 1+00, SOLID LT & RT

DURABLE LETTER OR SYMBOL
 COVENTRY STA. 129+85, RT "STOP"
 COVENTRY STA. 130+25, RT "AHEAD"

TEMPORARY 4 INCH YELLOW LINE, PAINT
 (ALL LINES WILL INCLUDE C BREAKS FOR SIDE ROADS)
 COVENTRY STA. 129+50 TO NEWPORT CITY STA. 1+00, SOLID LT & RT


DURABLE 4 INCH YELLOW LINE
 (ALL LINES WILL INCLUDE C BREAKS FOR SIDE ROADS)
 COVENTRY STA. 129+50 TO NEWPORT CITY STA. 1+00, SOLID LT & RT

TEMPORARY 4 INCH WHITE LINE, PAINT
 (ALL LINES WILL INCLUDE EDGE LINE BREAKS AND
 RADII FOR SIDE ROADS)
 COVENTRY STA. 129+50 TO NEWPORT CITY STA. 1+00, SOLID LT & RT

TEMPORARY LETTER OR SYMBOL, PAINT
 COVENTRY STA. 129+85, RT "STOP"
 COVENTRY STA. 130+25, RT "AHEAD"

REMOVING SIGNS
 AS SHOWN - 3

GRAVEL
 DRIVE

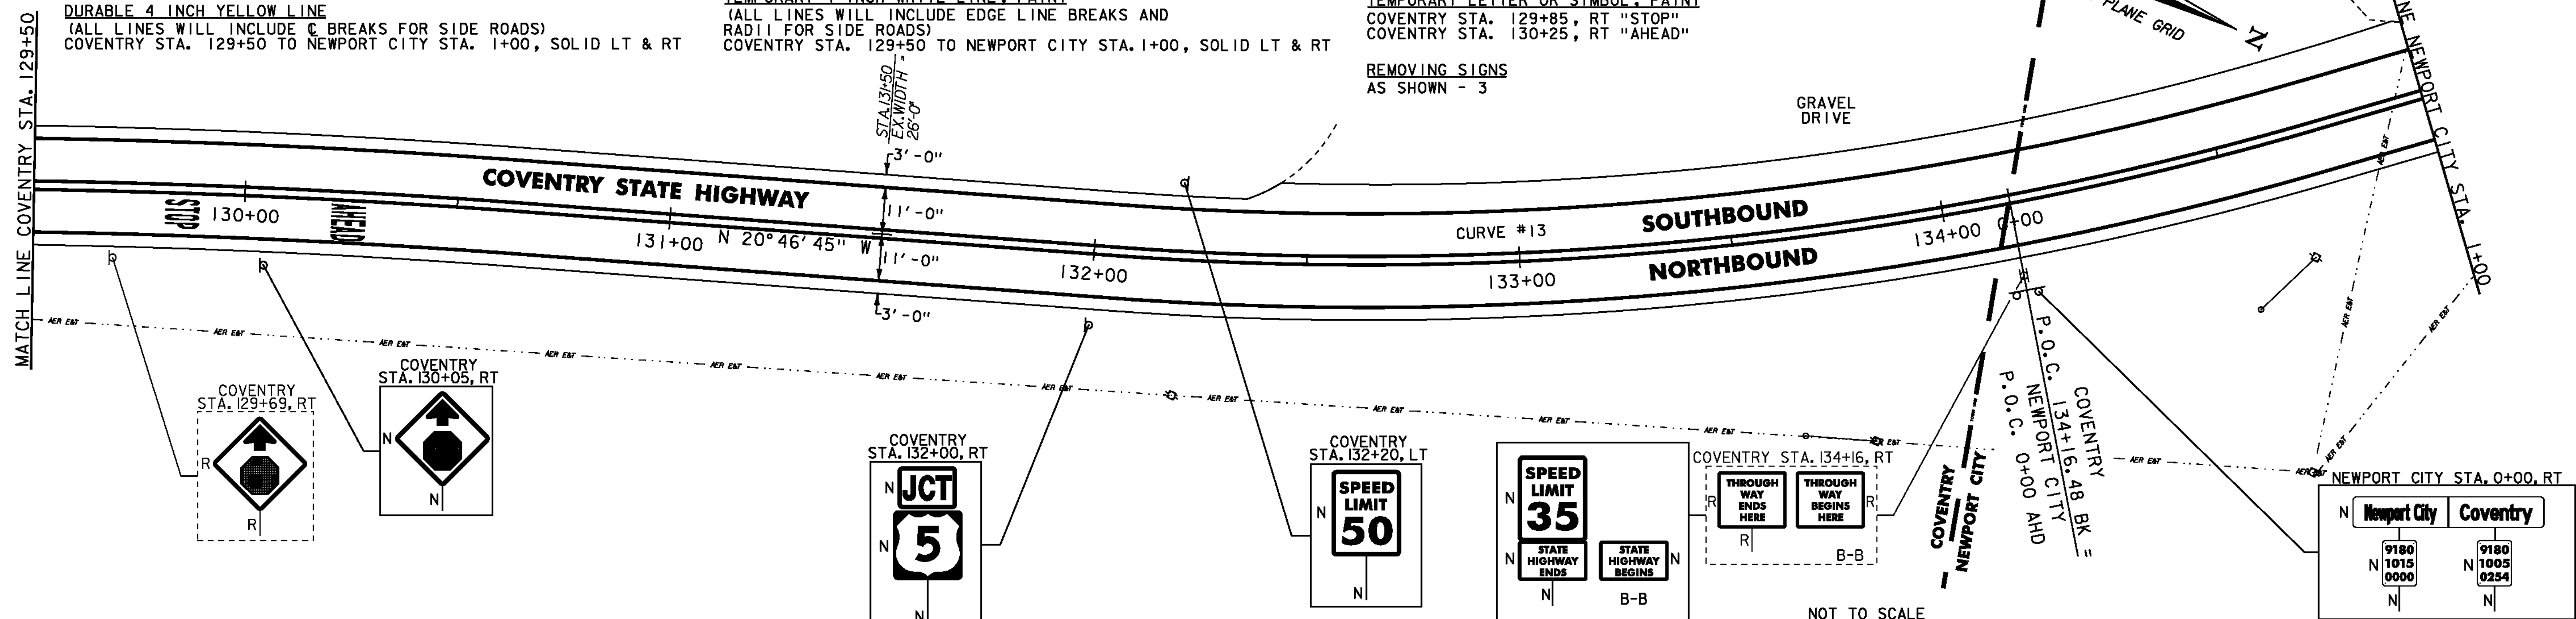

CURVE #13
 PC = COVENTRY STA. 132+04.69
 PT = NEWPORT CITY STA. 0+74.16
 R = 800'
 $\Delta = 20^\circ 26' 43''$, LT
 $D = 7^\circ 09' 43''$
 $e = 7.9\%$
 $L = 285.47'$
 SEE SHEET 43.

- NOTES:
- FOR LEGENDS, SEE SHEET 20
 - ALL EXISTING SIGNS NOT SHOWN SHALL BE RETAINED.
 - FOR PAVEMENT CORE AND TEST PIT DATA SEE SHEET 50.
 - SEE QUANTITY SHEETS FOR DURABLE PAVEMENT MARKING OPTIONS.



NOT TO SCALE

PROJECT LAYOUT SHEET #12

PROJECT NAME: COVENTRY-NEWPORT CITY	PLOT DATE: 18-MAY-2012
PROJECT NUMBER: STP 2308(I)	DRAWN BY: STANTEC
FILE NAME: p01c052.dgn	CHECKED BY: STANTEC
PROJECT LEADER: JLL	SHEET 31 OF 107
DESIGNED BY: STANTEC	
IPARM FILE: p01c052112.1	