


TYPICAL SECTIONS

1 3/4" BITUMINOUS CONCRETE PAVEMENT, TYPE III
 4" BASE COURSE OF BITUMINOUS CONCRETE PAVEMENT, TYPE I (LIFT)
 VARIES SUBBASE OF DENSE GRADED CRUSHED STONE
 SHOULDERS: 5 3/4" BITUMINOUS CONCRETE PAVEMENT (1 3/4" TYPE III OVER 4" TYPE I)


MATERIAL ITEM	THICKNESS TOLERANCE
PAVEMENT (TOTAL DEPTH)	± 1/4"
SUBBASE	± 1"

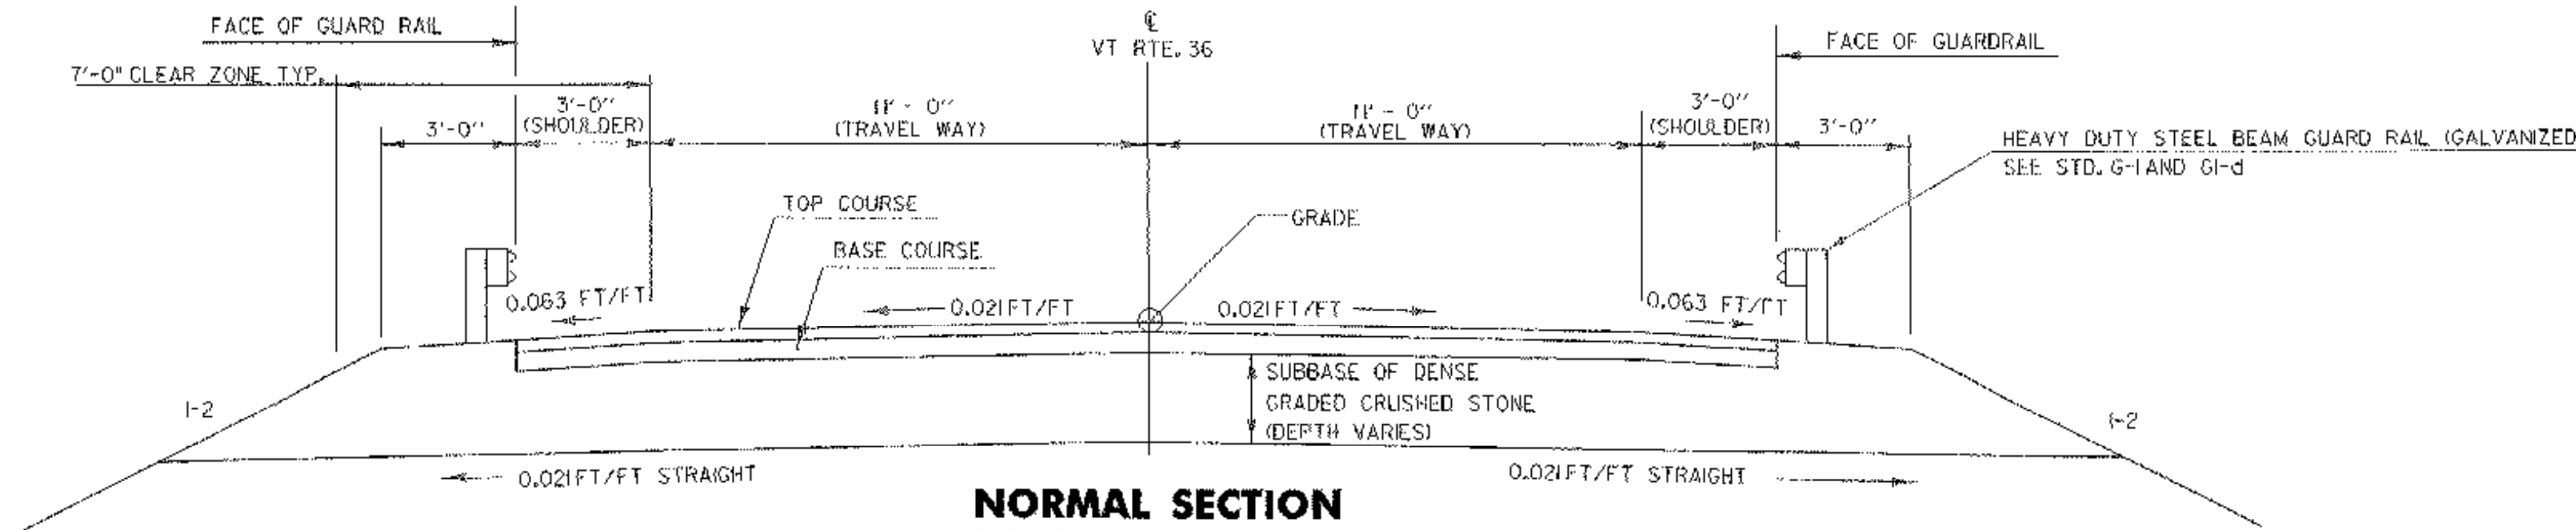

NORMAL SECTION

SCALE 3/8" = 1'-0"
 0 1 2 3 4


TRANSITION 0.021 SHOULDER SLOPE ON BRIDGE TO 0.063 SHOULDER SLOPE IN FIRST 50' FROM END OF BRIDGE. SEE BANKING DIAGRAM.

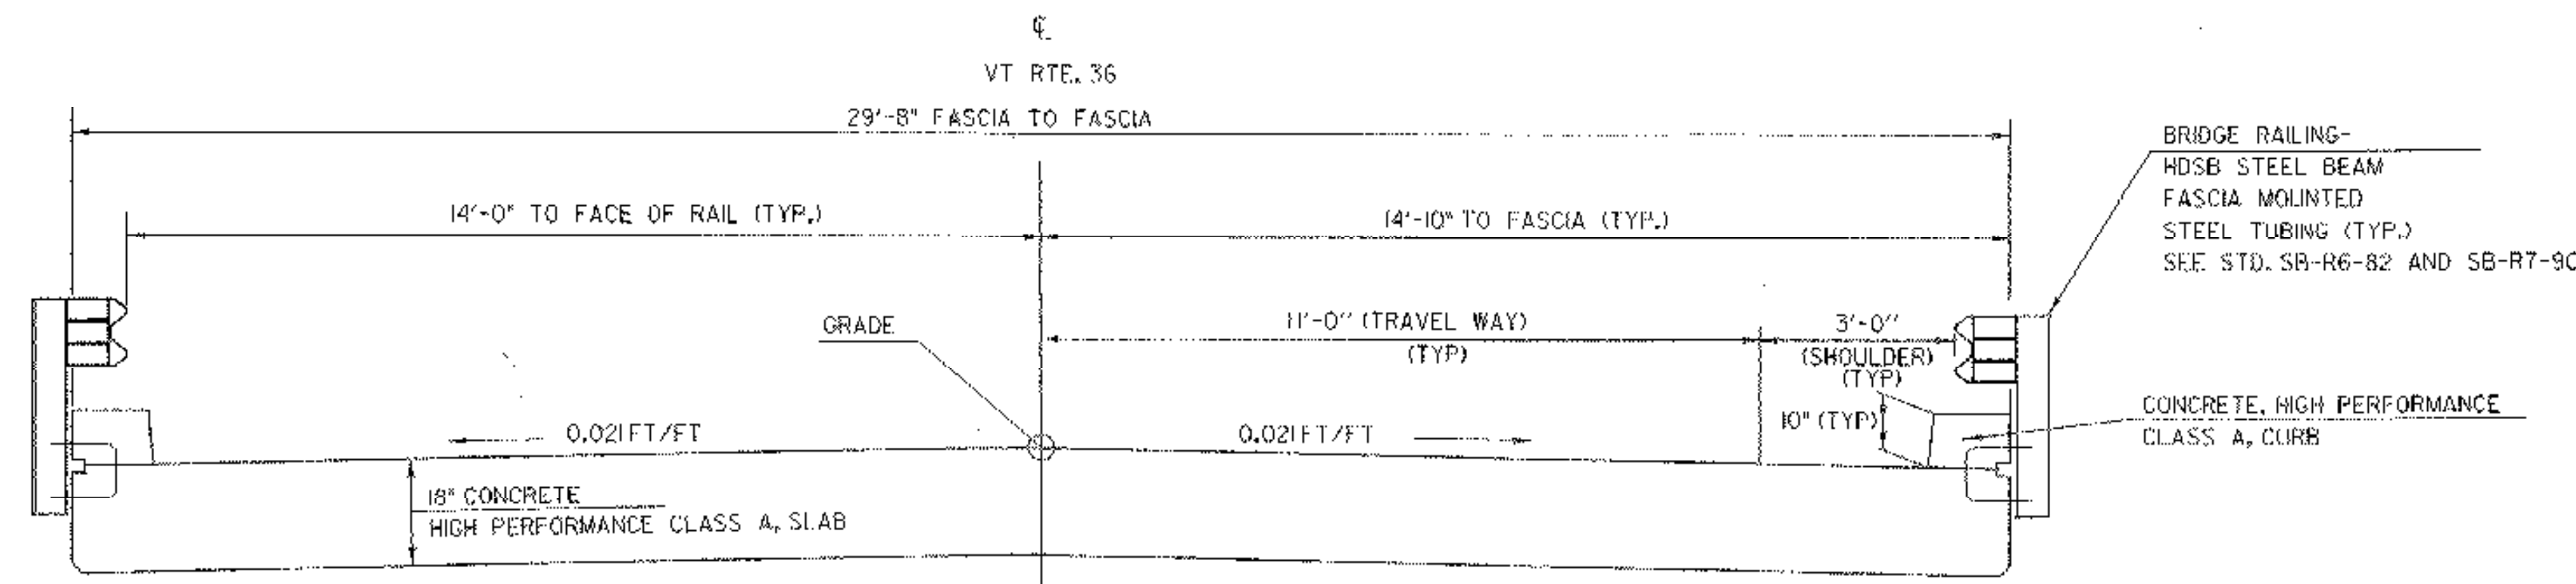

TYPICAL BRIDGE SECTION

SCALE 1/2" = 1'-0"
 0 1 2

CHANGES PER WRITTEN ORDER

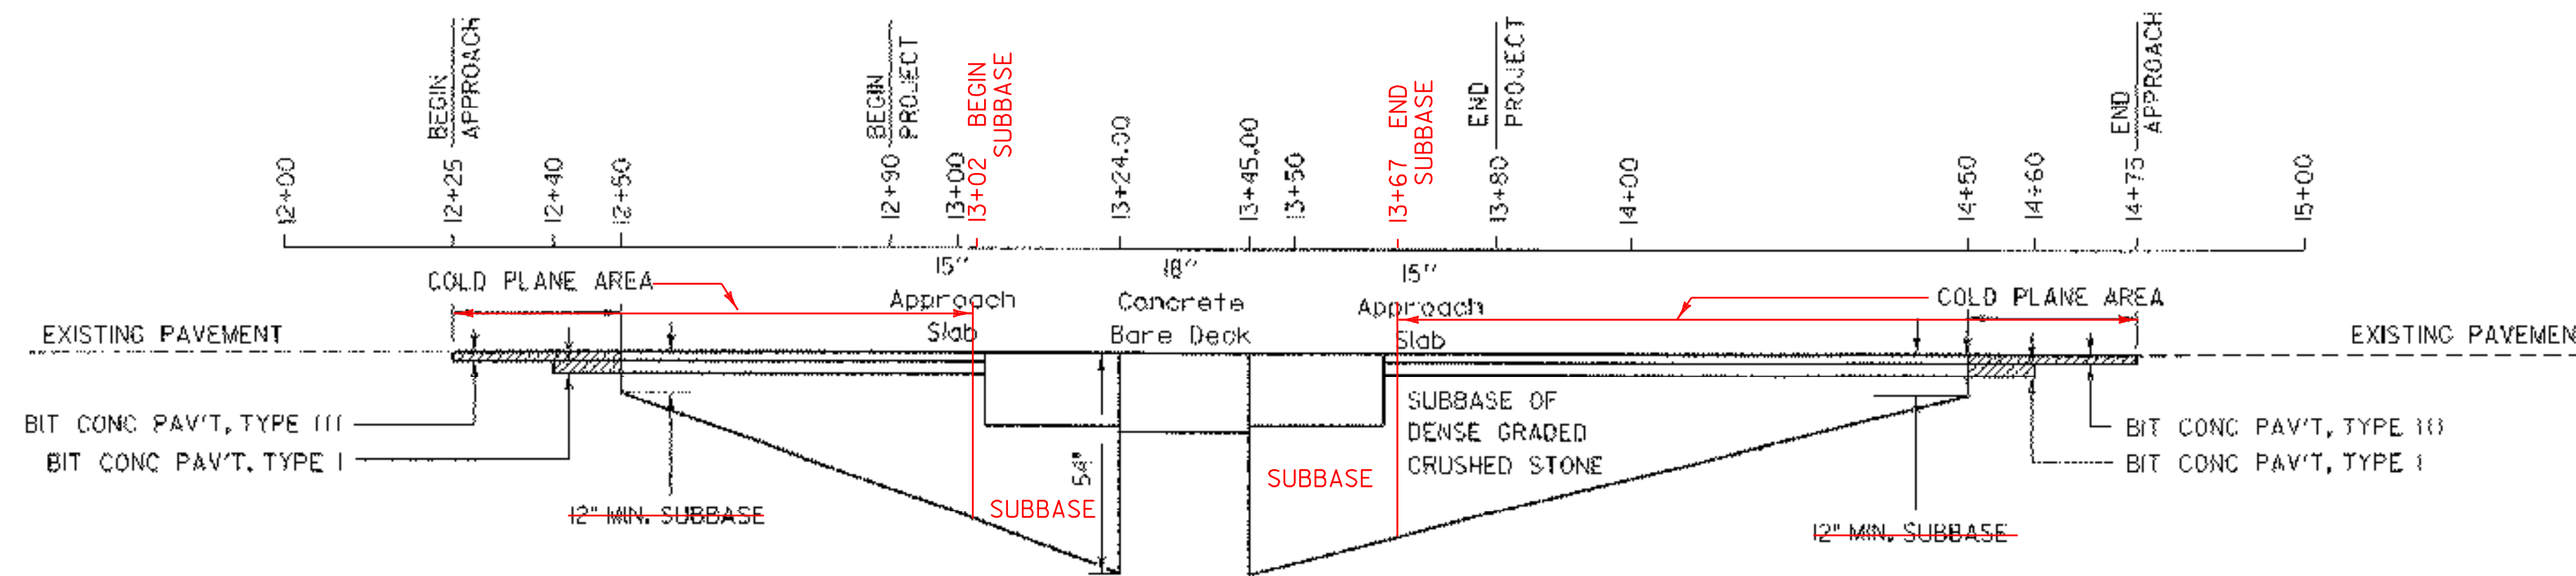

MATERIAL TRANSITION DIAGRAM

N.T.S.

SEEDING FORMULA RURAL AREAS

% WT.	LBS./A.	NAME	PUR. %	GERM. %
37.5	22.5	CREeping RED FESCUE	98	85
37.5	22.5	TALL FESCUE	95	90
5.0	3.0	RED TOP	95	90
15.0	9.0	BIRDFOOT TREFOIL	98	85
5.0	3.0	ANNUAL RYEGRASS	95	85
100.0	60.0			

GENERAL NOTES

SEED MIXTURE: SHALL NOT HAVE A WEED CONTENT EXCEEDING 0.40% BY WEIGHT AND SHALL BE FREE OF ALL NOXIOUS SEED.

SEED: TO BE APPLIED PER SEEDING FORMULAS OR AS DIRECTED BY THE ENGINEER.

FERTILIZER: FORMULA 10-20-10, TO BE USED WITH SEED, APPLIED AT THE RATE OF 500 LBS./ACRE. (HYDRO SEEDERS MAY USE 19-19-19 FORMULA).

AGRICULTURAL LIMESTONE: TO BE APPLIED AT THE RATE OF 2 TONS/ACRE, OR AS DIRECTED BY THE ENGINEER.

HAY MULCH: TO BE PLACED ON EARTH SLOPES AT THE RATE OF 2 TONS/ACRE, OR AS DIRECTED BY THE ENGINEER.

TOPSOIL: TO BE USED WITH SEED AS INDICATED ON THE PLANS, OR AS DIRECTED BY THE ENGINEER.

MARKER POSTS: TO BE PLACED AS INDICATED OR AS DIRECTED BY THE ENGINEER.

SLOPE ROUNDING: ALL CUT SLOPES TO BE ROUNDED IN ACCORDANCE WITH STANDARD SHEET B-5.

PAY LIMITS OF SAND BORROW: WHEN USED IN CONJUNCTION WITH UNDERDRAIN - SEE STANDARD SHEET D - 2.

TYPICALS SHEET

PROJECT NAME: FAIRFIELD	PLOT DATE: 28-APR-2005
PROJECT NUMBER: AC STP ST 0298(6)	DRAWN BY: J. REED
FILE NAME: /str5/01c182/sc182typ.dgn	CHECKED BY: W. SYMONDS
PROJECT LEADER: C. KELLER	SHEET 5 OF 41
DESIGNED BY: J. REED	