


EXISTING GRADES SHOWN TO ONE DECIMAL PLACE  
 PROPOSED GRADES SHOWN TO TWO DECIMAL PLACES

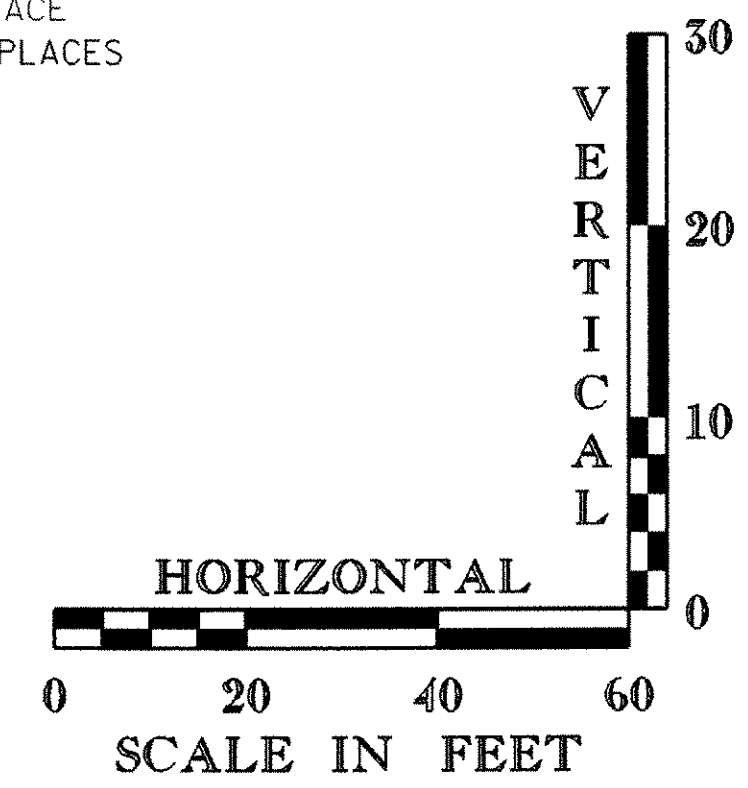

### PROFILE SHEET

PROJECT NAME:	FAIRFIELD
PROJECT NUMBER:	AC STP ST 0298 (6)
FILE NAME:	/str5/01cl82/scl82wrk.dgn
PROJECT LEADER:	C. KELLER
DESIGNED BY:	J. REED
PLLOT DATE:	28-APR-2005
DRAWN BY:	J. GEORGE
CHECKED BY:	W.B. SYMONDS
SHEET	9 OF 41