
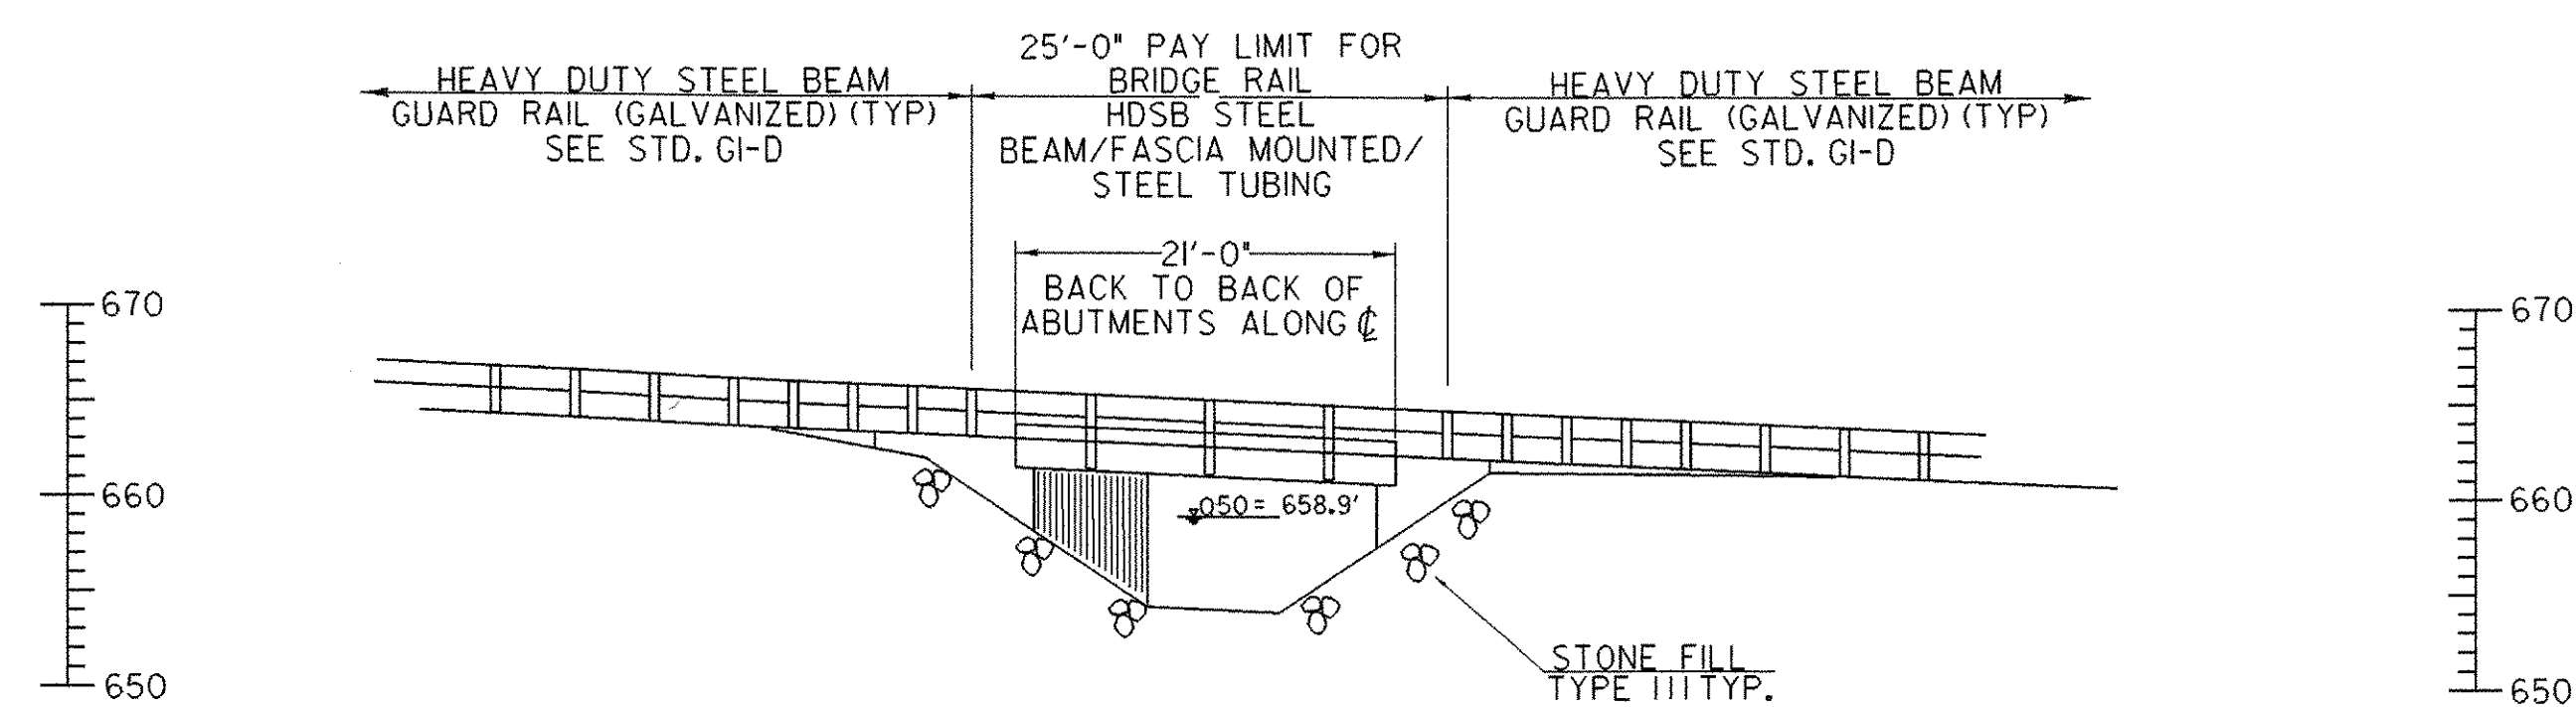


PLAN

SCALE 1" = 10'-0"

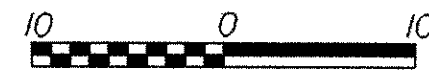

ELEVATION

SCALE 1" = 10'-0"



NOTE:
 SEE STANDARDS SB-R6-82 AND SB-R7-90 FOR BRIDGE RAIL
 INFORMATION. THE TRANSITION POST ON ALL FOUR CORNERS
 OF THE BRIDGE RAIL SHALL BE OMITTED.

PLAN AND ELEVATION SHEET

PROJECT NAME: FAIRFIELD	PLOT DATE: 28-APR-2005
PROJECT NUMBER: AC STP ST 0298(6)	DRAWN BY: J. REED
FILE NAME: /str5/01c182/sc182/sc182pe	CHECKED BY: W.B. SYMONDS
PROJECT LEADER: C. KELLER	SHEET 20 OF 41
DESIGNED BY: J. REED	
sc182pe.i	