



APPROACH SLAB #1 PLAN

SCALE 1/4" = 1'-0"  
1 0 2 4 6

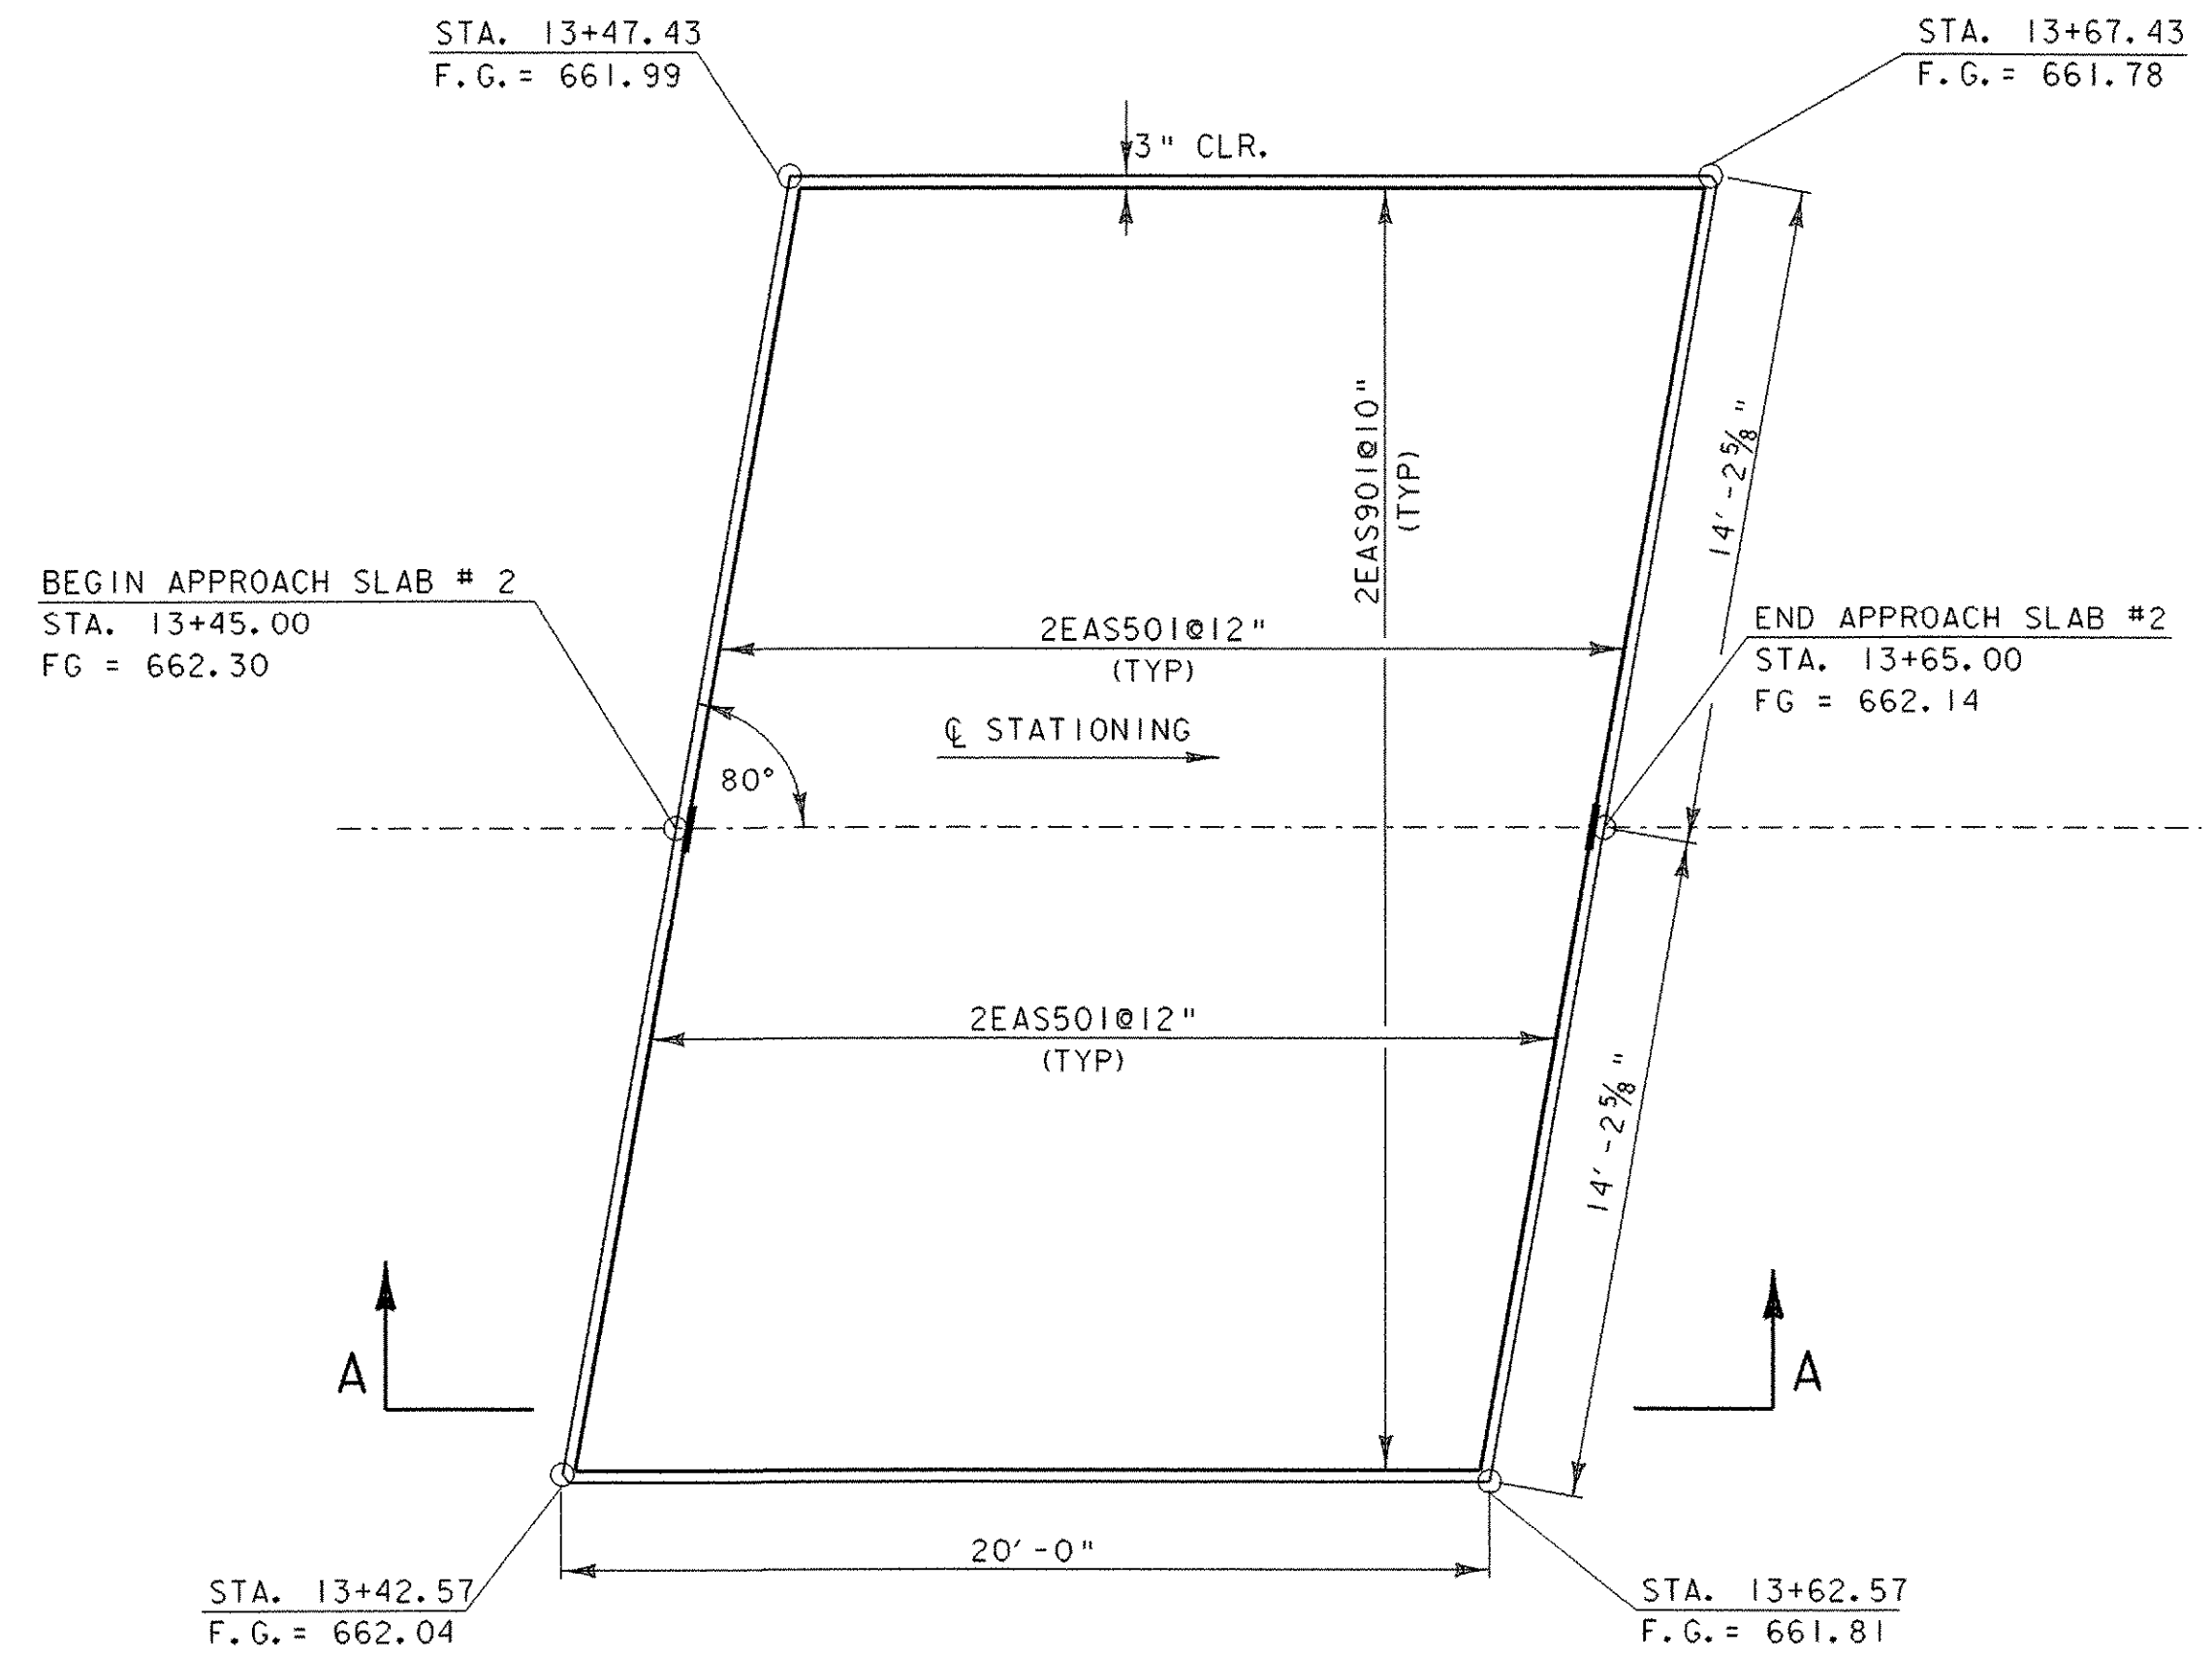


APPROACH SLAB #2 PLAN

SCALE 1/4" = 1'-0"  
1 0 2 4 6

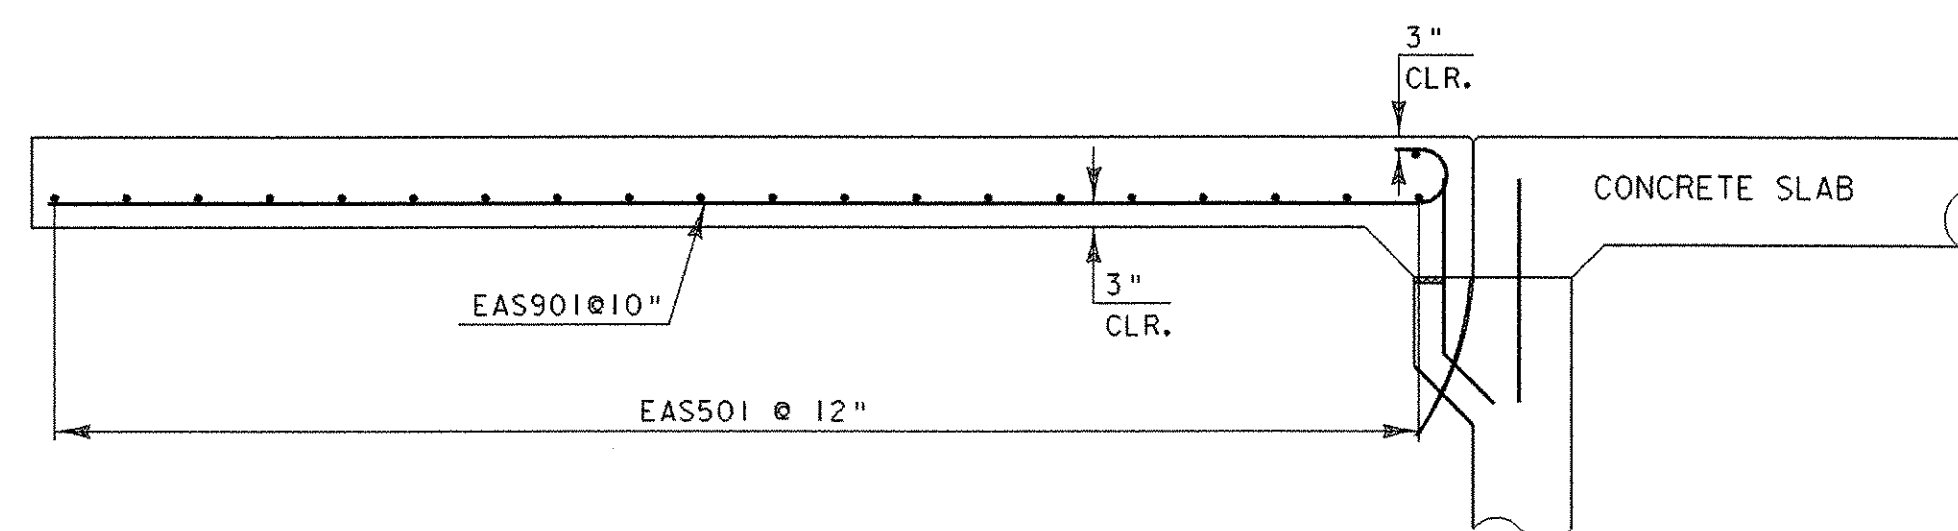


SECTION A-A

SCALE 3/8" = 1'-0"  
1 0 1 2 3 4

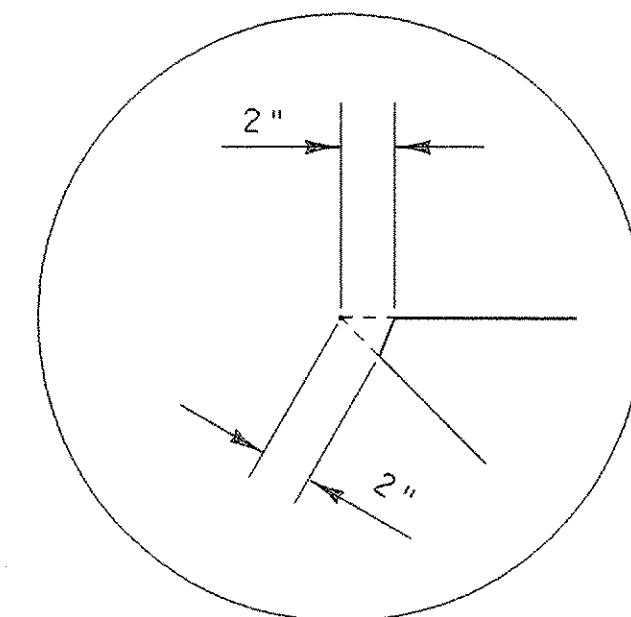

CORNER DETAIL  
(TYPICAL FOR ACUTE ANGLES ONLY)  
NTS

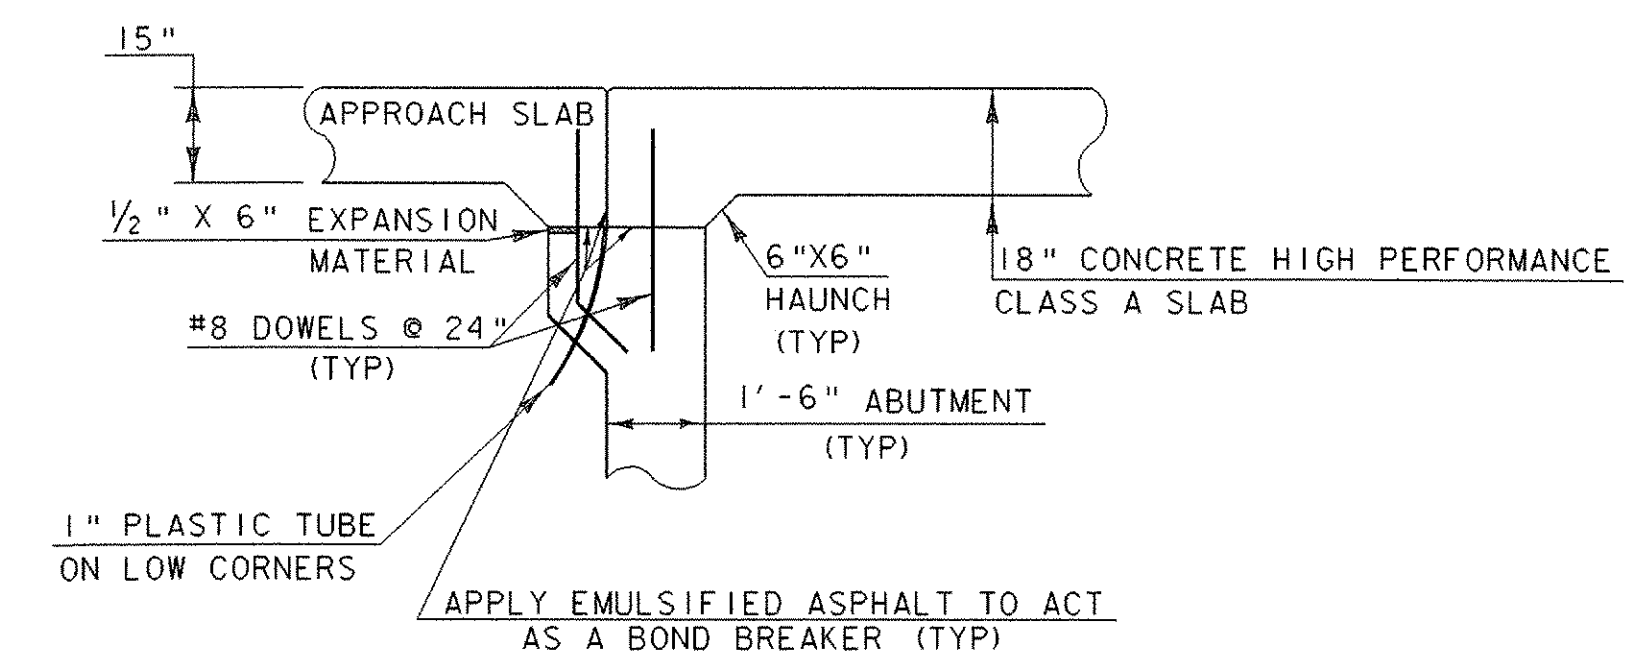

TYPICAL END SECTION

SCALE 3/8" = 1'-0"  
1 0 1 2 3 4

**APPROACH SLAB**

|                 |                          |
|-----------------|--------------------------|
| PROJECT NAME:   | FAIRFIELD                |
| PROJECT NUMBER: | AC STP ST 0298 (6)       |
| FILE NAME:      | str5/0/cl82/scl82+yp.dgn |
| PROJECT LEADER: | C. KELLER                |
| DESIGNED BY:    | J. REED                  |
| PLLOT DATE:     | 28-APR-2005              |
| DRAWN BY:       | J. REED                  |
| CHECKED BY:     | W. B. SYMONDS            |
| FILE NAME:      | scl82apslb.i             |
|                 | SHEET 24 OF 41           |