



ABUTMENT #1 PLAN

SCALE 3/8" = 1'-0"
 1 0 1 2 3 4

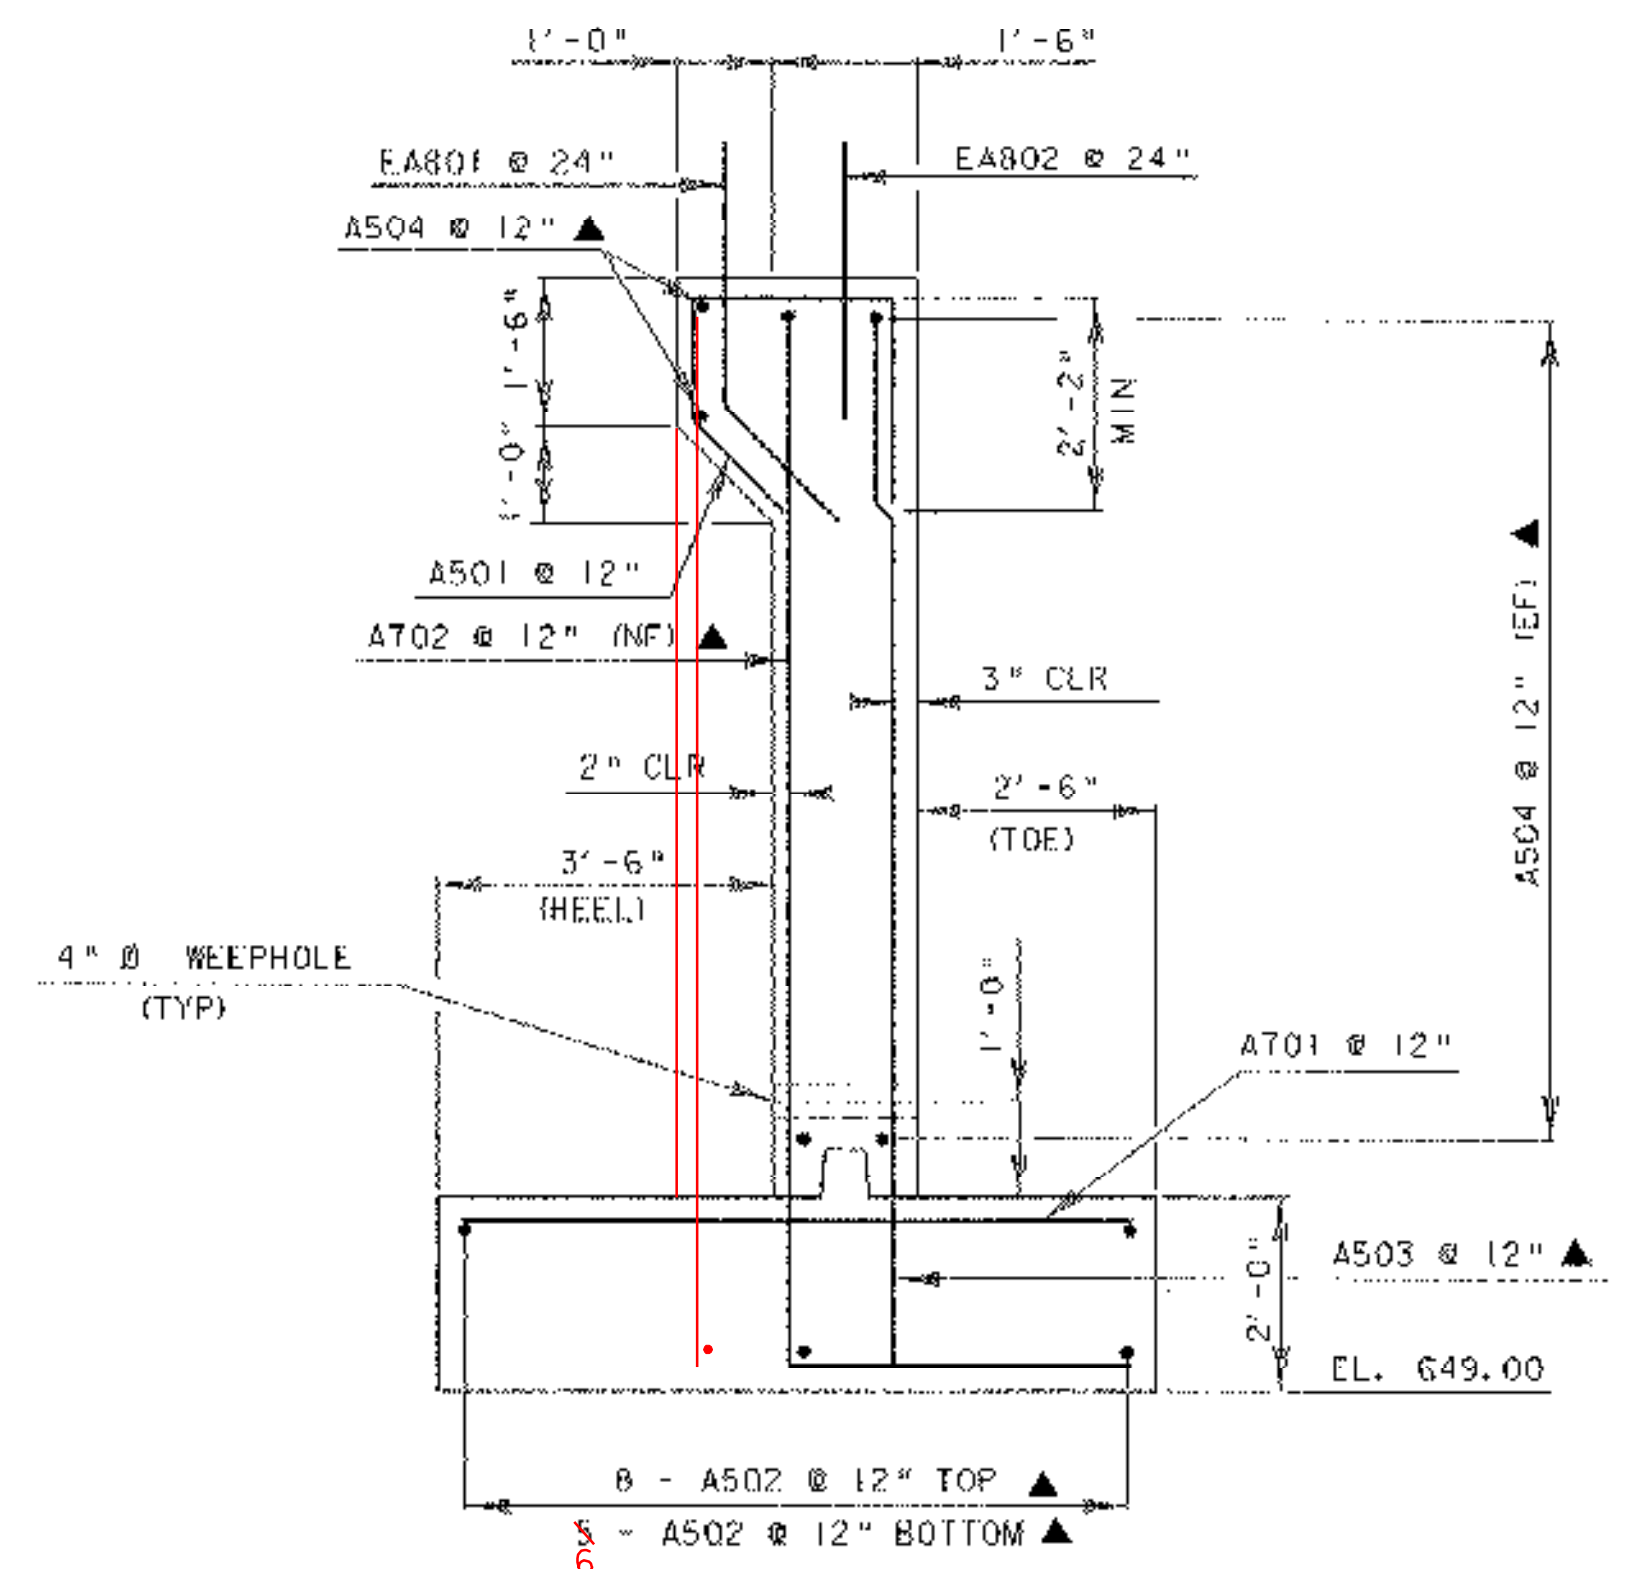

TYPICAL ABUTMENT SECTION

SCALE 1/2" = 1'-0"
 1 0 1 2

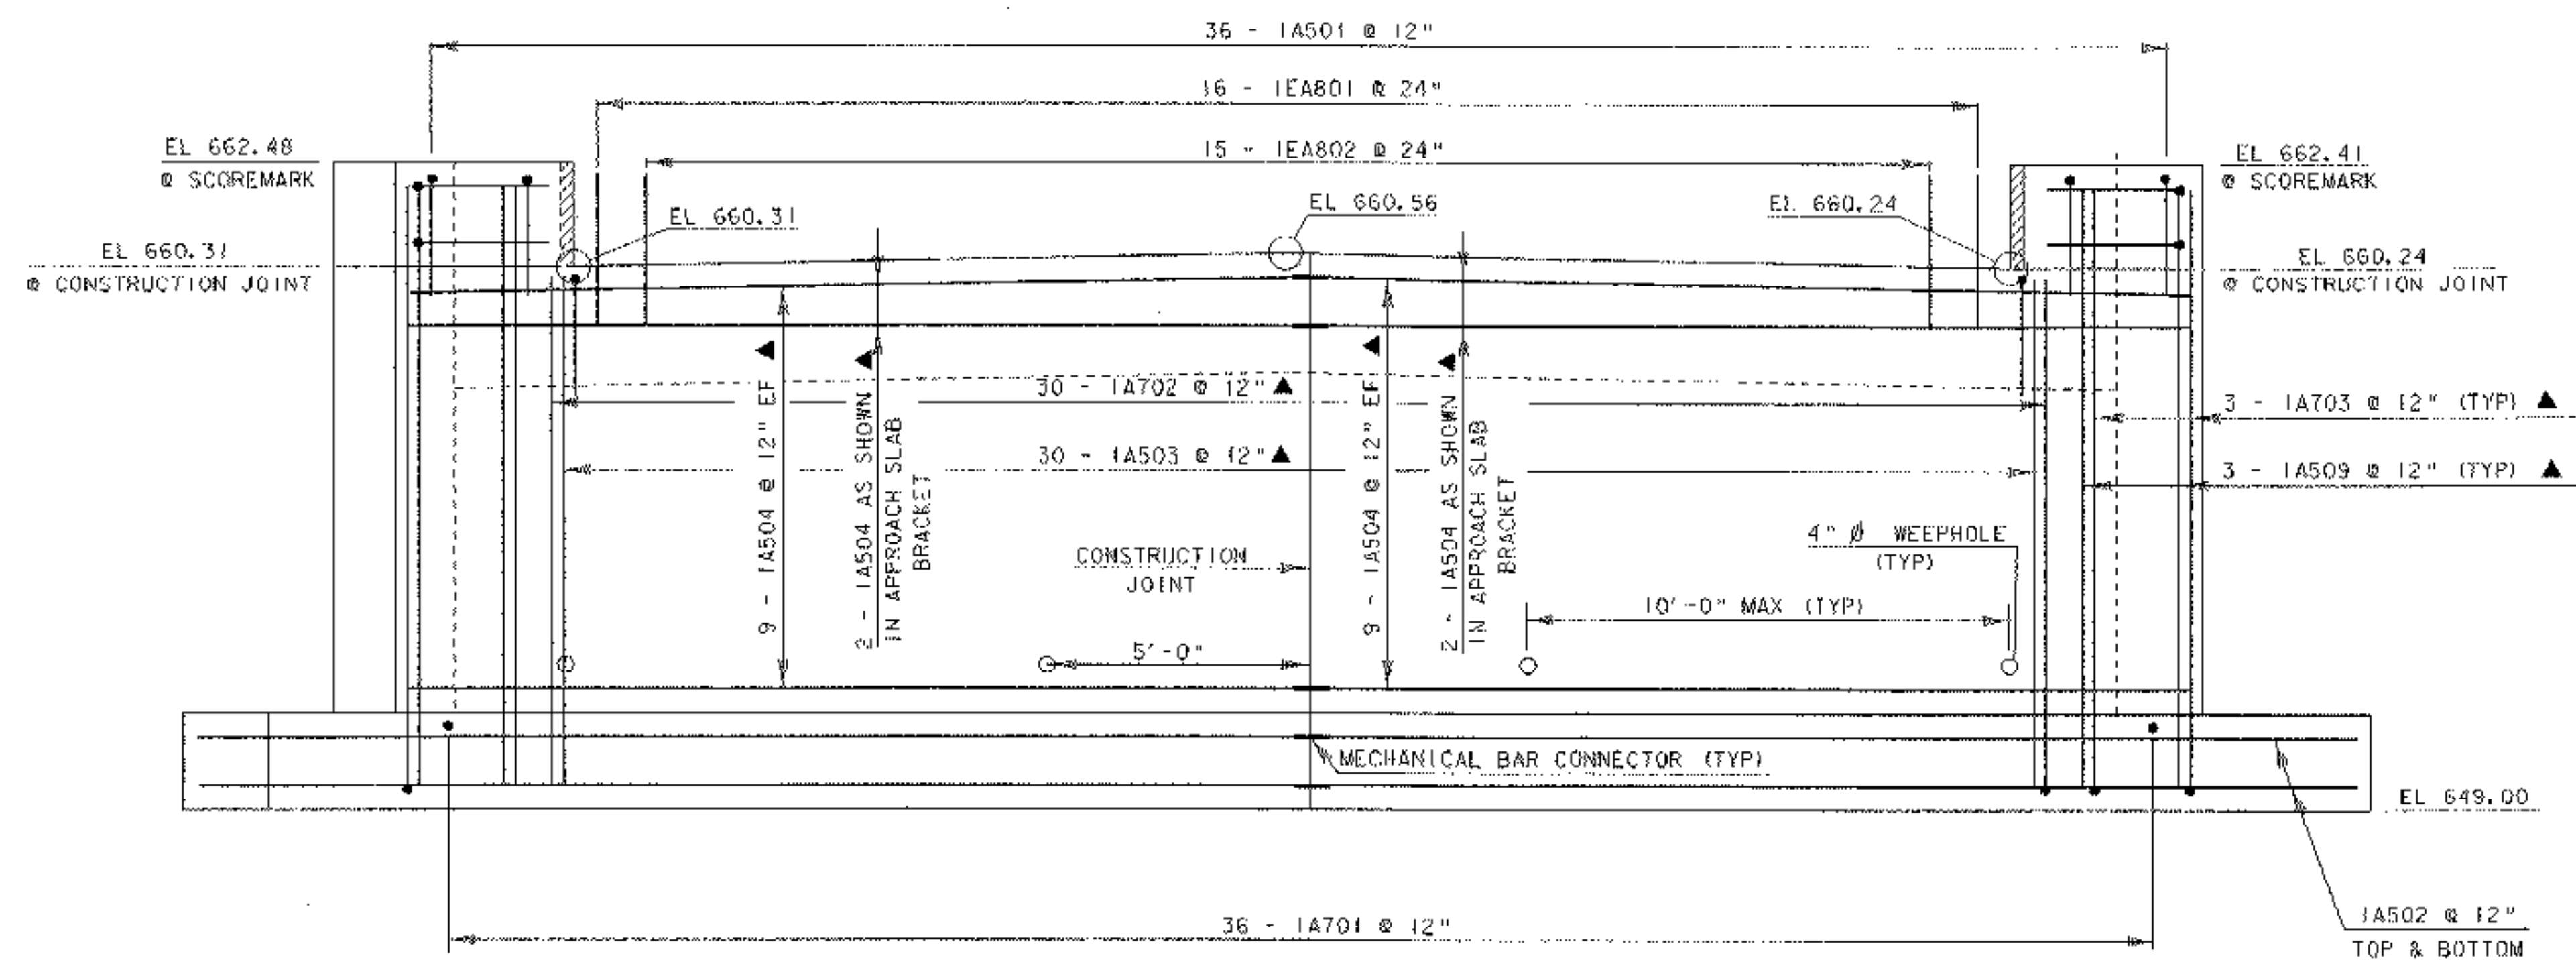

ABUTMENT #1 ELEVATION

SCALE 3/8" = 1'-0"
 1 0 1 2 3 4

NOTE:

- NF = NEAR FACE
- FF = FAR FACE
- EF = EACH FACE
- ▲ = CUT TO FIT IN FIELD
- 3" CLR. UNLESS OTHERWISE SPECIFIED ON THE PLANS.
- ALL LAPS ARE 2'-2" UNLESS OTHERWISE NOTED.

**ABUTMENT DETAIL:
 ABUTMENT #1**

PROJECT NAME:	FAIRFIELD	PLOT DATE:	28-APR-2005
PROJECT NUMBER:	AC STP ST 0298 (6)	DRAWN BY:	K. RUTTER
FILE NAME:	/s/r/5/010182/scf182sub.dgn	CHECKED BY:	M.B. SYMONDS
PROJECT LEADER:	C. KELLER	SHEET	25 OF 41
DESIGNED BY:	K. RUTTER		