



14+00


13+80.00
END PROJECT
BEGIN APPROACH

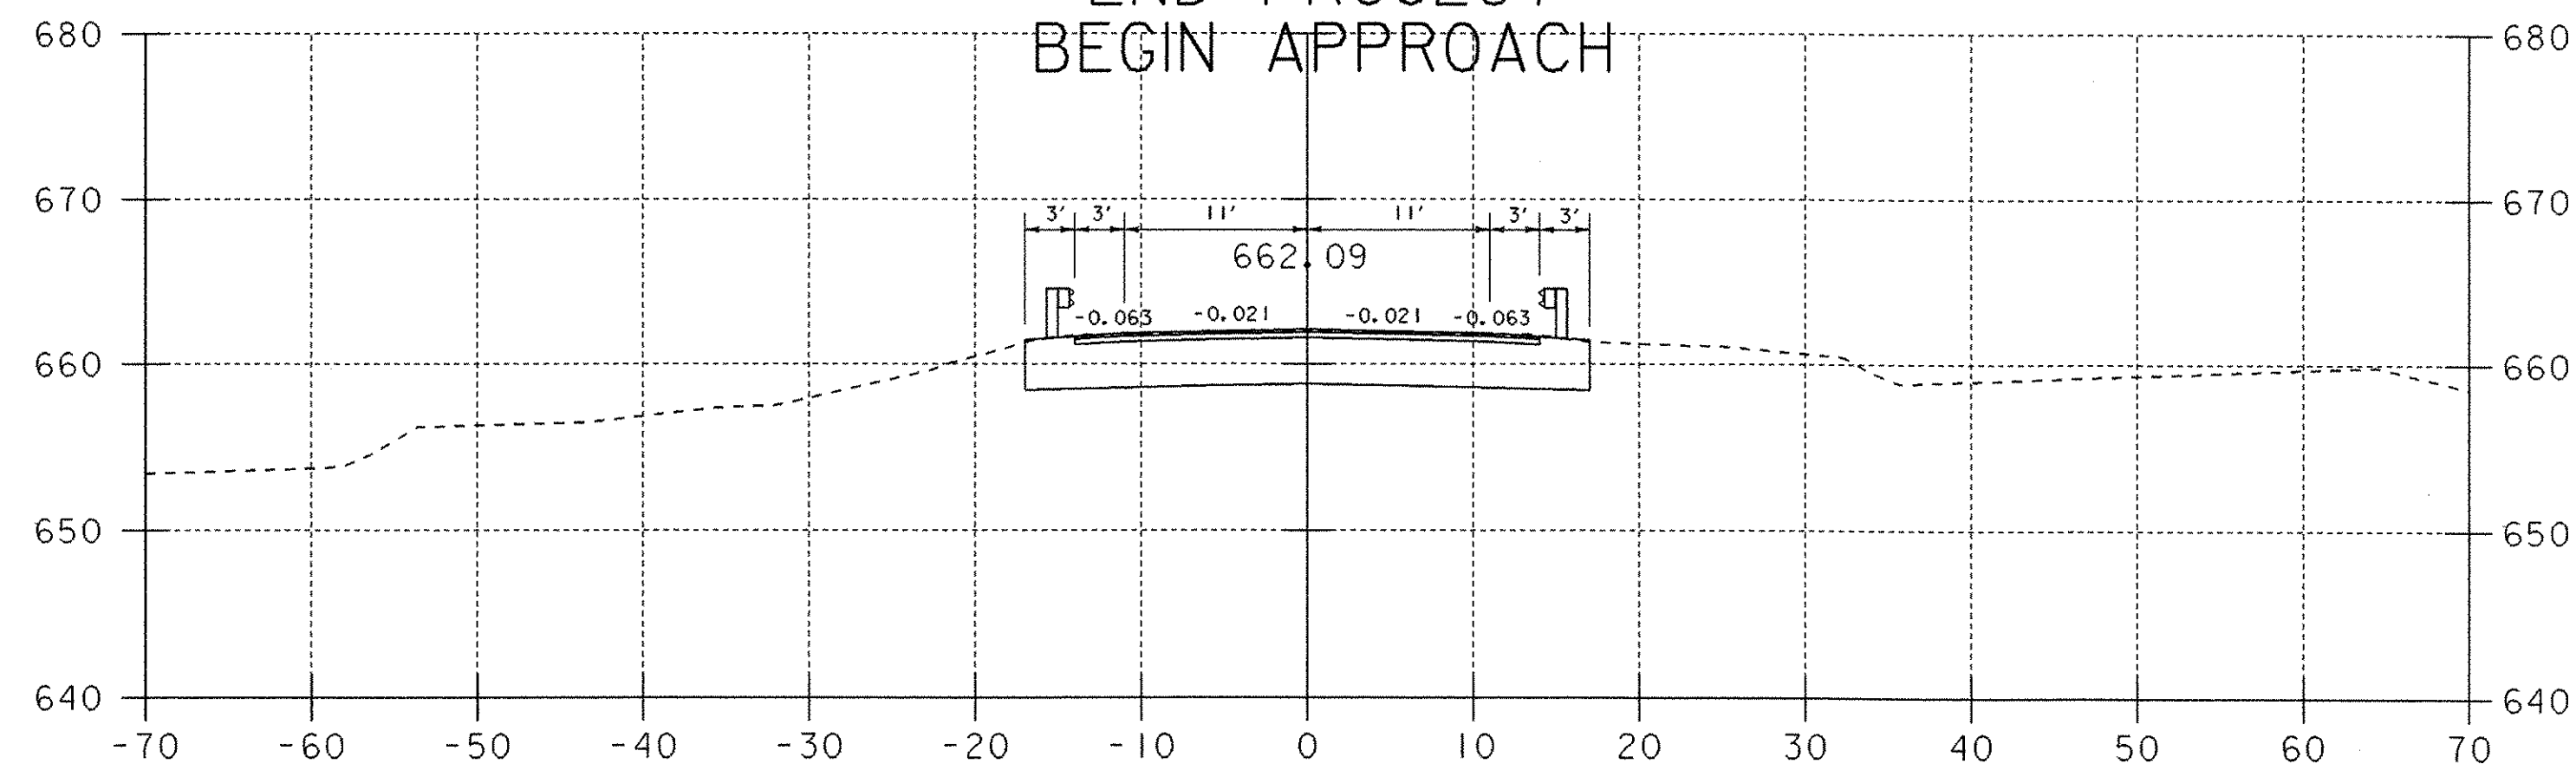


13+75

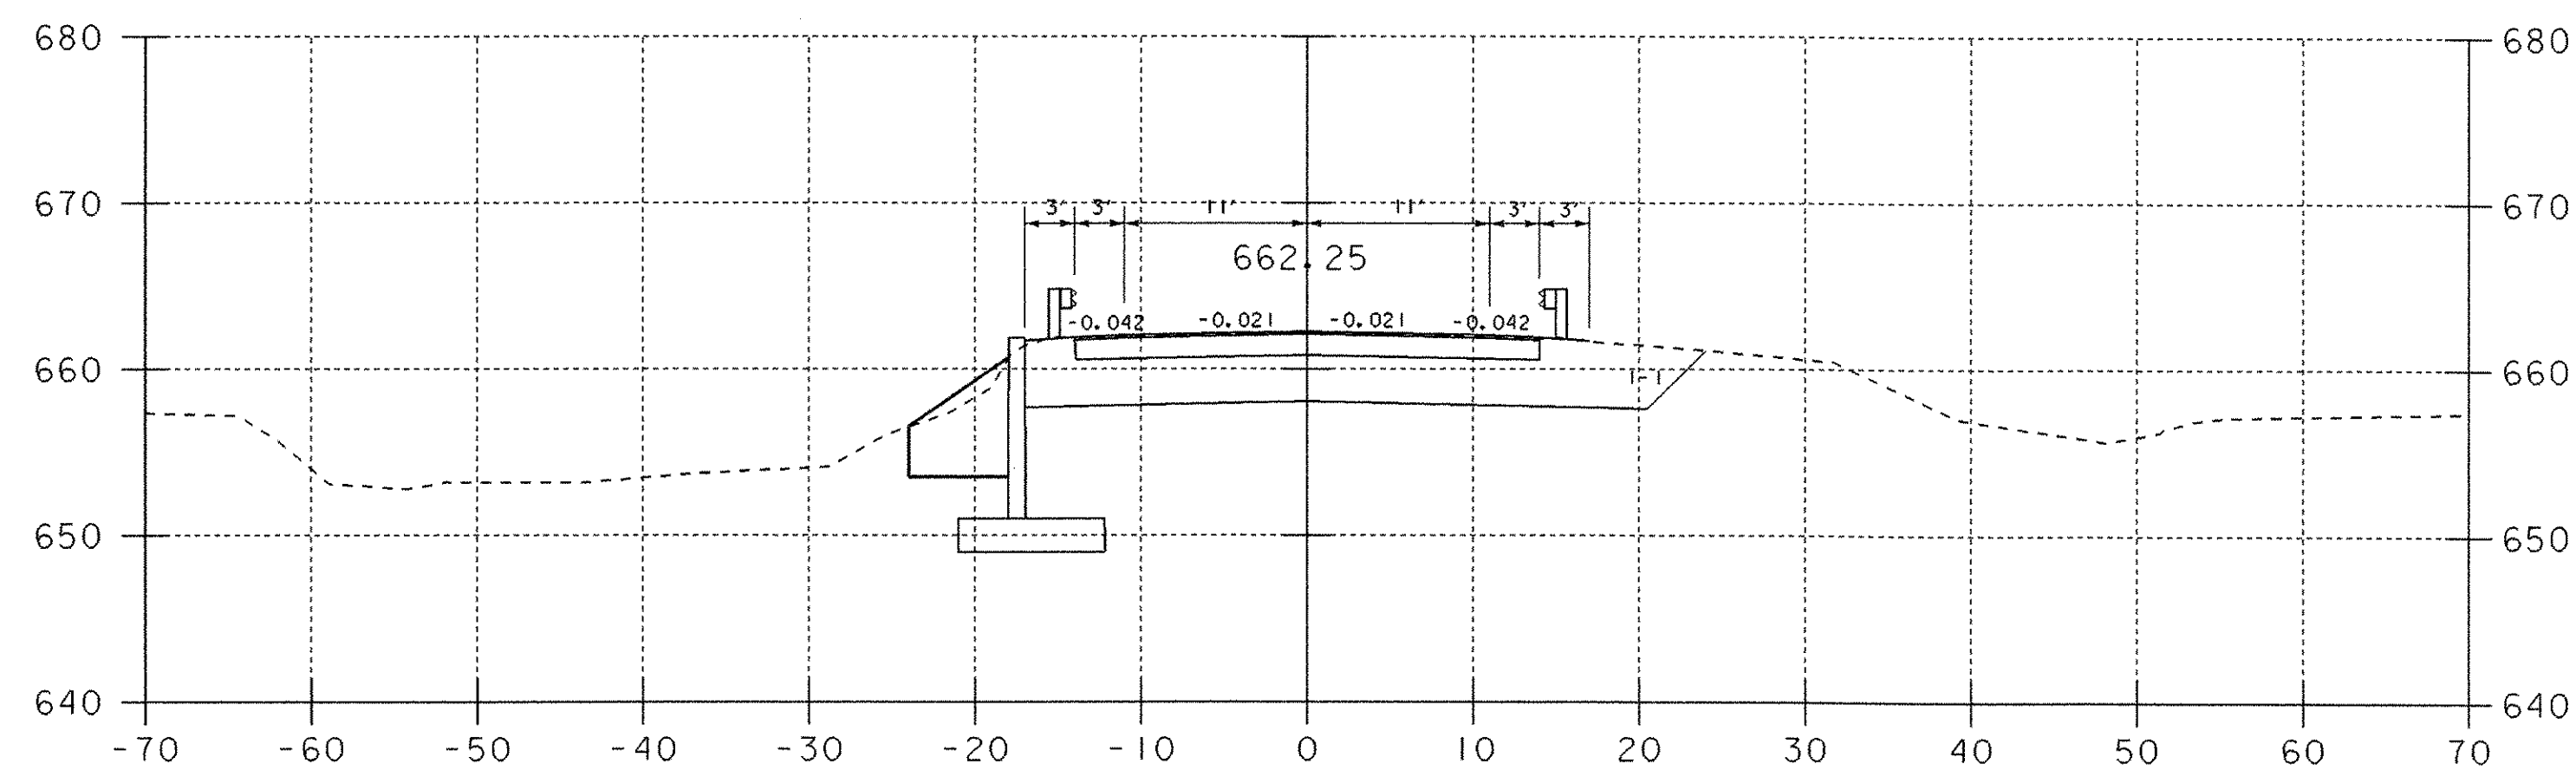


13+50

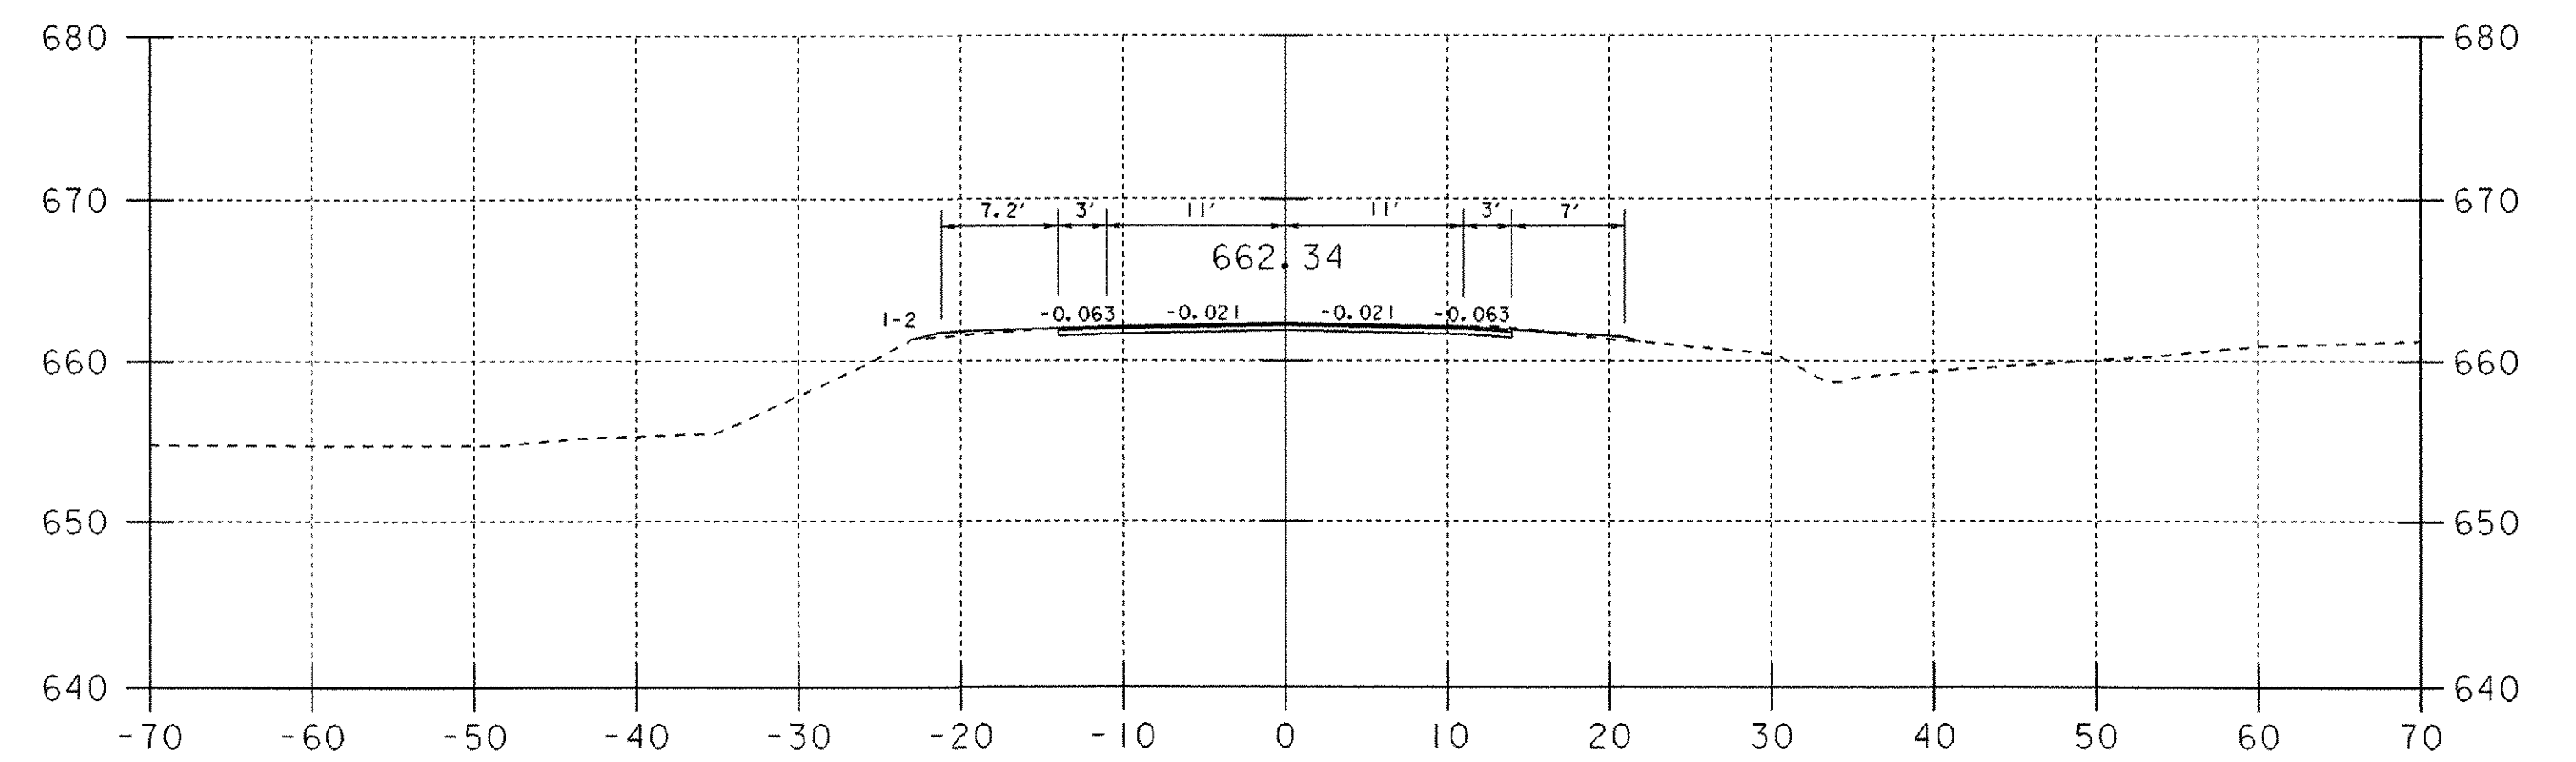

14+50

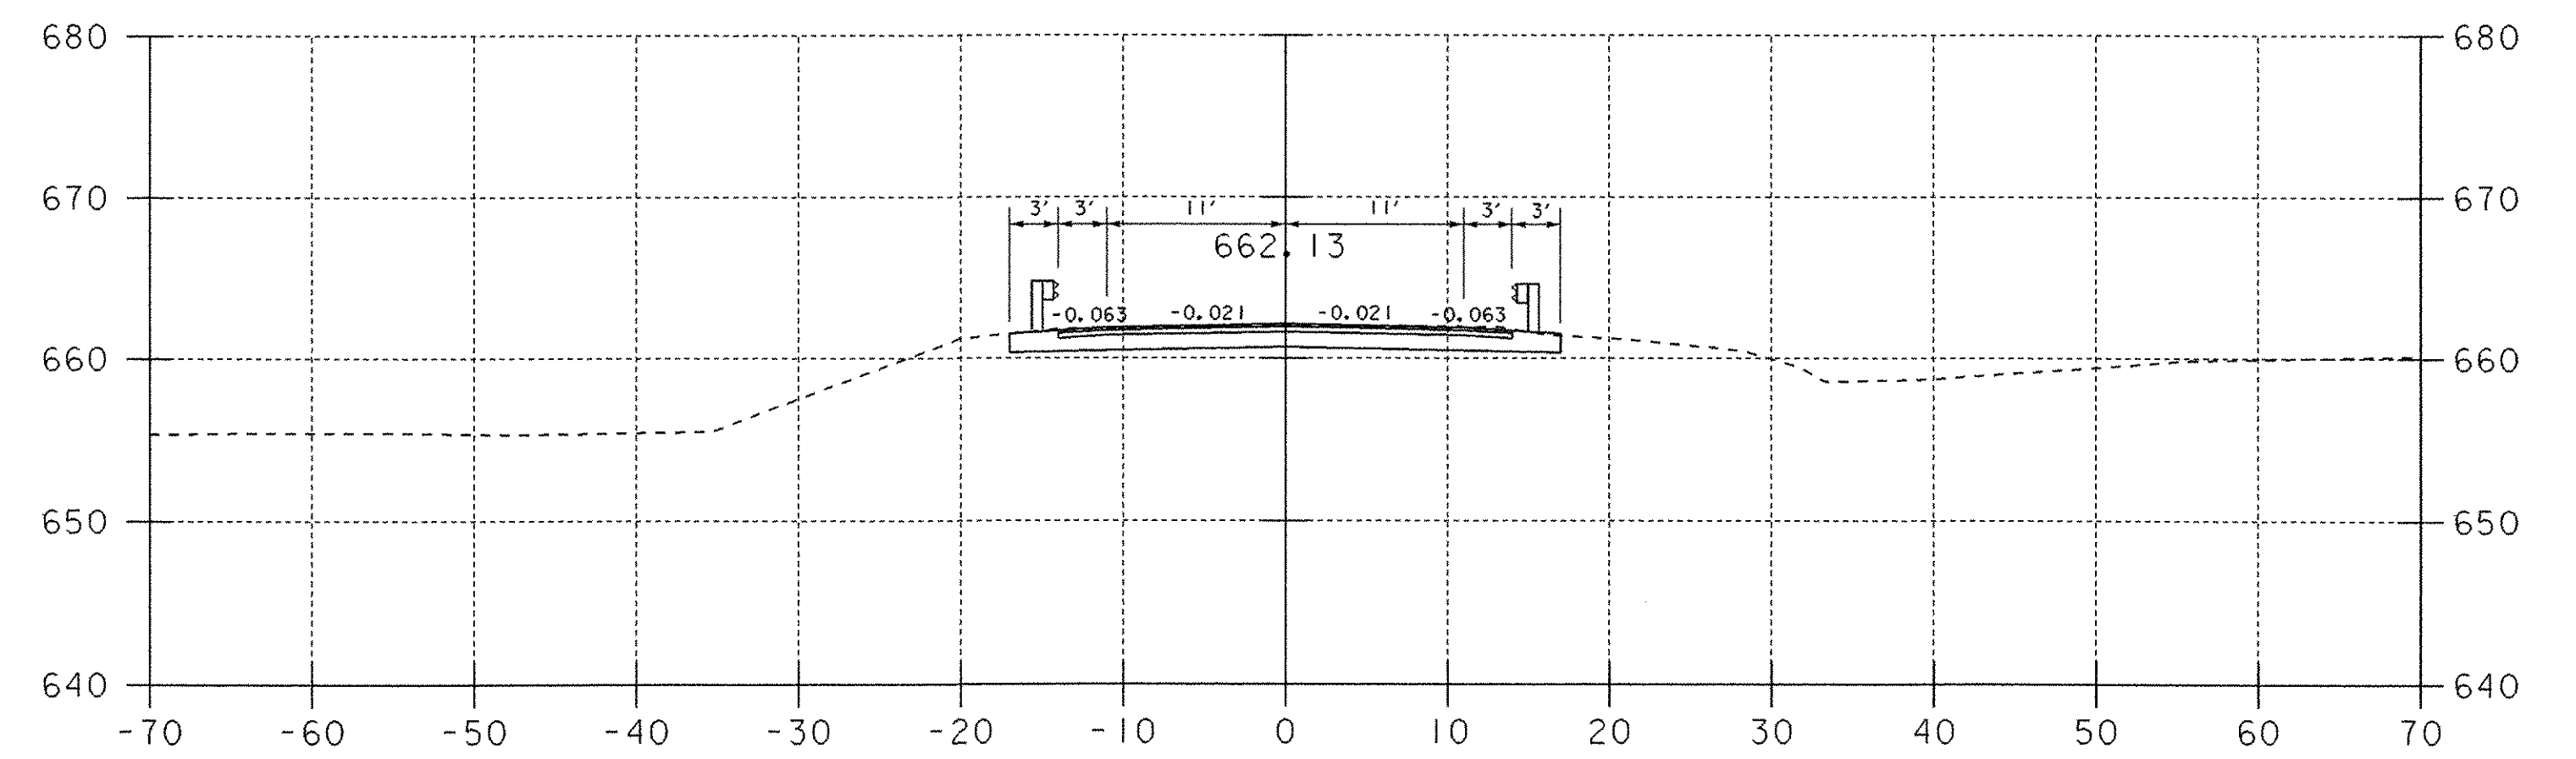

14+25

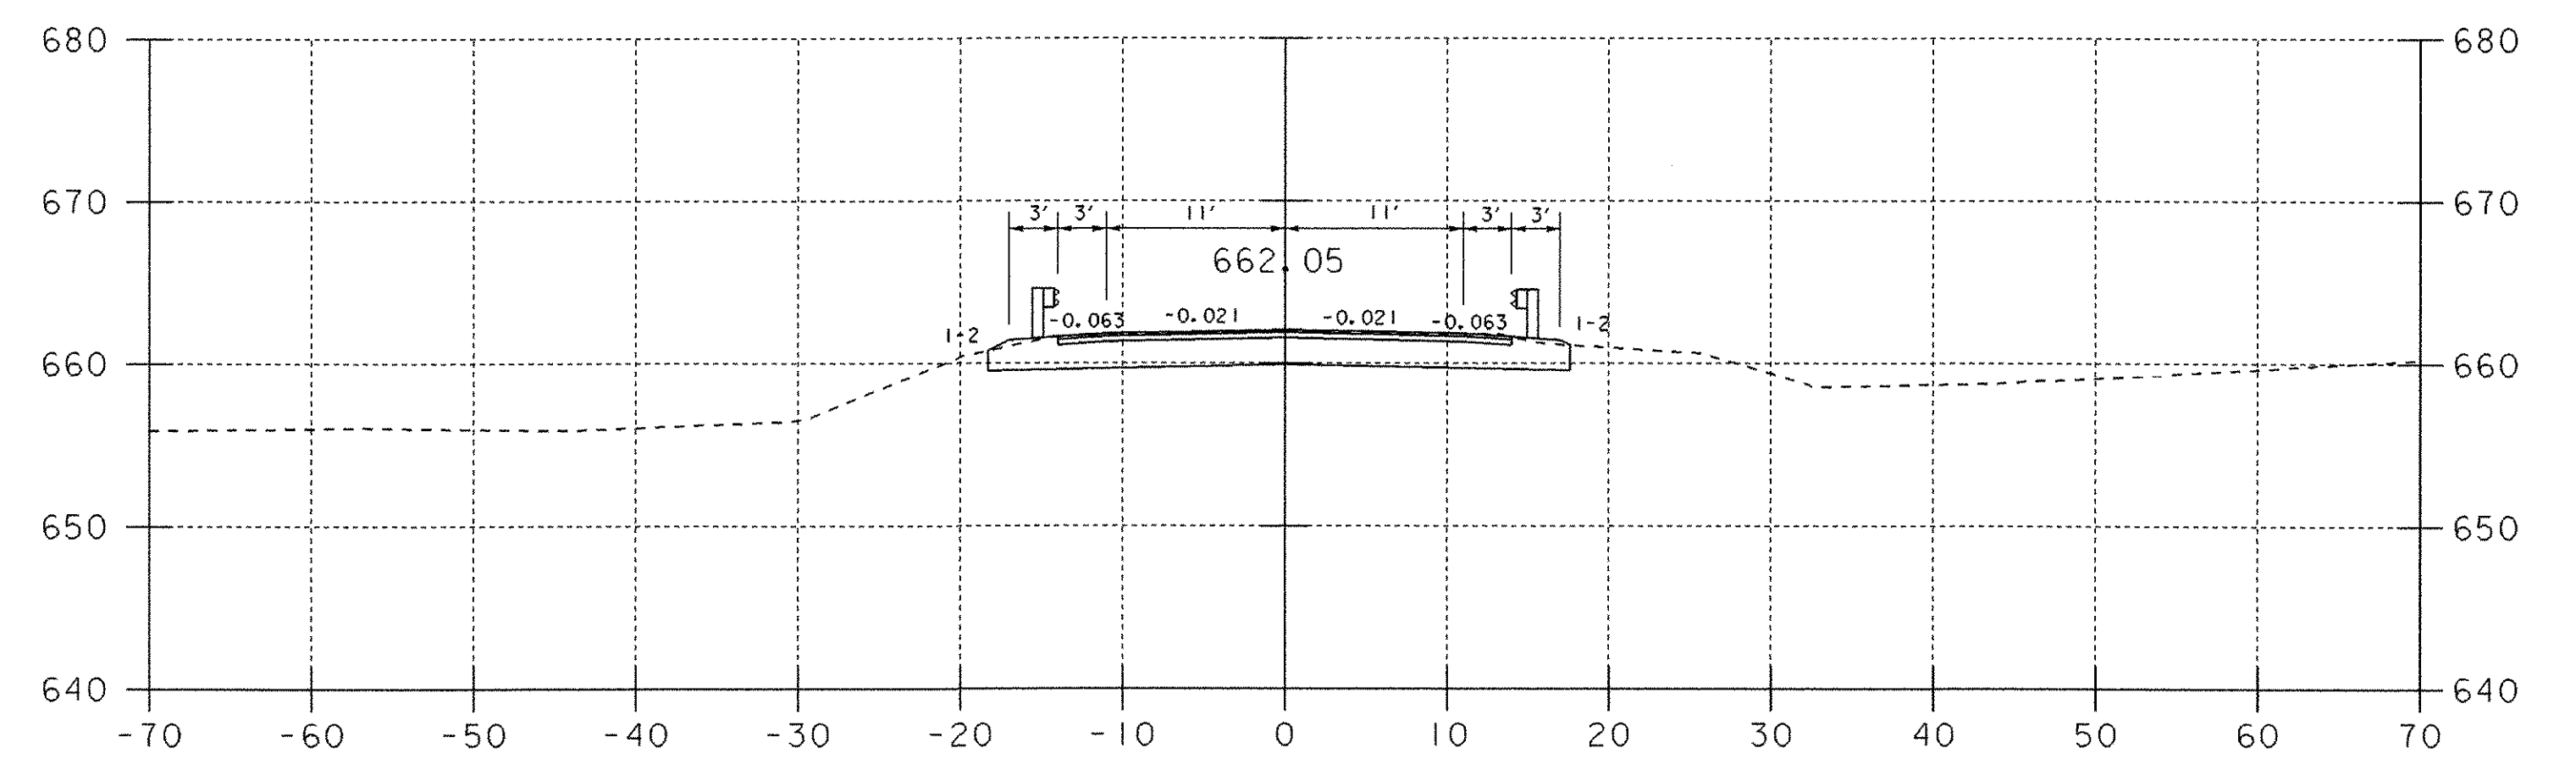

14+06

ROADWAY CROSS SECTIONS

PROJECT NAME:	FAIRFIELD	PLOT DATE:	28-APR-2005
PROJECT NUMBER:	AC STP ST 0298 (6)	DRAWN BY:	J. Reed
FILE NAME:	str5/01c182/sc182bdr.dgn	CHECKED BY:	W. B. Symonds
DESIGNED BY:	J. Reed	SHEET	33 OF 41