

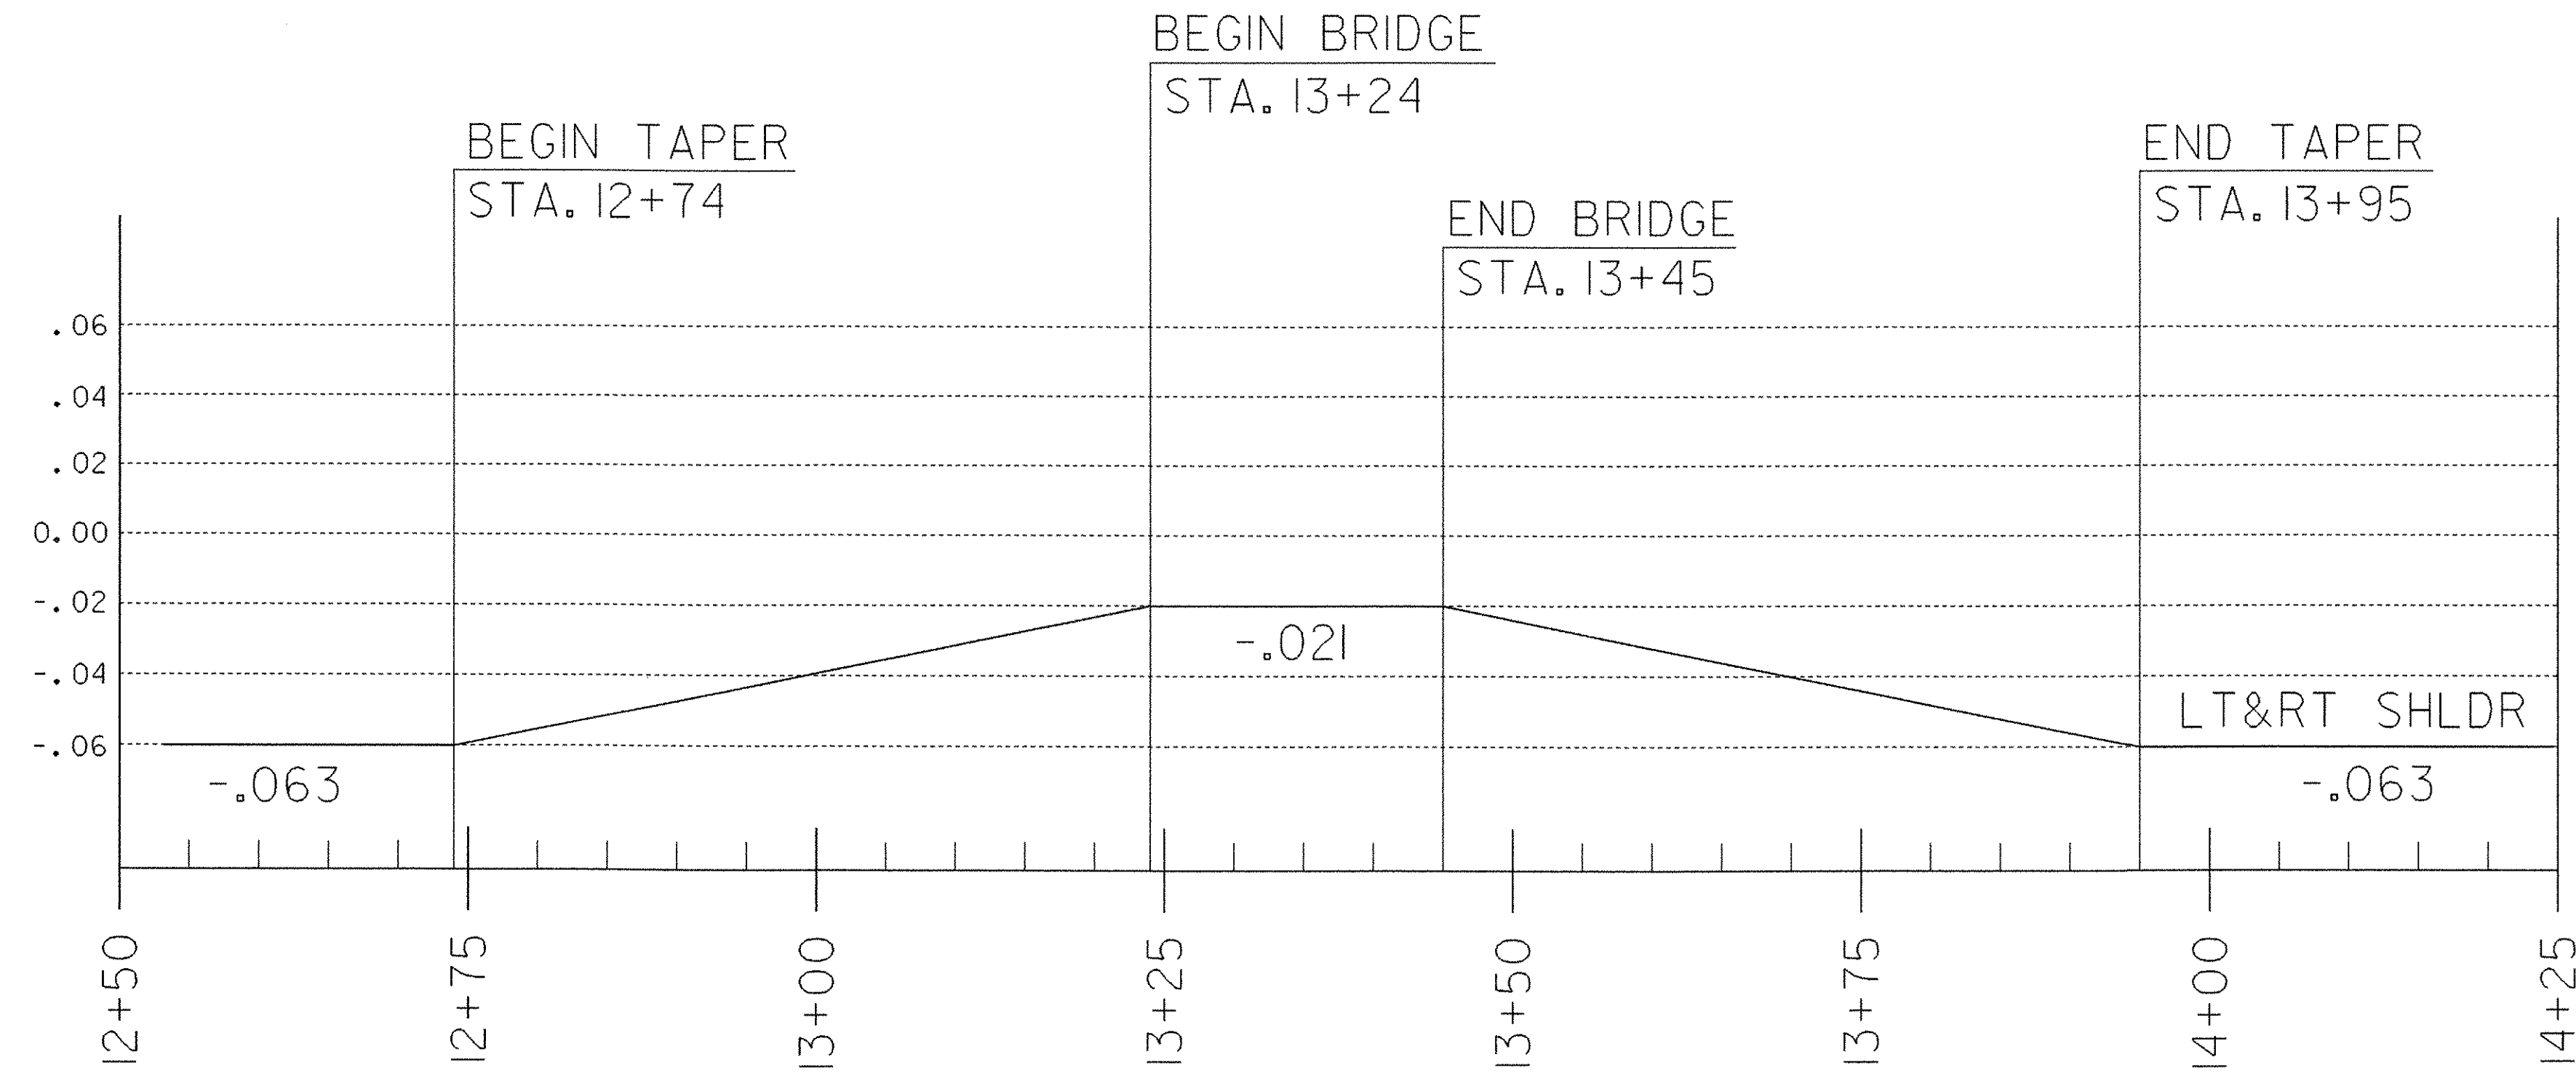


SHOULDER BANKING DIAGRAM

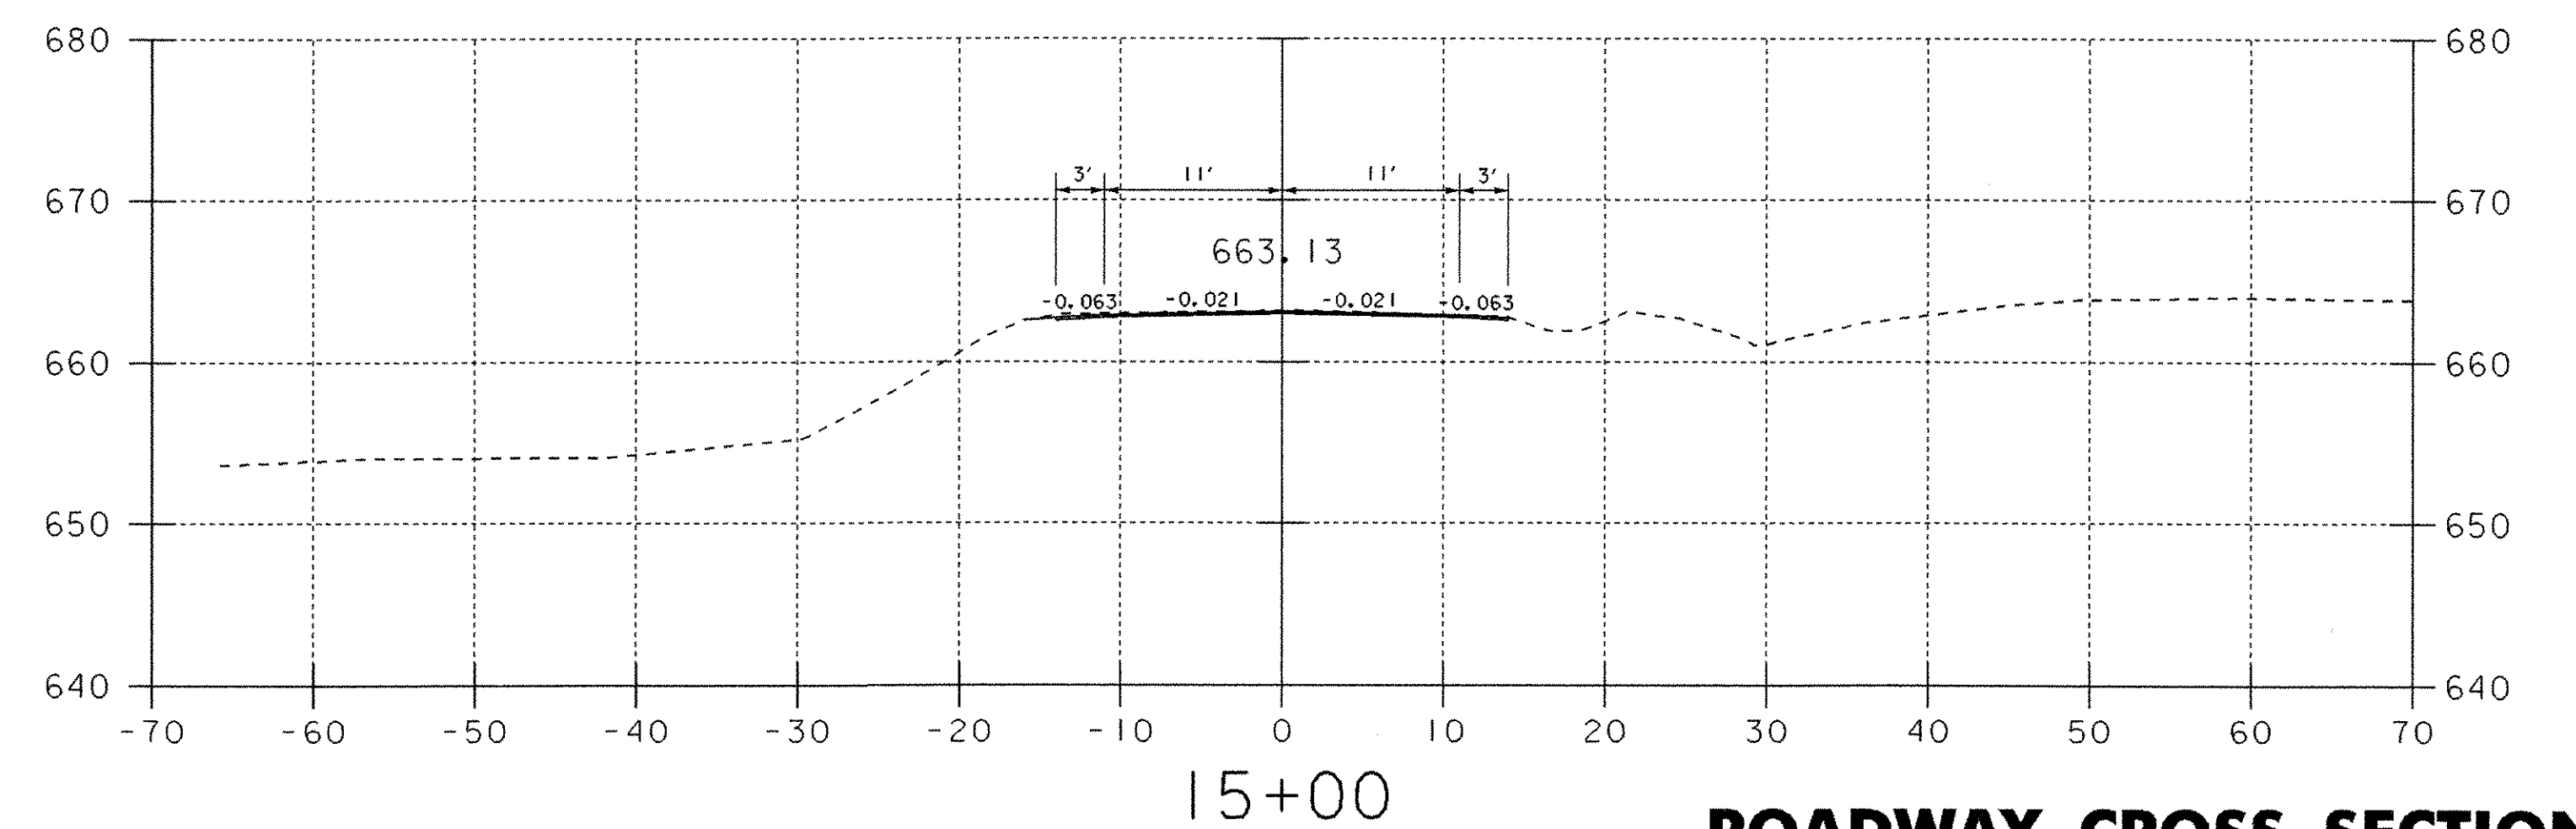

END APPROACH

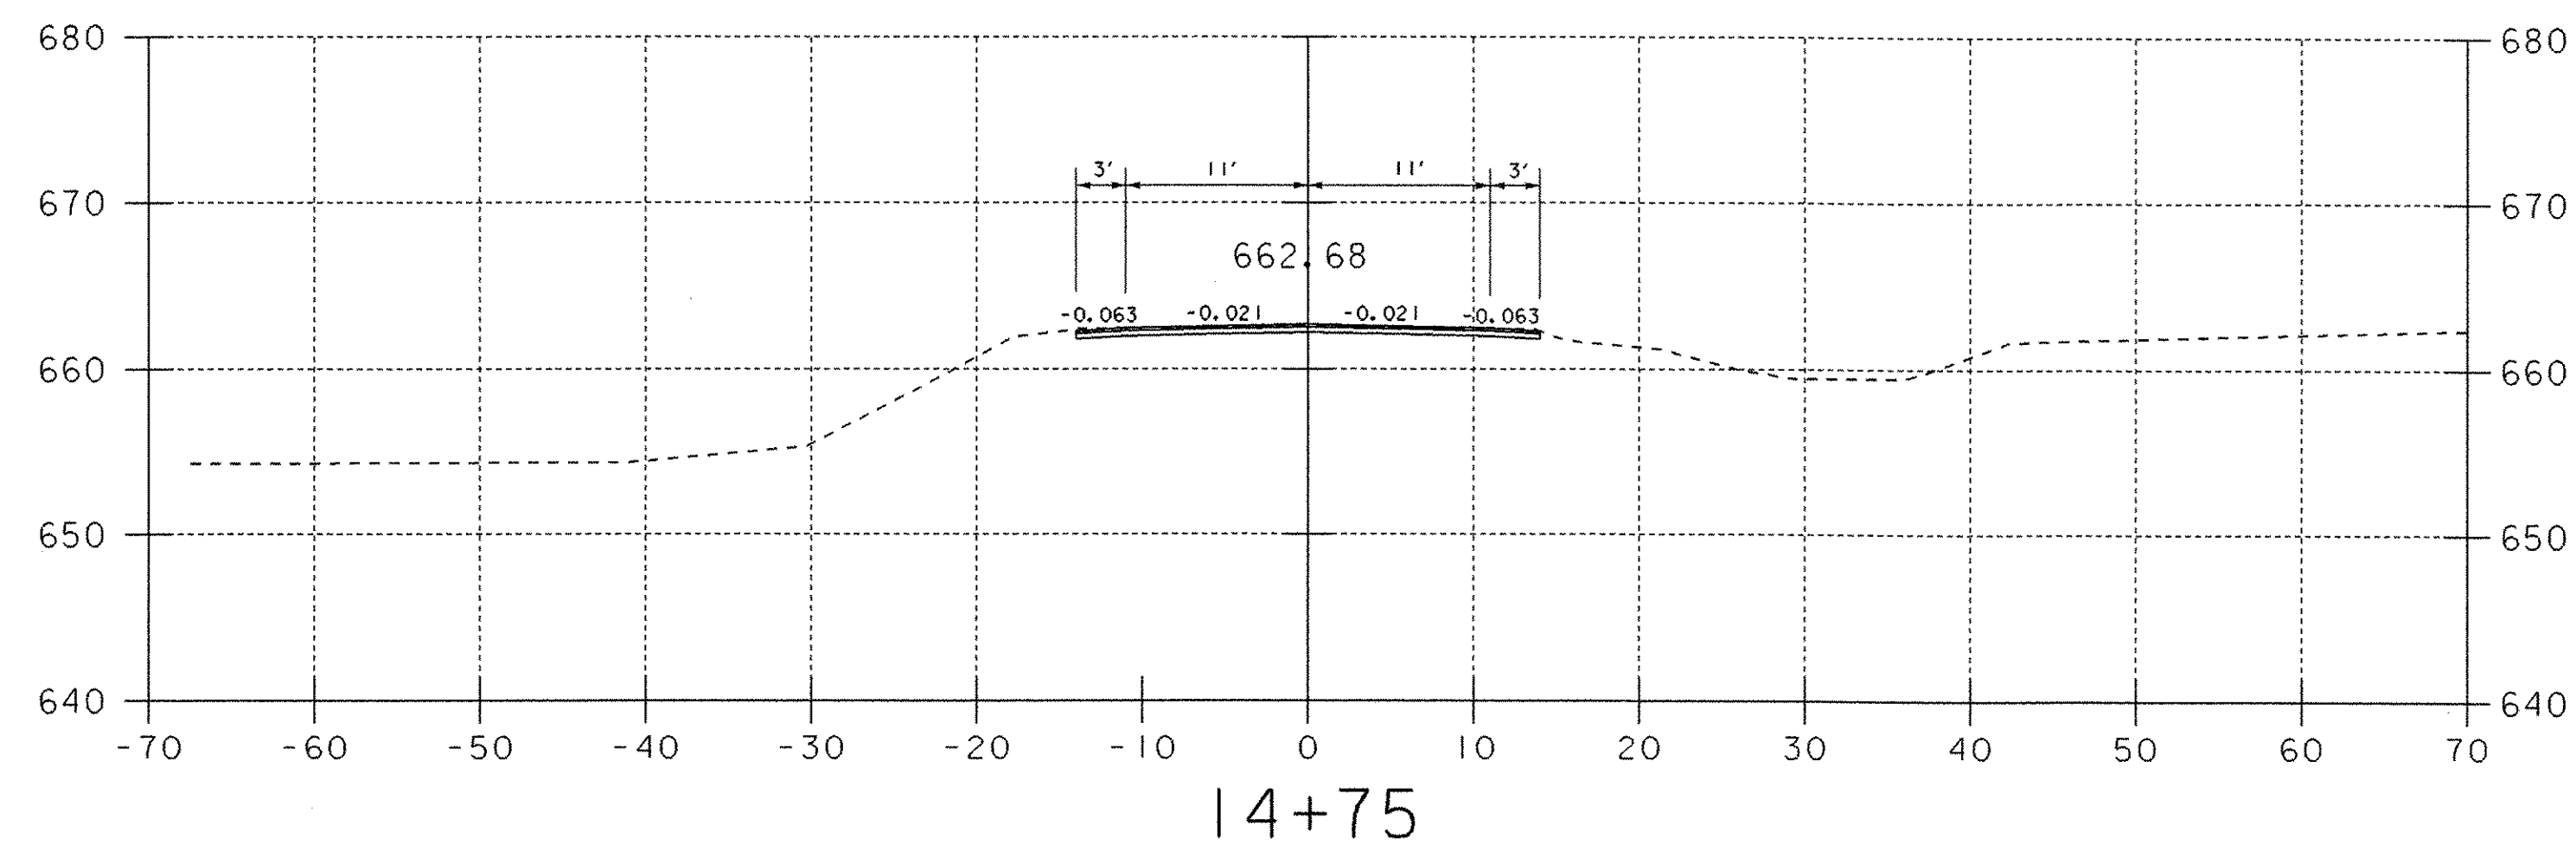

ROADWAY CROSS SECTIONS

PROJECT NAME: FAIRFIELD	
PROJECT NUMBER: AC STP ST 0298 (6)	
FILE NAME: str5/01c182/sc182bdr.dgn	PLOT DATE: 28-APR-2005
PROJECT LEADER: C. Keller	DRAWN BY: J. Reed
DESIGNED BY: J. Reed	CHECKED BY: W. B. Symonds
sc182xs5.i	SHEET 34 OF 41