



0+80

Chan. Sta. 0+84.3 Rt. (Abut. #2)
 End Unclassified Channel Excav.
 End Geotextile Fabric under Stone Fill
 End Stone Fill, type III
 End Grubbing Material

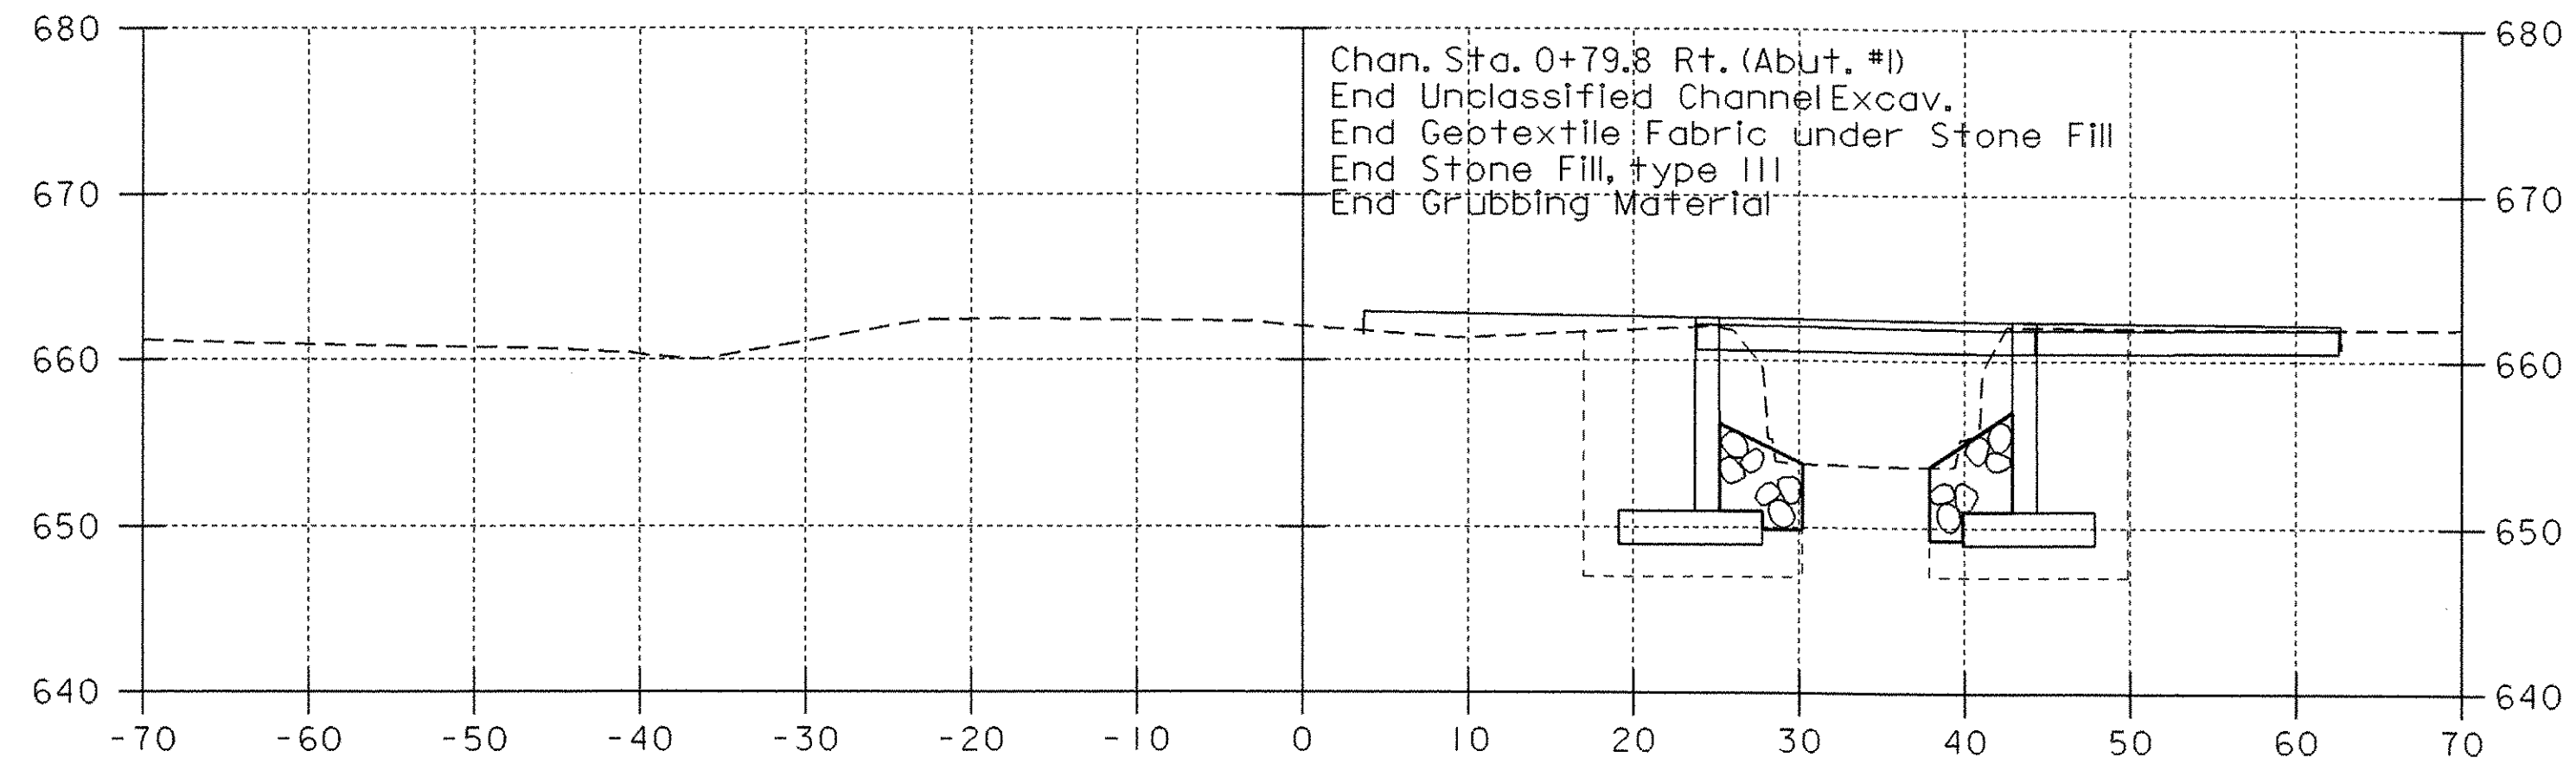


0+70

Chan. Sta. 0+79.8 Rt. (Abut. #1)
 End Unclassified Channel Excav.
 End Geotextile Fabric under Stone Fill
 End Stone Fill, type III
 End Grubbing Material

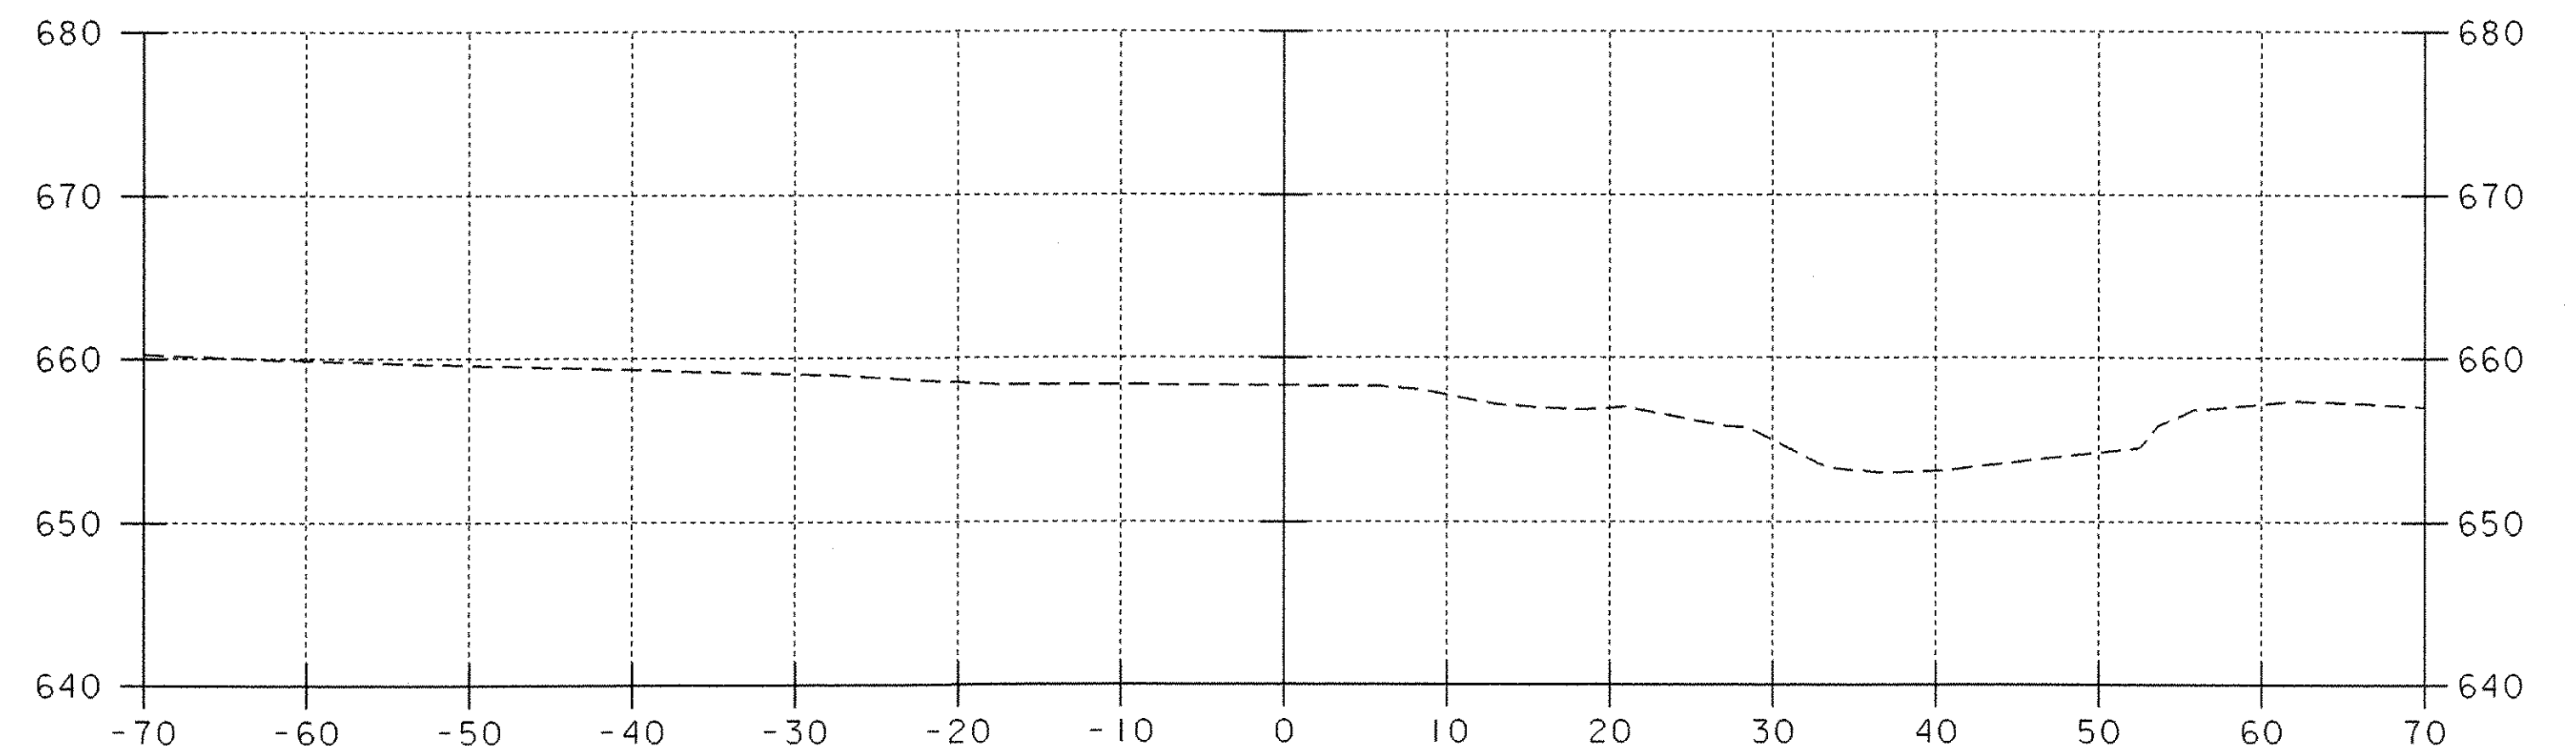


1+00

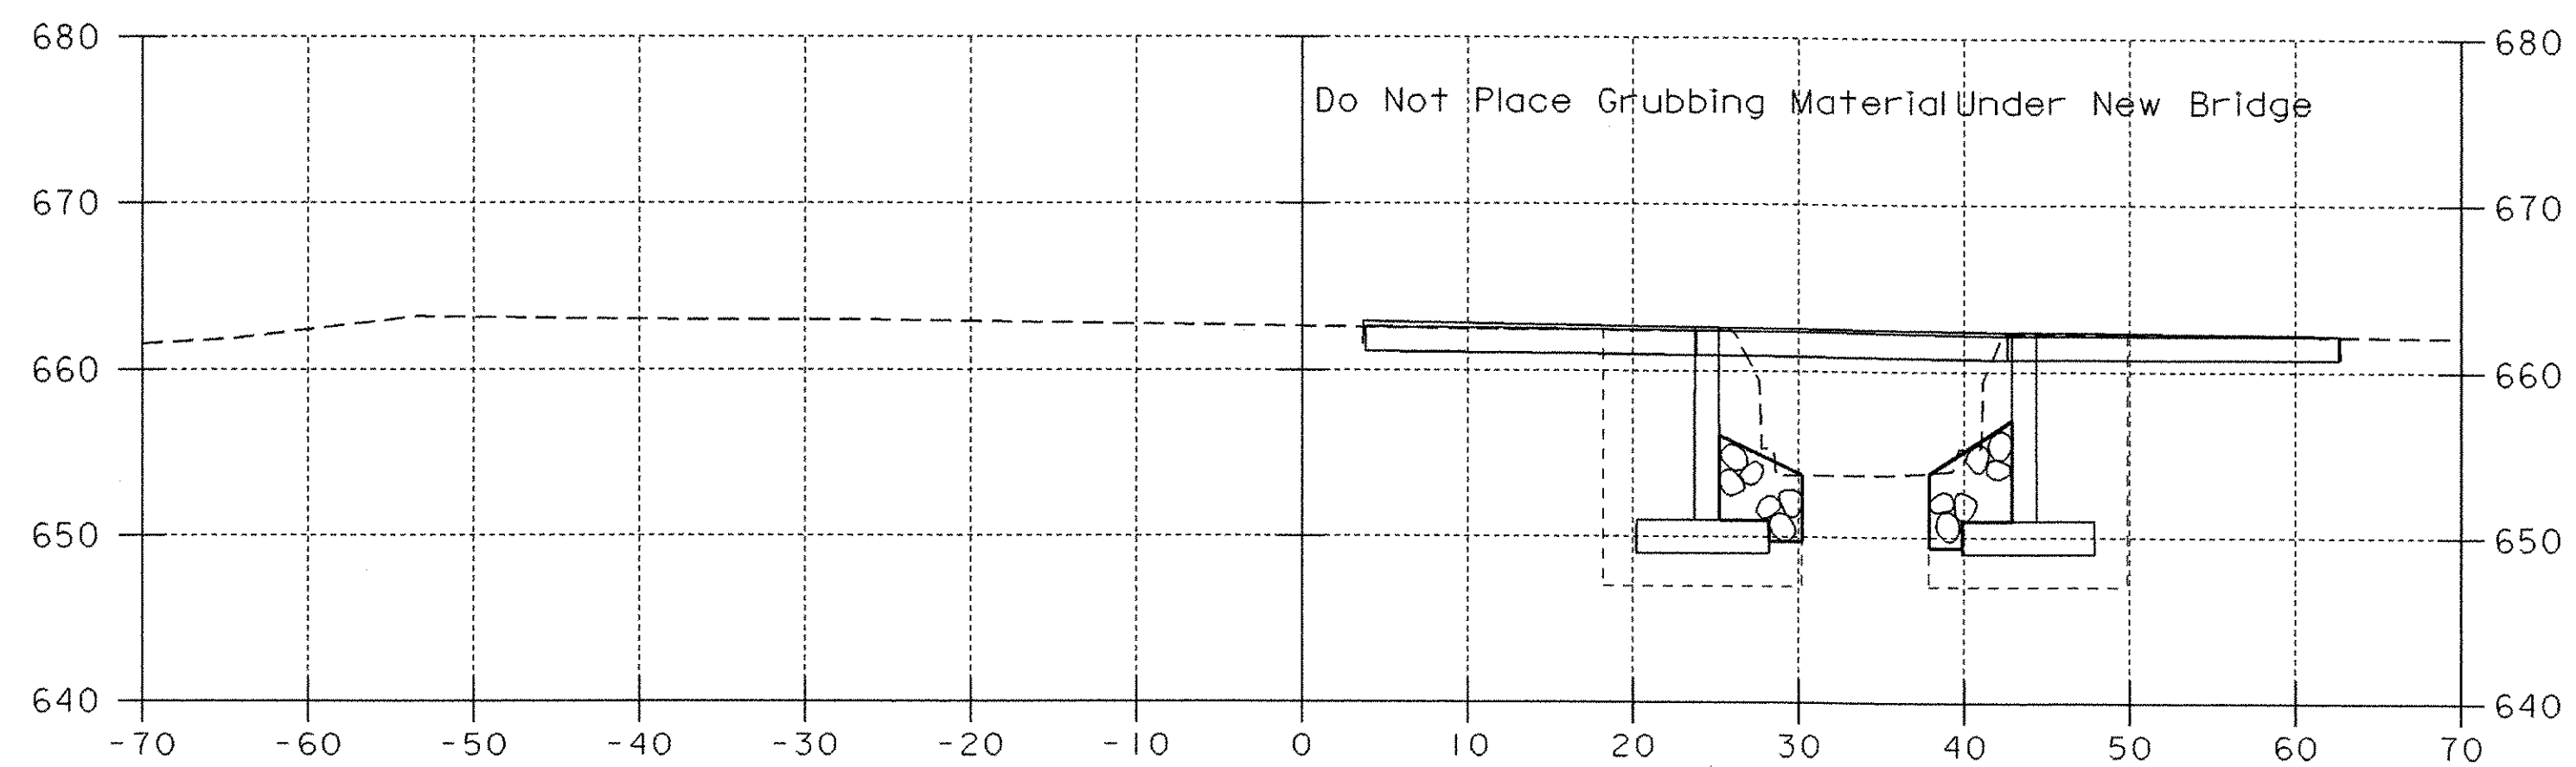

0+60

Do Not Place Grubbing Material Under New Bridge

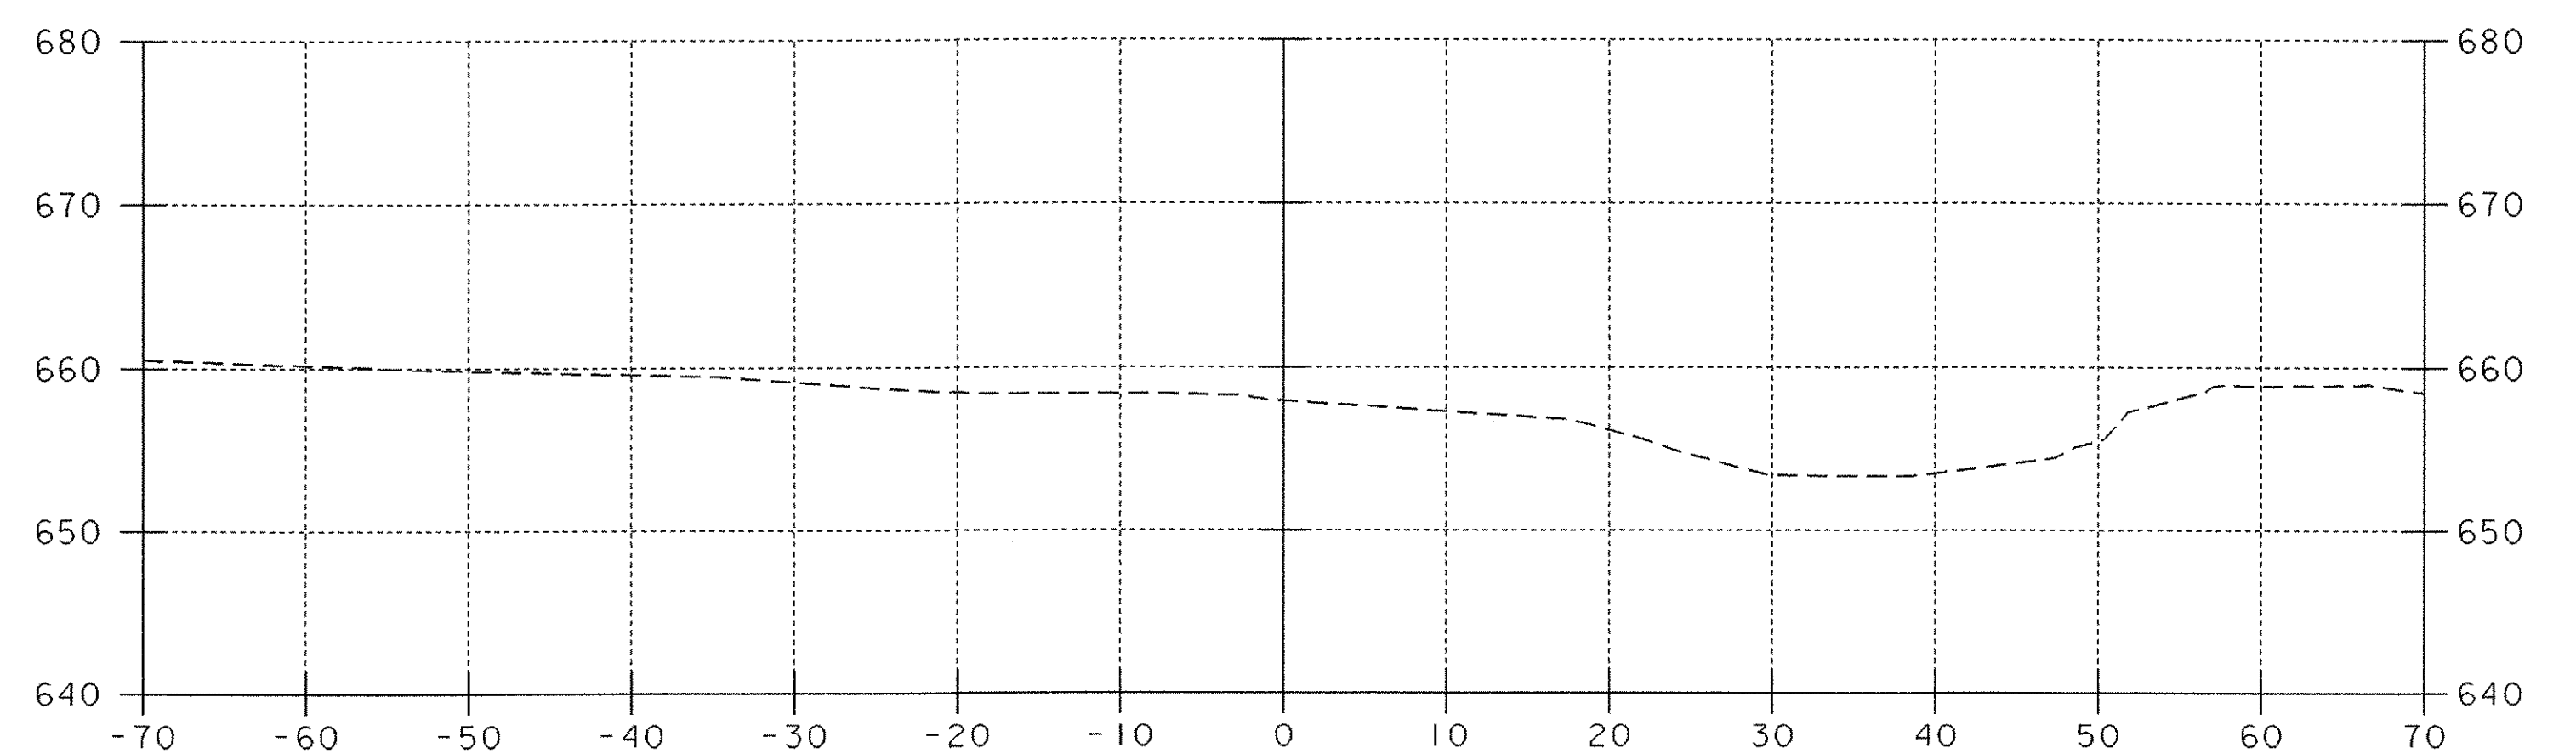

0+90

CHANNEL CROSS SECTIONS

PROJECT NAME:	FAIRFIELD	PLOT DATE:	28-APR-2005
PROJECT NUMBER:	AC STP ST 0298 (6)	DRAWN BY:	J. Reed
FILE NAME:	str5/01c182/sc182bdr.dgn	CHECKED BY:	W.B. Symonds
PROJECT LEADER:	C. Keller	SHEET	36 OF 41
DESIGNED BY:	J. Reed		
sc182cs2.i			