




0+47.5

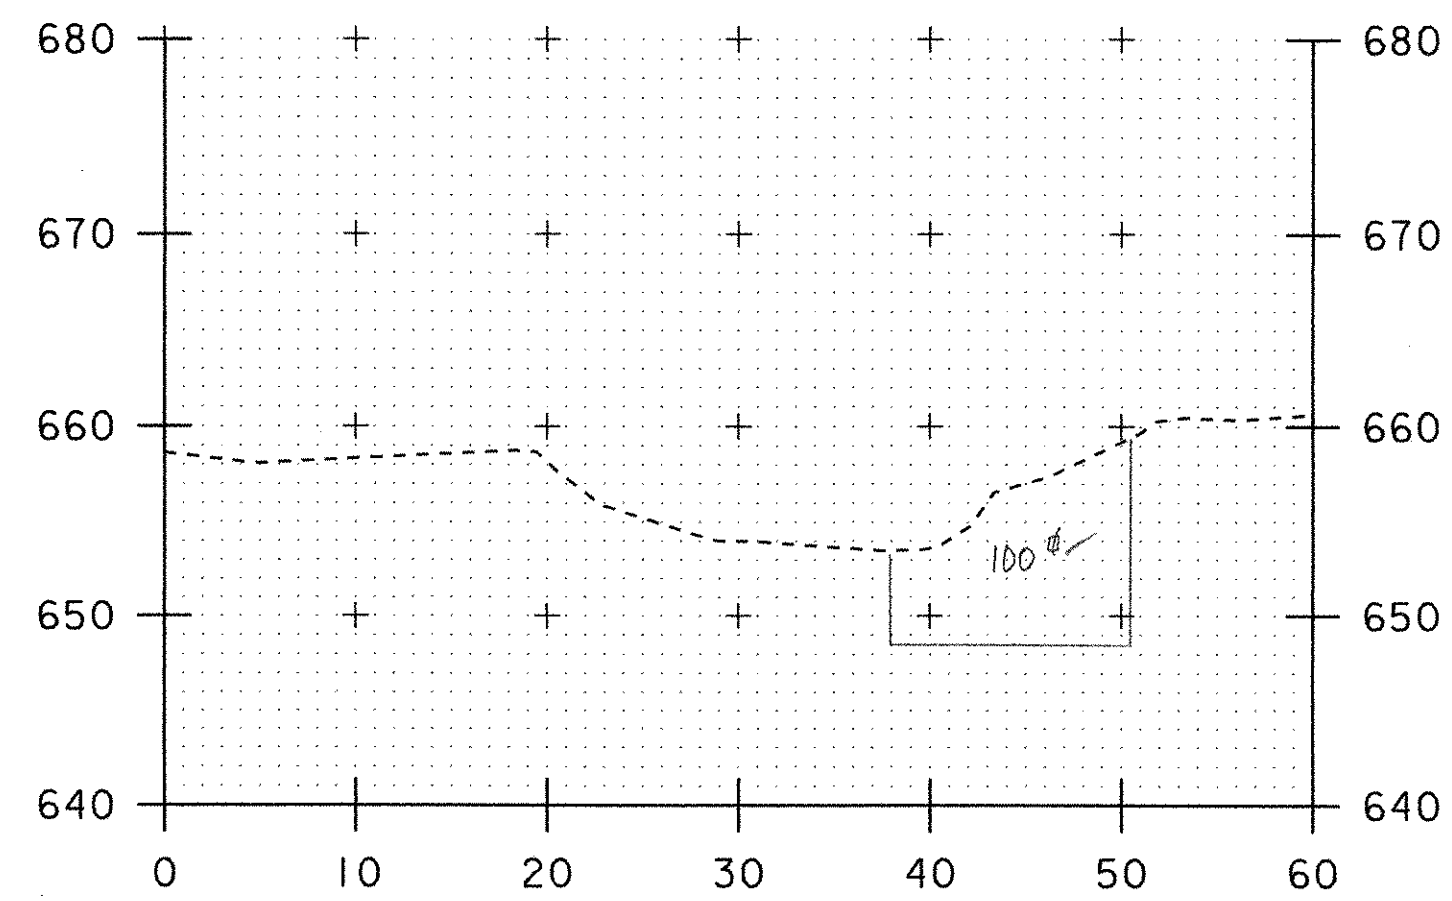


0+80.5

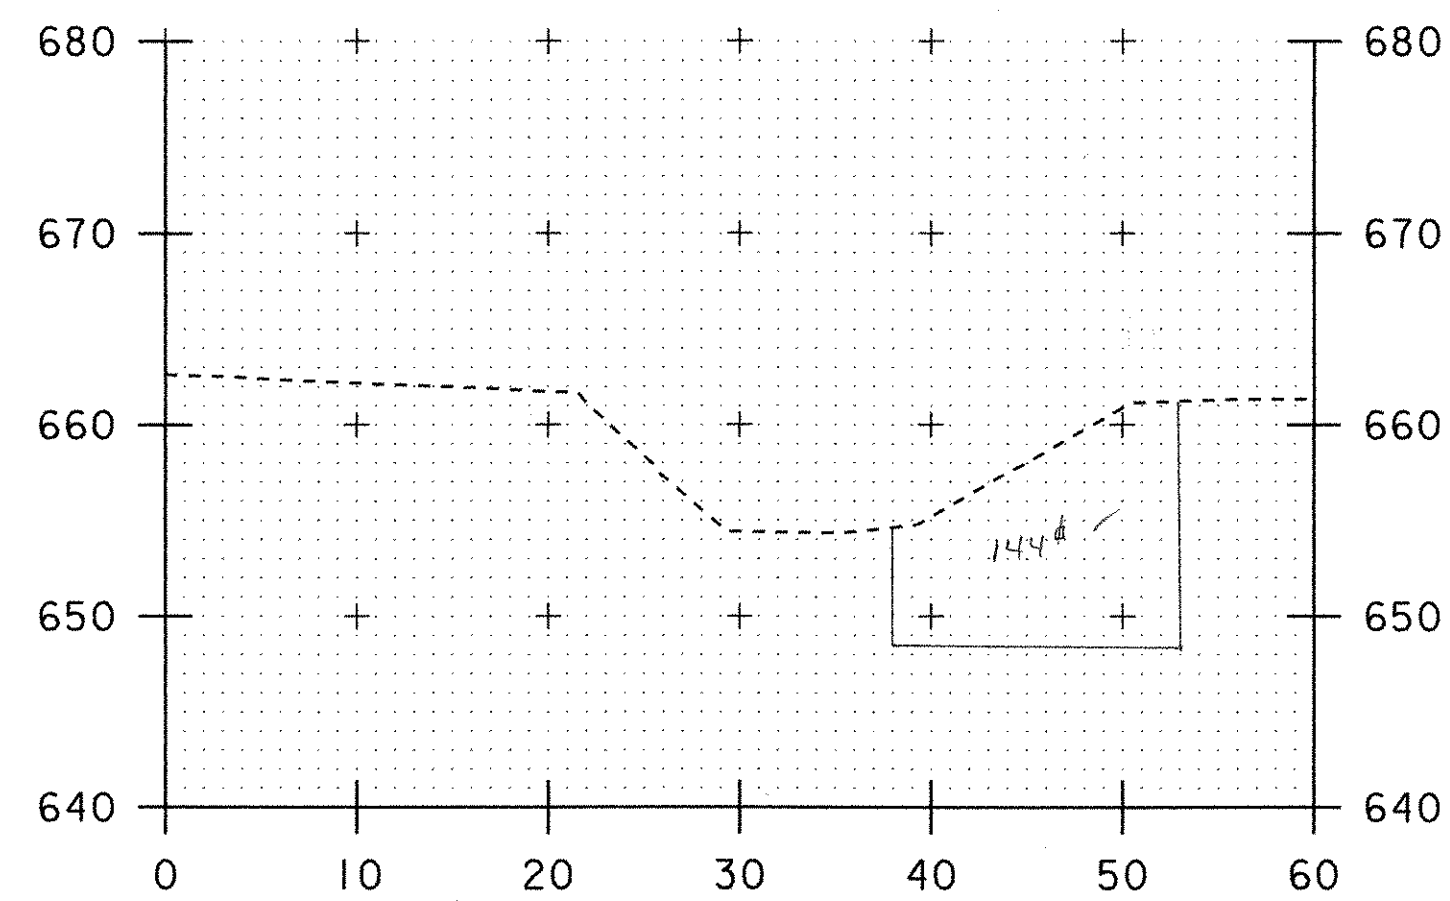


0+36

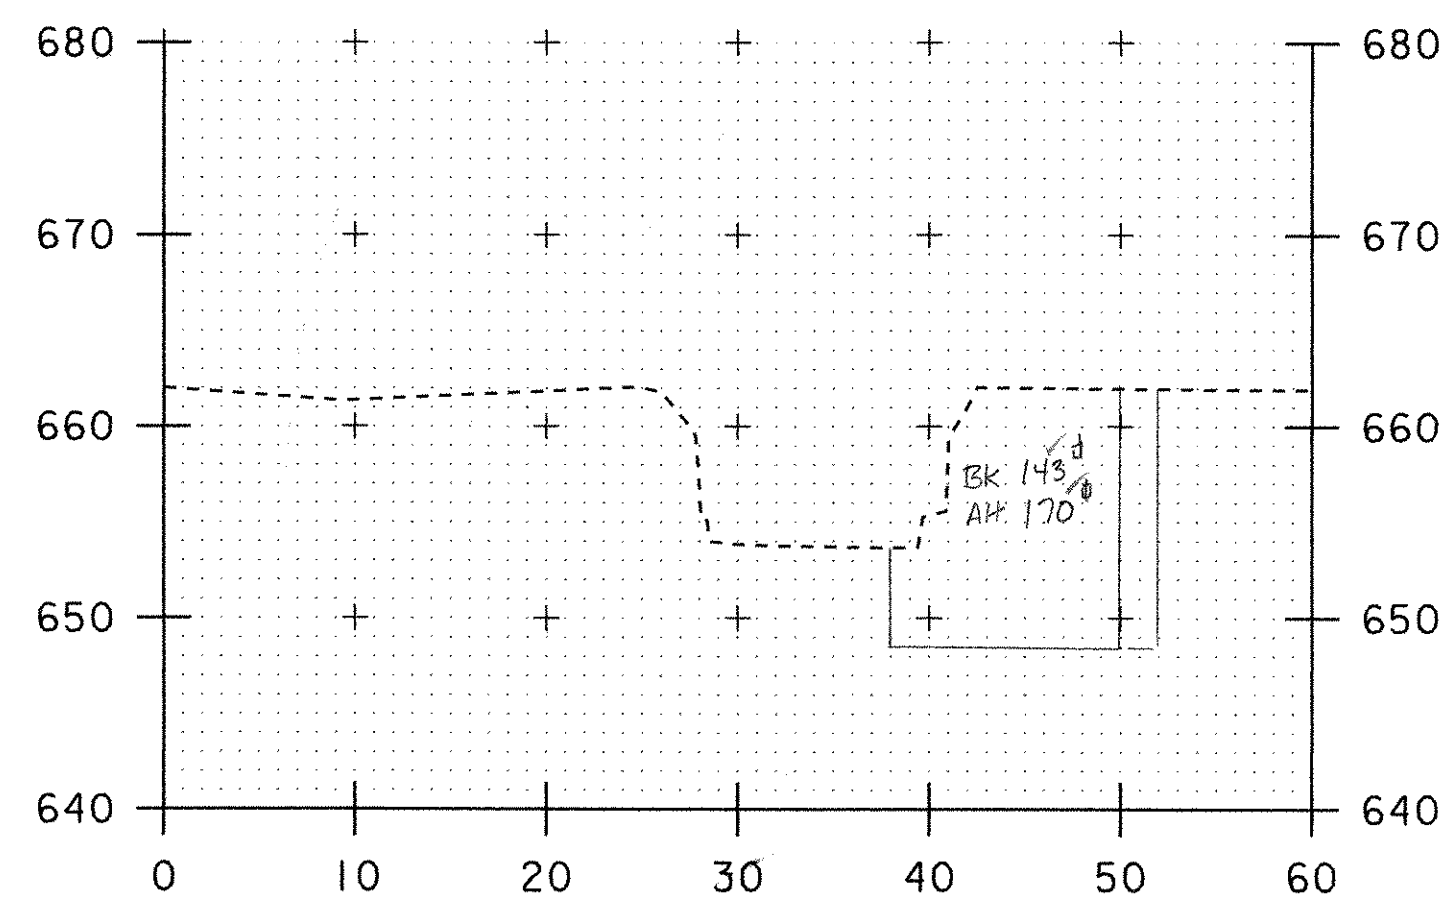


0+70

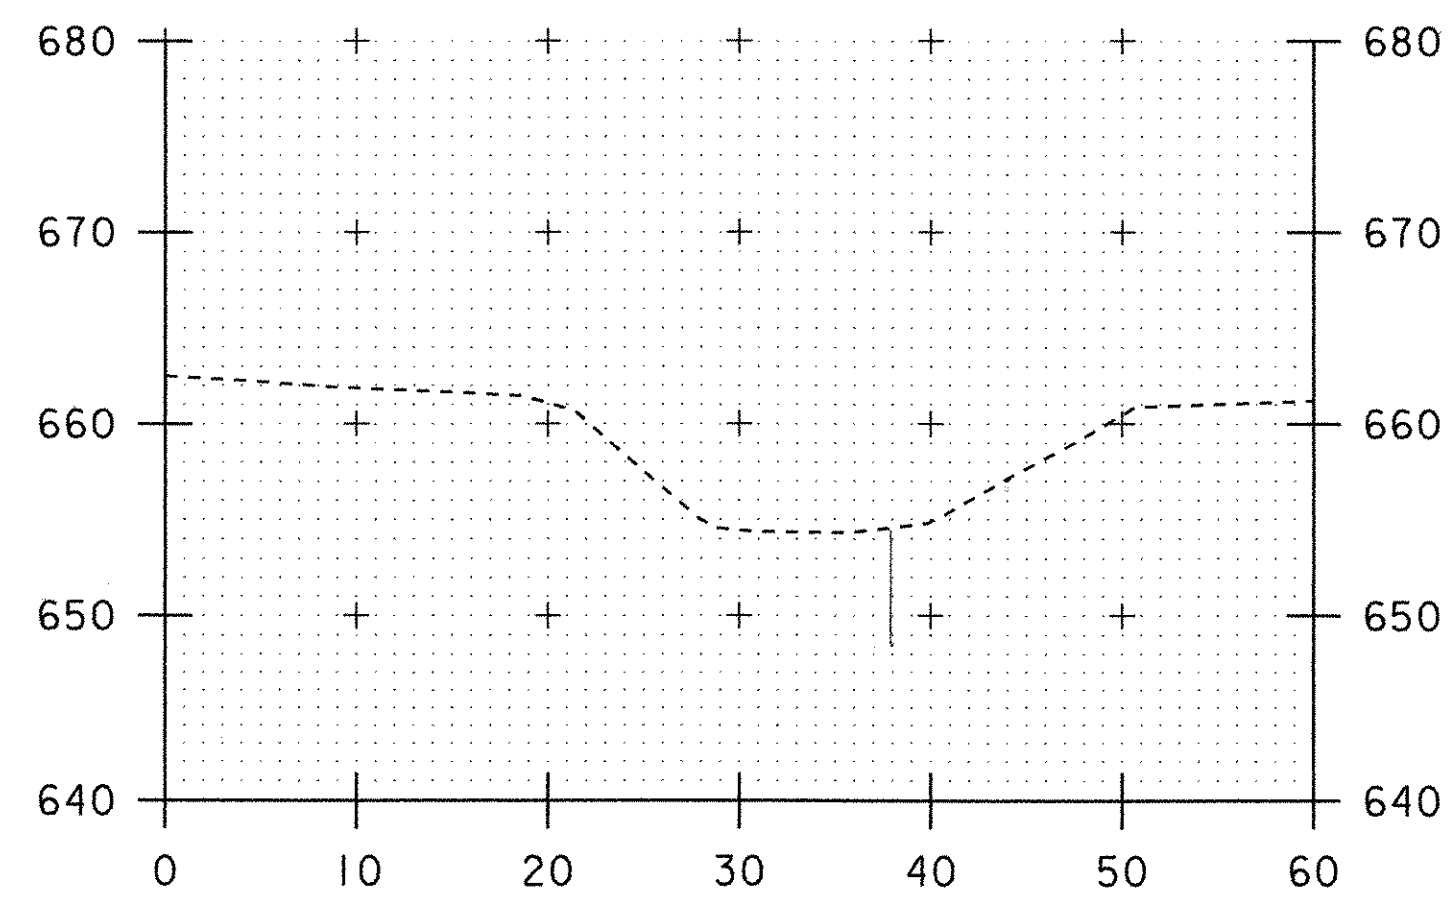

0+33

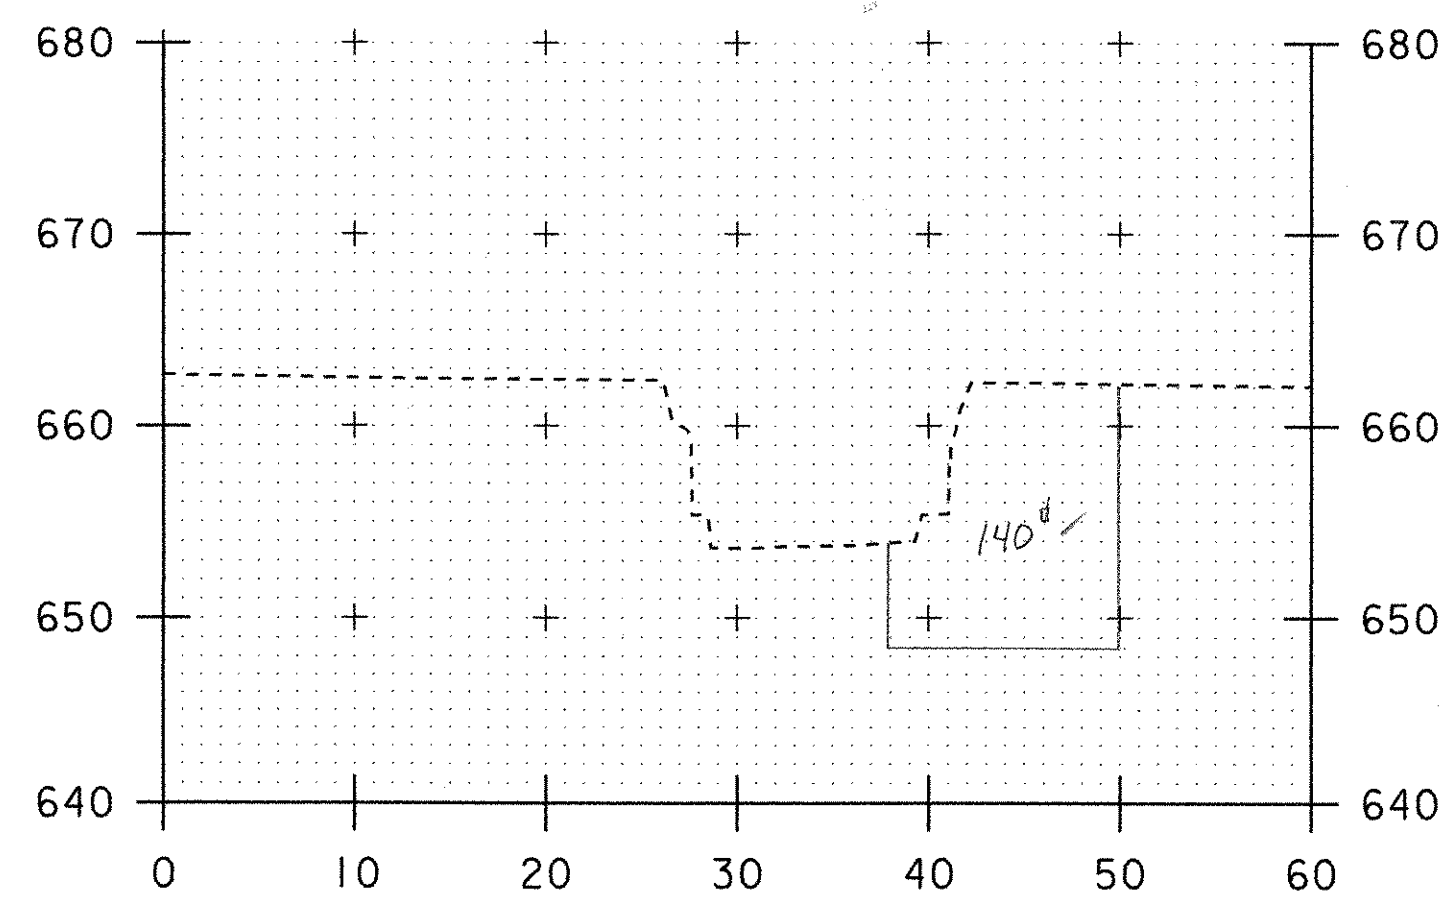

0+58

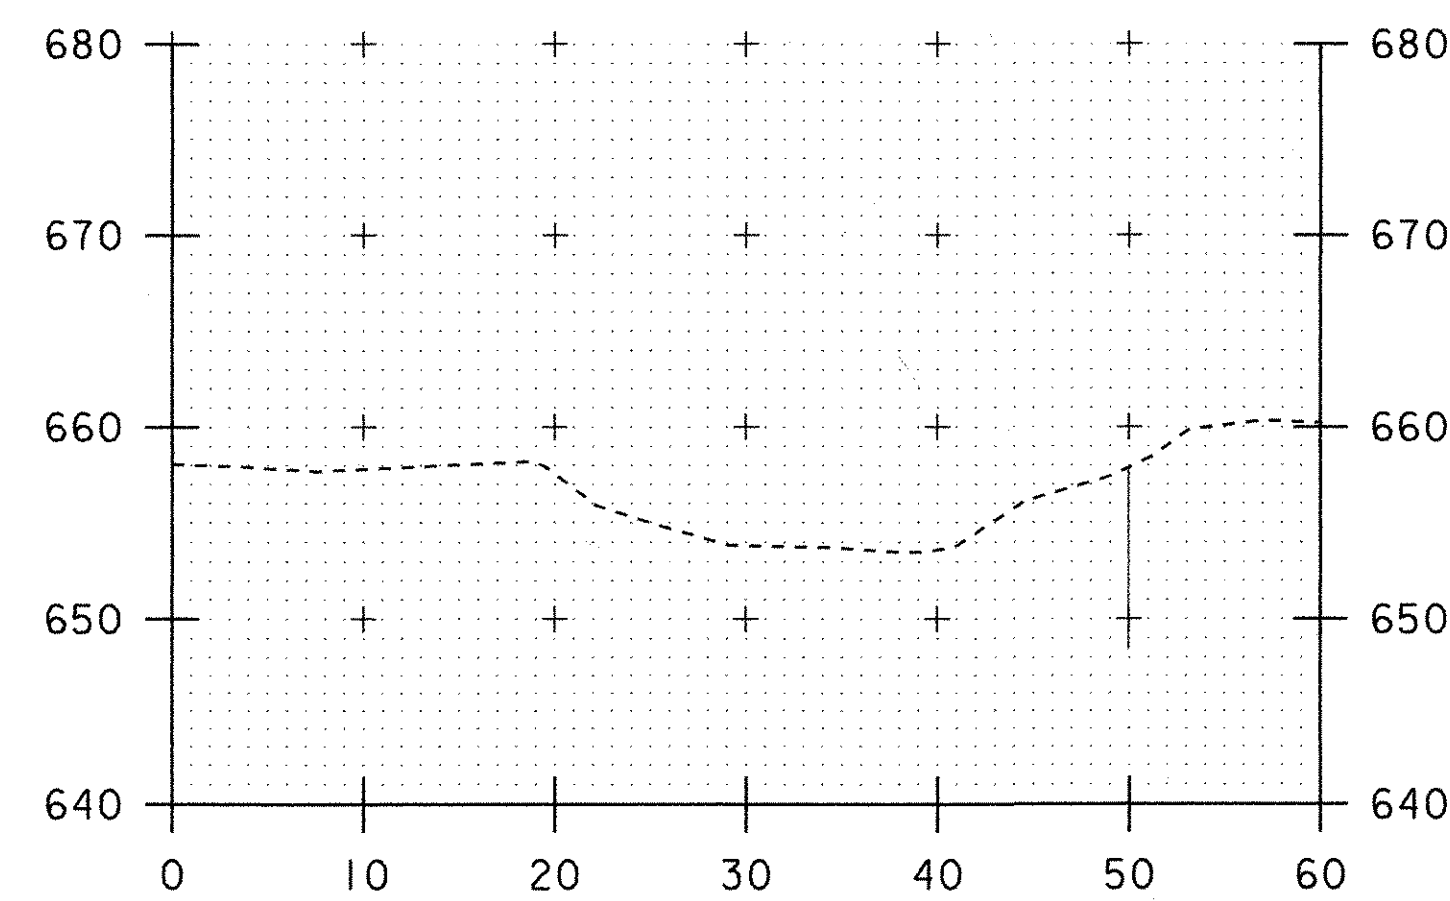

0+83

CHANNEL CROSS SECTIONS

PROJECT NAME:	FAIRFIELD	PLOT DATE:	09-AUG-2005
PROJECT NUMBER:	AC STP ST 0298 (6)	DRAWN BY:	G. Shangraw
FILE NAME:	str5/01c182/sc182bdr.dgn	CHECKED BY:	
PROJECT LEADER:	C. Keller	SHEET	043 OF
DESIGNED BY:	J. Reed		