

150mm (FOR "BIKE LANES" TYP.)

TEMPORARY AND DURABLE 100mm WHITE LINE
 STA 6+872 TO 7+020 SOLID LT
 STA 6+872 TO 7+020 SOLID RT

TEMPORARY AND DURABLE 100mm YELLOW LINE
 STA 6+872 TO 7+020 SOLID LT & RT


ADJUST ELEVATION OF VALVE BOX
 STA 6+877 LT
 STA 6+932 RT
 STA 6+995 LT
 STA 6+997 LT
 STA 7+000 LT

CHANGING ELEV. OF DI, CB, OR MH
 STA 6+873 RT (CB)
 STA 6+889 RT (CB)

CHANGING ELEVATION OF SEWER MANHOLE
 STA 6+981 RT



~~REMOVING SIGNS AS SHOWN = 2~~ NONE

VT ROUTE 9
STA 6+871.90 + 885
(MM 4.270)
BEGIN PROJECT
ST-STP 2303(1)S
END NH 2109(1)S

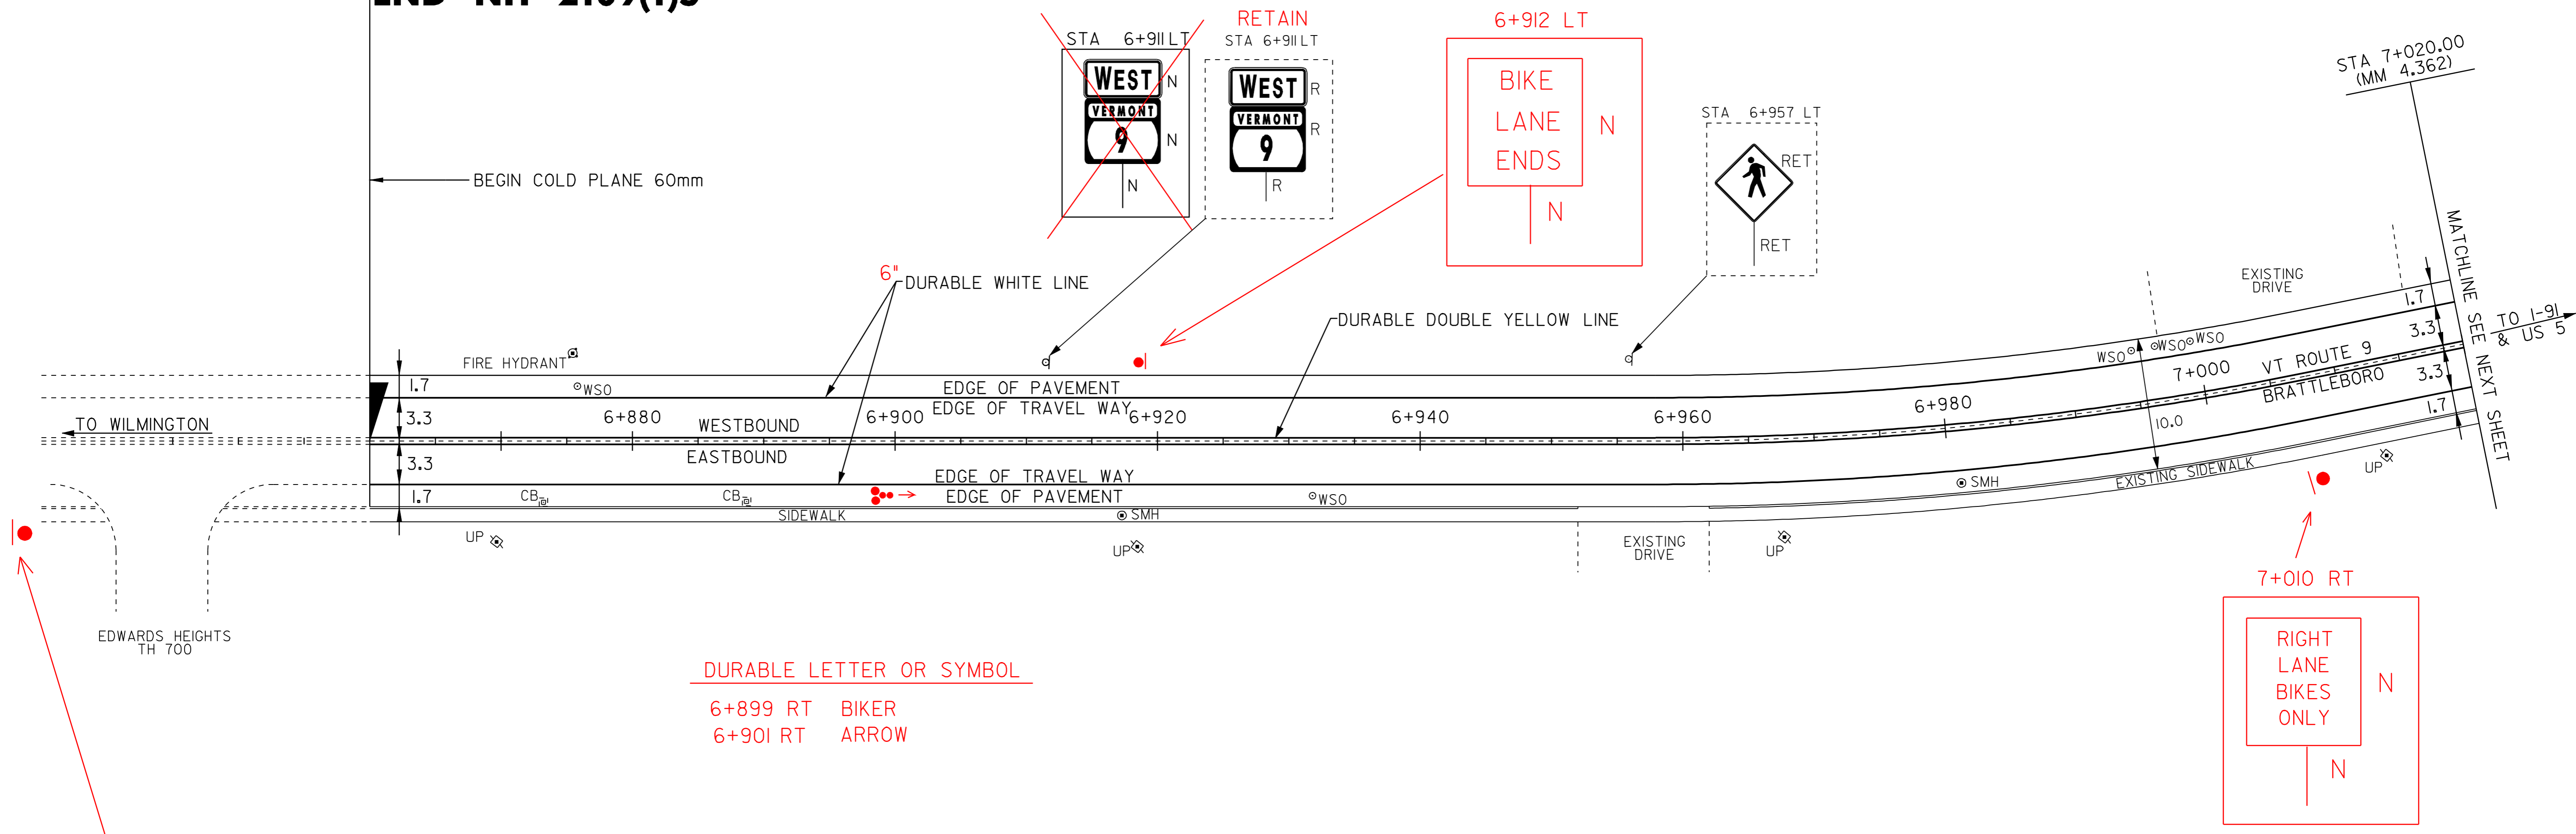

DURABLE LETTER OR SYMBOL

- 6+899 RT BIKER
- 6+901 RT ARROW

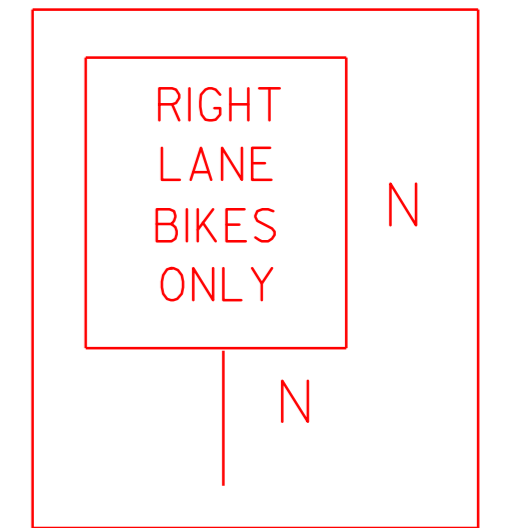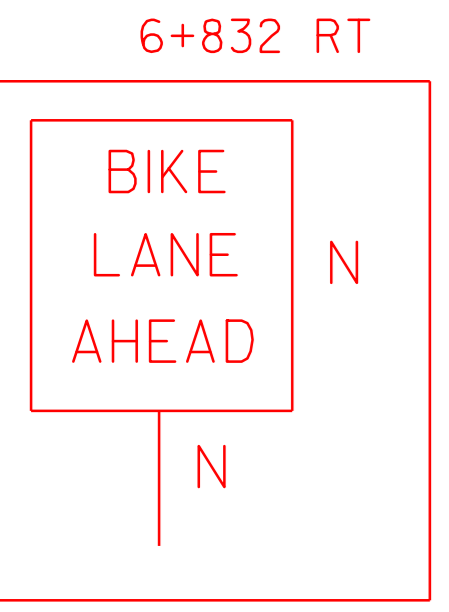

LEGEND

R	=	REMOVE EXISTING
S	=	SALVAGE
R&S	=	REMOVE AND SALVAGE
N	=	NEW
RET	=	RETAIN
B-B	=	BACK TO BACK

NOTE: ALL DIMENSIONS IN METERS EXCEPT AS INDICATED

PAVING PROJECT LAYOUT #1	PROJECT NAME: BRATTLEBORO	PLOT DATE: \$DATE\$
	PROJECT NUMBER: ST-STP 2303(1)S	DRAWN BY: JAC
	FILE NAME: /PAVE/01026/PD026.dgn	CHECKED BY: NLL
	PROJECT LEADER: WRH	SHEET 8 OF 55
DESIGNED BY: -		
CLD REF. NO.: pd026101		

NOT TO SCALE