

TEMPORARY AND DURABLE 100mm WHITE LINE

STA 7+020 TO 7+035 SOLID LT
 STA 7+020 TO 7+116 SOLID RT
 STA 7+035 TO 7+040 SOLID LT (TH 702)
 STA 7+048 TO 7+053 SOLID LT (TH 702)
 STA 7+053 TO 7+200 SOLID LT
 STA 7+116 TO 7+121 SOLID RT (TH 705)
 STA 7+128 TO 7+132 SOLID RT (TH 705)
 STA 7+132 TO 7+200 SOLID RT

TEMPORARY AND DURABLE 100mm YELLOW LINE

STA 7+020 TO 7+037 SOLID LT/RT
 STA 7+043 DOUBLE SOLID LT (TH 702)
 STA 7+049 TO 7+116 SOLID LT/RT
 STA 7+122 RT, ISLAND EDGE LINE
 STA 7+128 TO 7+200 SOLID LT/RT

TEMPORARY 600mm STOP BAR

STA 7+040 LT (TH 702)
 STA 7+124 RT (TH 705)

DURABLE 600mm STOP BAR (TYPE-TAPE)

STA 7+040 LT (TH 702)
 STA 7+124 RT (TH 705)

TEMPORARY LETTERS OR SYMBOLS

STA 7+041 LT - "STOP" (TH 702)
 STA 7+125 RT - "STOP" (TH 705)
 7+167 RT - BIKER 7+169 RT ARROW
 DURABLE LETTER OR SYMBOL (TYPE-TAPE)
 STA 7+041 LT - "STOP" (TH 702)
 STA 7+125 RT - "STOP" (TH 705)

TEMPORARY CROSSWALK MARKINGS W/DIAGONAL LINES

STA 7+110 TO 7+135 RT

DURABLE CROSSWALK MARKINGS W/DIAGONAL LINES (MOD)

STA 7+110 TO 7+135 RT

CHANGING ELEV. OF DI, CB, OR MH

STA 7+034 LT (CB)
 STA 7+043 RT (CB)
 STA 7+115 RT (CB) -TH 705
 STA 7+130 RT (CB) -TH 705

CHANGING ELEVATION OF SEWER MANHOLE

STA 7+039 LT
 STA 7+084 LT

PAINTED CURB

STA 7+122 RT (ISLAND)



ADJUST ELEVATION OF VALVE BOX

STA 7+030 LT
 STA 7+114 RT
 STA 7+200 RT

REMOVING SIGNS
 AS SHOWN - 15 ✓

ERECTING SALVAGED SIGNS
 AS SHOWN - 6

DURABLE WHITE EDGE LINES, ON MAINLINE, ARE 6" FOR ADDED BIKE LANE (THIS SHEET)

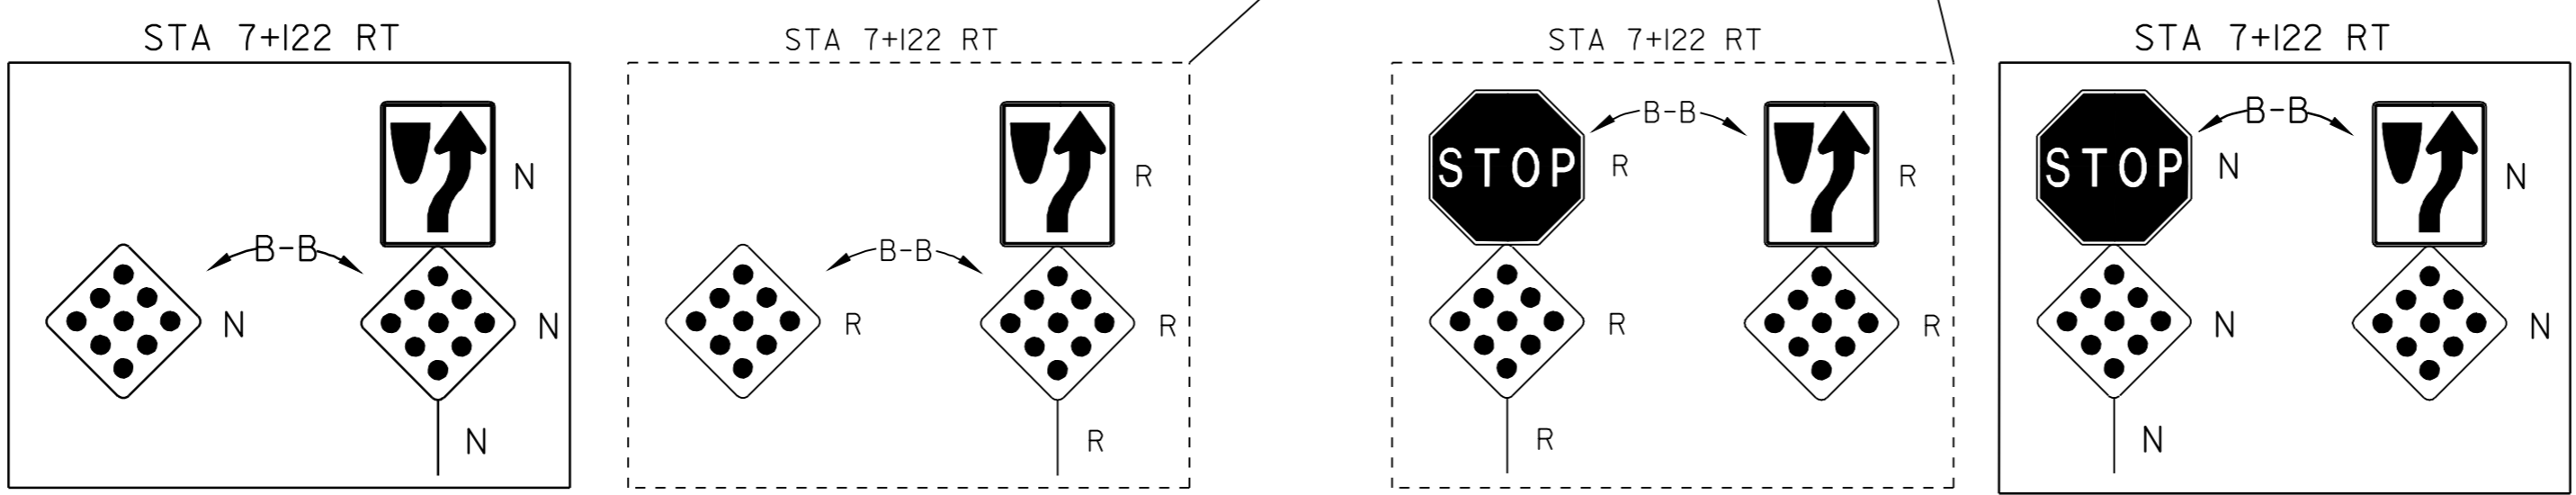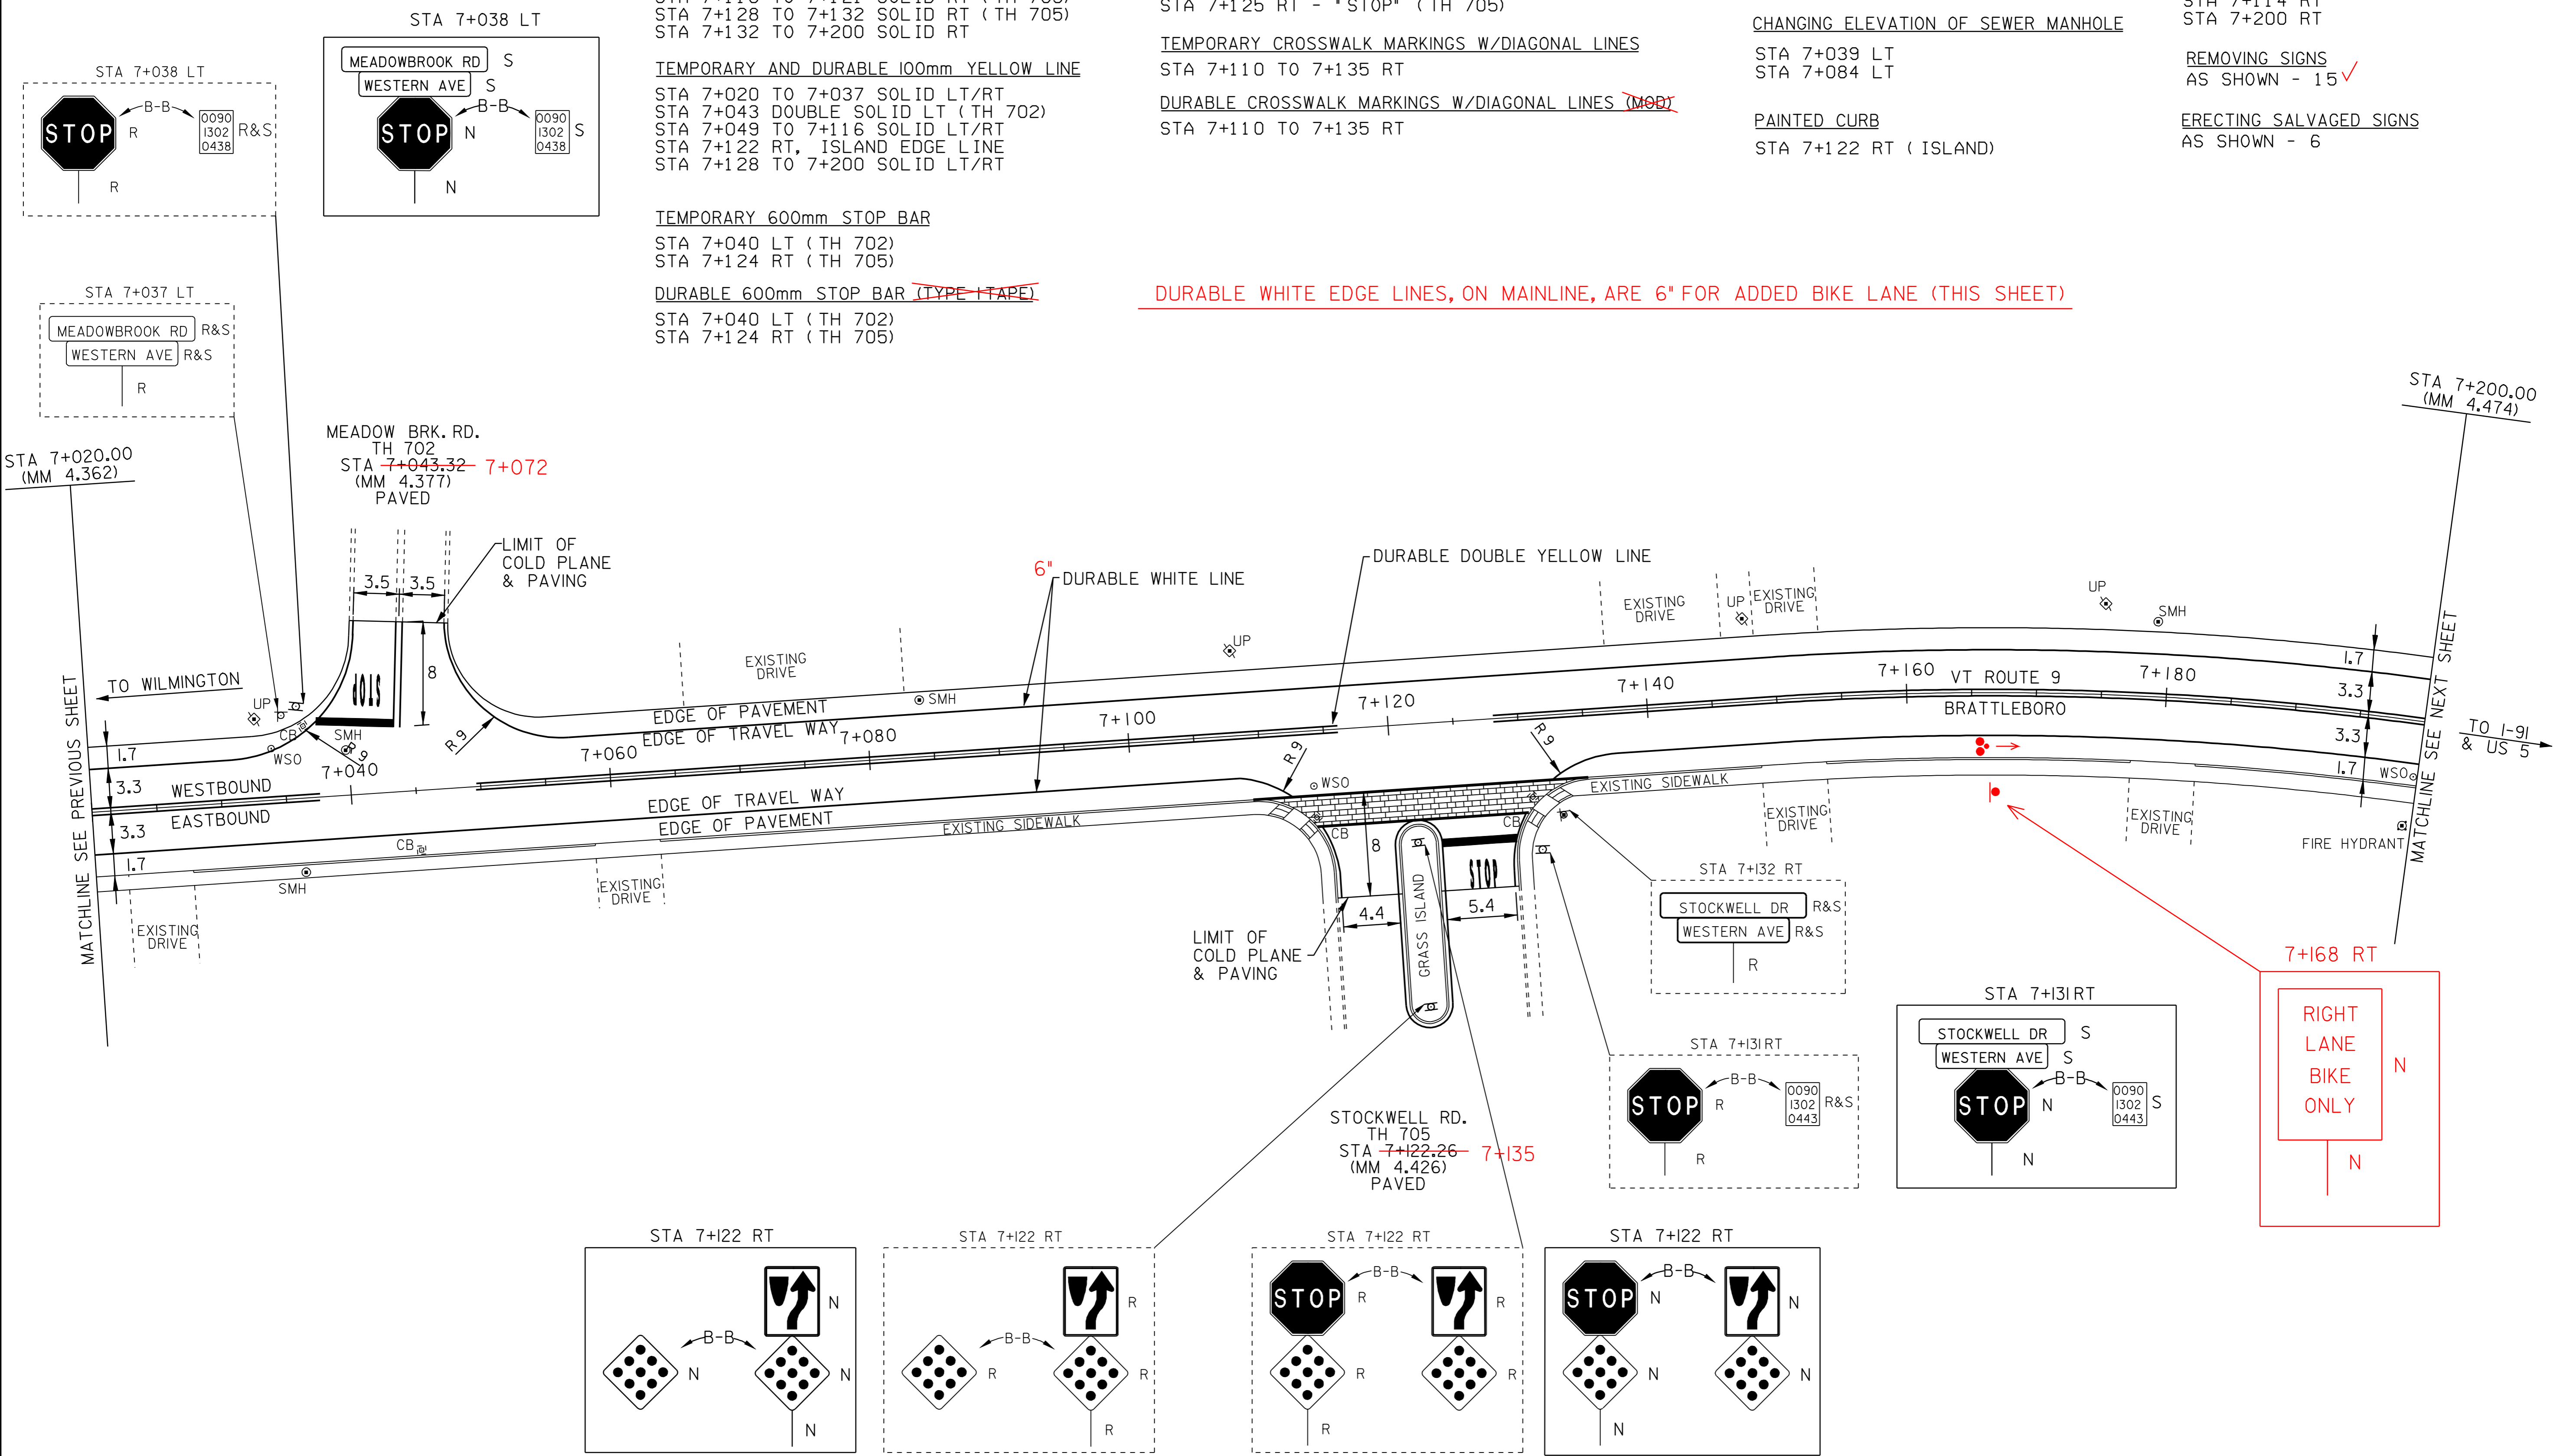

LEGEND

- R = REMOVE EXISTING
- S = SALVAGE
- R&S = REMOVE AND SALVAGE
- N = NEW
- RET = RETAIN
- B-B = BACK TO BACK

NOTE: ALL DIMENSIONS IN METERS EXCEPT AS INDICATED

NOT TO SCALE

PAVING PROJECT LAYOUT #2	PROJECT NAME: BRATTLEBORO
	PROJECT NUMBER: SI-STP_2303(I)S
	FILE NAME: \PAVE\QID026\PD026.dgn
	CLD REF. NO.: p026102.1
PLLOT DATE: \$DATE\$	DRAWN BY: JAC
DESIGNED BY: WRH	CHECKED BY: NLL
SHEET 9 OF 55	