

TEMPORARY AND DURABLE 100mm WHITE LINE

STA 7+200 TO 7+289 SOLID LT
 STA 7+200 TO 7+380 SOLID RT
 STA 7+289 TO 7+292 SOLID LT (TH 704)
 STA 7+292 TO 7+320 SOLID LT (TH 704)
 STA 7+320 TO 7+380 SOLID LT

TEMPORARY AND DURABLE 100mm YELLOW LINE

STA 7+200 TO 7+297 SOLID LT & RT
 STA 7+309 TO 7+380 SOLID LT & RT

ADJUST ELEVATION OF VALVE BOX

STA 7+301 RT
 STA 7+380 RT

SHOULDER BERM REMOVAL

STA 7+204 TO 7+290 LT
 STA 7+301 TO 7+331 RT
 STA 7+303 TO 7+331 LT
 STA 7+337 TO 7+356 LT

CHANGING ELEV. OF DI, CB, OR MH


STA 7+327 RT (CB)
 STA 7+367 LT (CB)
 STA 7+367 RT (CB)

CHANGING ELEVATION OF SEWER MANHOLE

STA 7+215 LT
 STA 7+253 LT
 STA 7+295 LT

DURABLE LETTER OR SYMBOL

7+290 LT ARROW
 7+292 LT BIKER

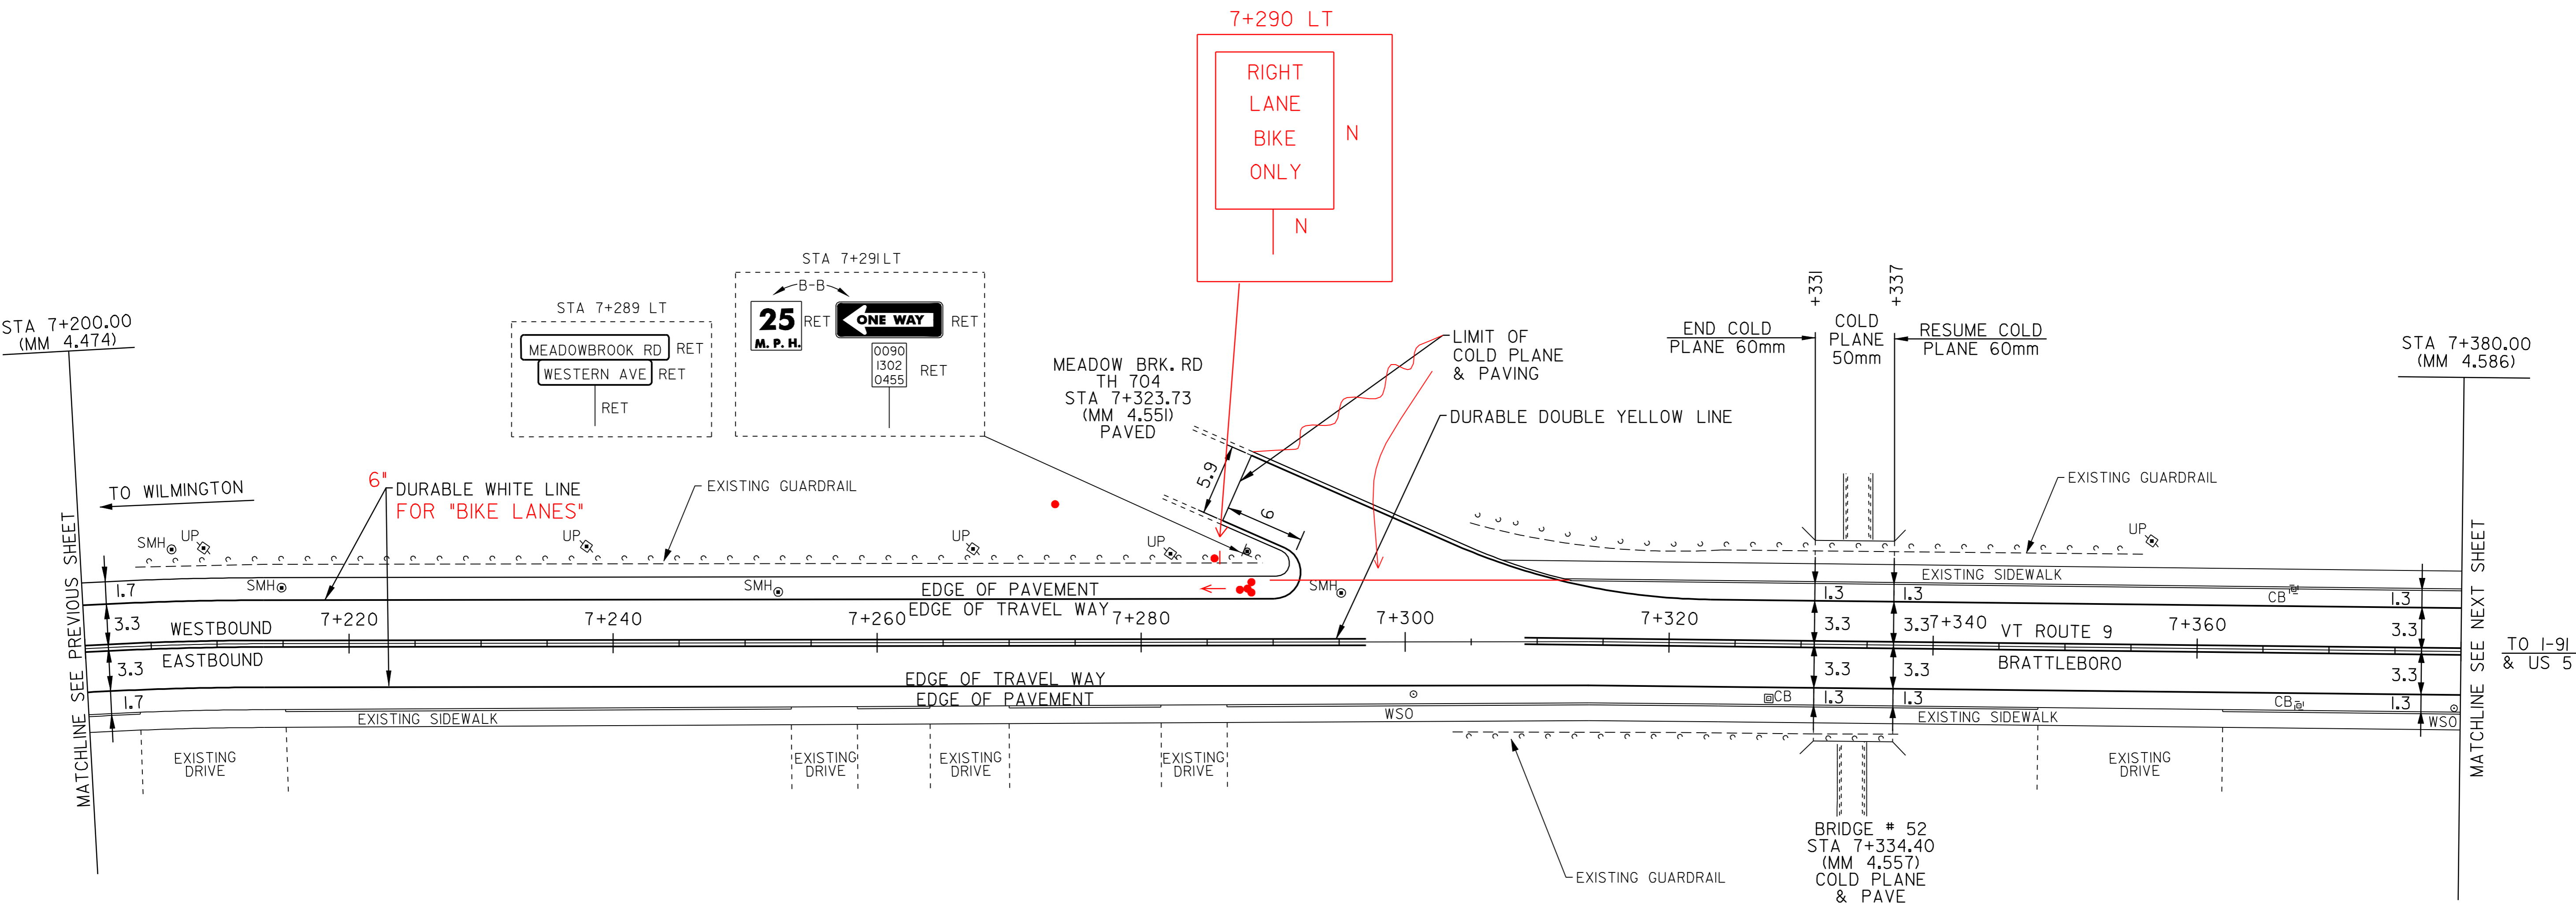

NOT TO SCALE

LEGEND

R	=	REMOVE EXISTING
S	=	SALVAGE
R&S	=	REMOVE AND SALVAGE
N	=	NEW
RET	=	RETAIN
B-B	=	BACK TO BACK

NOTE: ALL DIMENSIONS IN METERS EXCEPT AS INDICATED

PAVING PROJECT LAYOUT #3	PROJECT NAME: BRATTLEBORO	FILE NAME: ZPAVE\QID026\PD026.dgn	PLOT DATE: \$DATE\$
	PROJECT NUMBER: SI-STP_2303(1)S	PROJECT LEADER: WRH	DRAWN BY: JAC
	DESIGNED BY:	CHECKED BY: NLL	SHEET 10 OF 55
	CLD REF. NO.: pd026103.1		