


6" TO 4" DURABLE WHITE LINE CHANGES X WALK (BEGIN/END BIKE LANES)

DURABLE LETTER OR SYMBOL

- 7+419 LT ARROW
- 7+421 LT BIKER
- 7+517 RT ARROW
- 7+517 RT ONLY
- 7+520 RT ARROW
- 7+520 RT ONLY

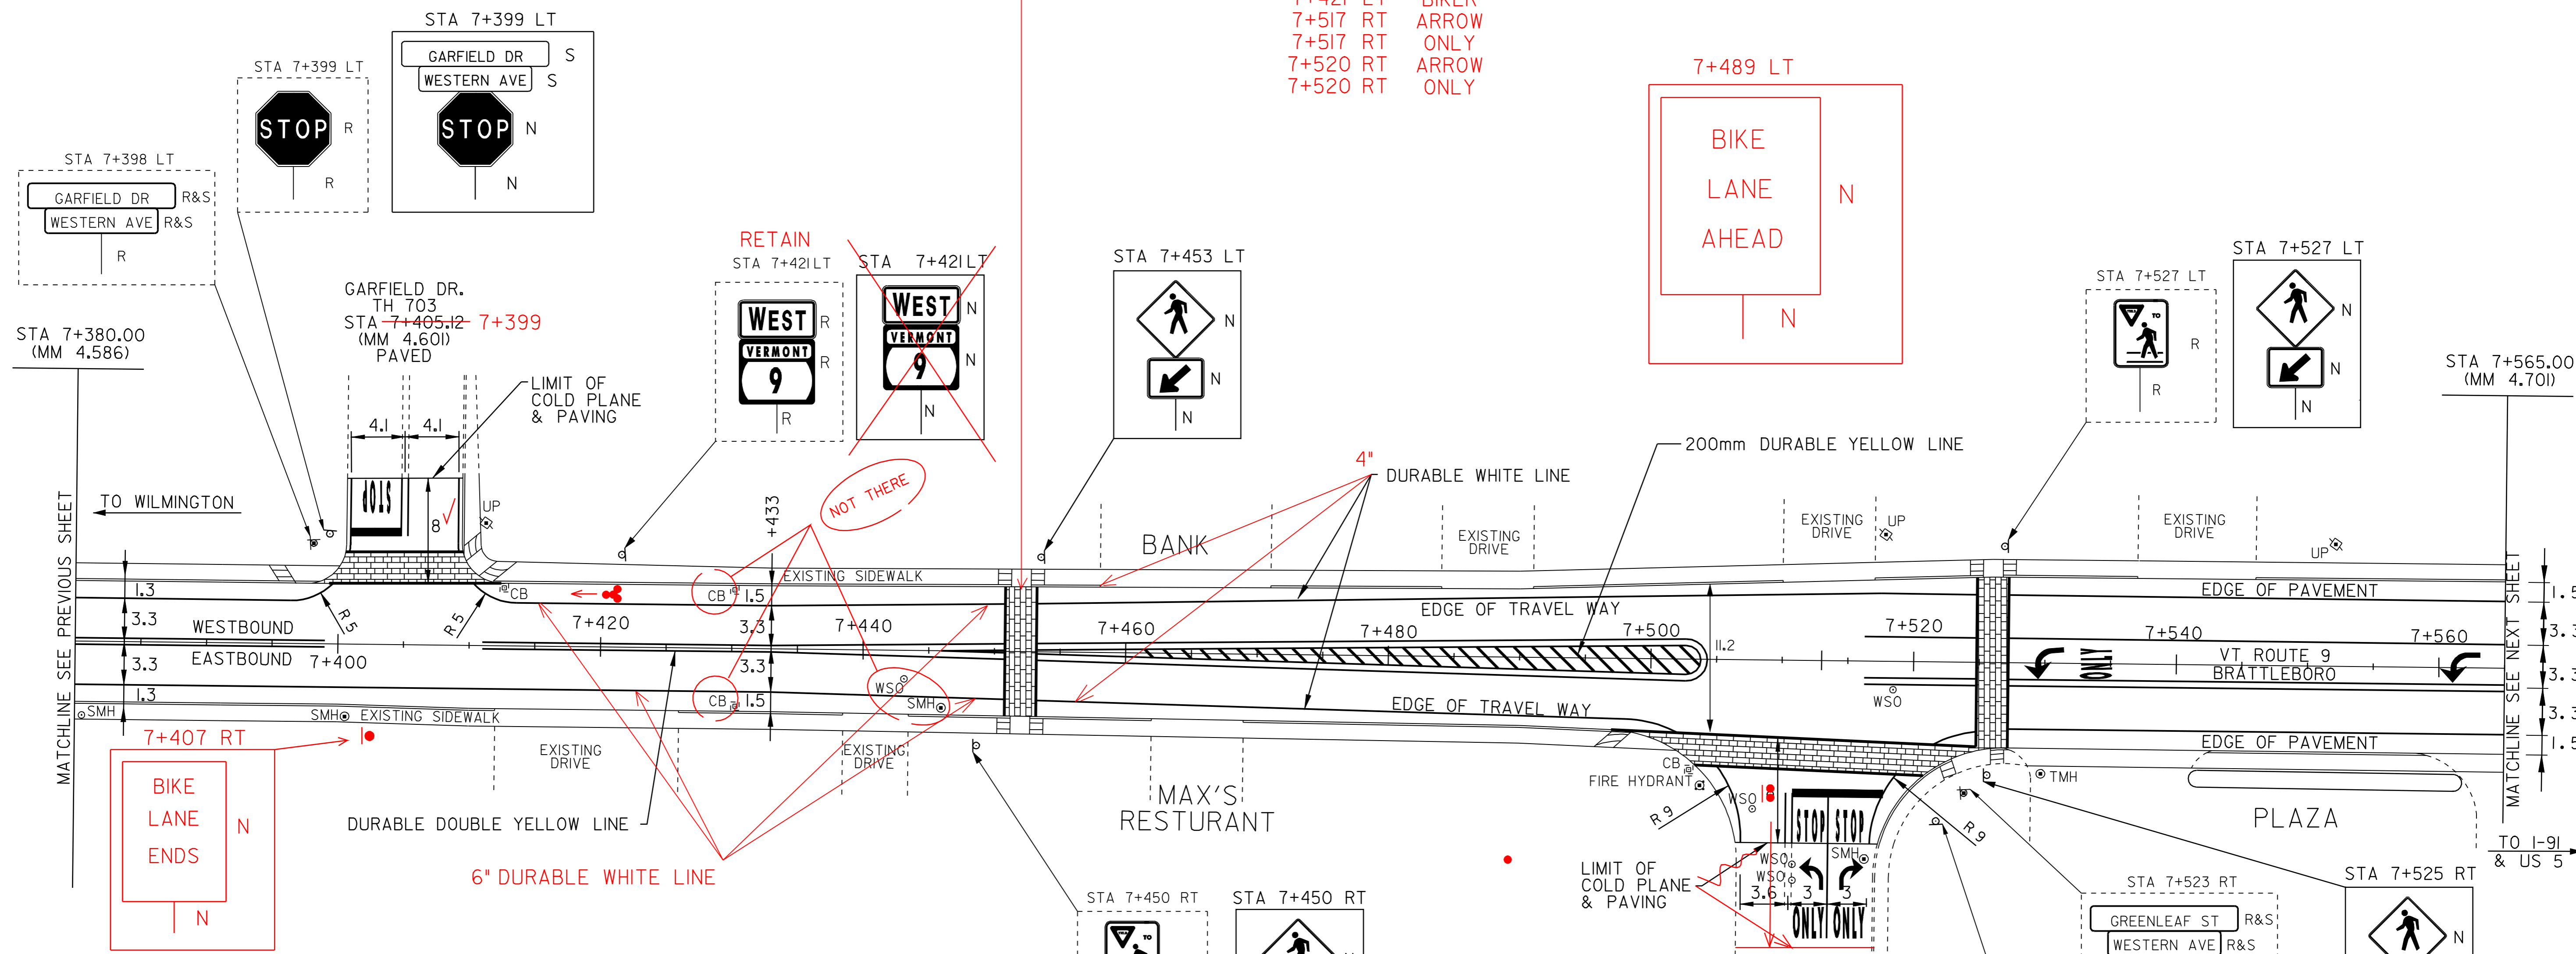

DURABLE 100mm WHITE LINE (TYPE-TAPE)
 STA 7+515 SOLID RT (TH SA. 6)
 STA 7+516 TO 7+565 SOLID LT (LANE LINE)

TEMPORARY AND DURABLE 100mm WHITE LINE
 STA 7+380 TO 7+400 SOLID LT
 STA 7+380 TO 7+500 SOLID RT
 STA 7+400 TO 7+403 SOLID LT (TH 703)
 STA 7+412 TO 7+415 SOLID LT (TH 703)
 STA 7+415 TO 7+565 SOLID LT
 STA 7+503 TO 7+506 RT (TH SA. 6)
 STA 7+516 TO 7+519 RT (TH SA. 6)
 STA 7+523 TO 7+565 SOLID RT

TEMPORARY 100mm WHITE LINE
 STA 7+515 SOLID RT (TH SA. 6)
 STA 7+516 TO 7+565 SOLID LT (LANE LINE)

TEMPORARY AND DURABLE 100mm YELLOW LINE
 STA 7+380 TO 7+399 SOLID LT & RT
 STA 7+405 DOUBLE SOLID LT (TH 703)
 STA 7+411 TO 7+504 SOLID LT & RT
 STA 7+446 TO 7+504 SOLID LT & RT (ISLAND)
 STA 7+510 DOUBLE SOLID RT (TH SA. 6)
 STA 7+516 TO 7+565 DOUBLE SOLID RT

TEMPORARY 600mm STOP BAR
 STA 7+404 LT (TH 703)
 STA 7+513 RT (TH SA. 6)

DURABLE 600mm STOP BAR (TYPE-TAPE)
 STA 7+404 LT (TH 703)
 STA 7+513 RT (TH SA. 6)

DURABLE LETTER OR SYMBOL (TYPE-TAPE)
 STA 7+405 LT - "STOP" (TH 703)
 STA 7+513 RT - "STOP" (SA. 6)
 STA 7+513 RT - LEFT TURN ARROW (SA 6)
 STA 7+513 RT - "ONLY"
 STA 7+516 RT - "STOP" (SA. 6)
 STA 7+516 RT - RIGHT TURN ARROW (SA 6)
 STA 7+516 RT - "ONLY"
 STA 7+529 LT - LEFT TURN ARROW
 STA 7+533 LT - "ONLY"
 STA 7+562 LT - LEFT TURN ARROW

TEMPORARY LETTERS OR SYMBOLS
 STA 7+405 LT - "STOP" (TH 703)
 STA 7+513 RT - "STOP" (SA. 6)
 STA 7+513 RT - LEFT TURN ARROW (SA 6)
 STA 7+516 RT - "STOP" (SA. 6)
 STA 7+516 RT - RIGHT TURN ARROW (SA 6)
 STA 7+529 LT - LEFT TURN ARROW
 STA 7+562 LT - LEFT TURN ARROW

DURABLE CROSSWALK MARKINGS W/DIAGONAL LINES (MOD)
 STA 7+400 TO 7+413 LT
 STA 7+452 LT TO RT
 STA 7+500 TO 7+525 RT
 STA 7+526 LT TO RT

TEMPORARY CROSSWALK MARKINGS W/DIAGONAL LINES
 STA 7+400 TO 7+413 LT
 STA 7+452 LT TO RT
 STA 7+500 TO 7+525 RT
 STA 7+526 LT TO RT

DURABLE 200mm YELLOW LINE
 STA 7+462 TO 7+504 SOLID LT & RT (DIAG YELLOW LINES)

ADJUST ELEVATION OF VALVE BOX
 STA 7+443 RT
 STA 7+505 RT
 STA 7+518 RT

CHANGING ELEV. OF DI, CB, OR MH
 STA 7+413 LT (CB)
 STA 7+430 LT (CB)
 STA 7+430 RT (CB)

CHANGING ELEVATION OF SEWER MANHOLE
 STA 7+446 RT

REMOVING SIGNS
 AS SHOWN - 10 8

ERECTING SALVAGED SIGNS
 AS SHOWN - 4

LEGEND

R	=	REMOVE EXISTING
S	=	SALVAGE
R&S	=	REMOVE AND SALVAGE
N	=	NEW
RET	=	RETAIN
B-B	=	BACK TO BACK

NOTE: ALL DIMENSIONS IN METERS EXCEPT AS INDICATED

NOT TO SCALE

PAVING PROJECT LAYOUT #4	PROJECT NAME: BRATTLEBORO
	PROJECT NUMBER: SI-STP_2303(1)S
	FILE NAME: ZPAVE_QID026/PD026.dgn
	CLD REF. NO.: pd026i04.1
PLLOT DATE: \$DATE\$	
DRAWN BY: JAC	
CHECKED BY: NULL	
SHEET 11 OF 55	