

~~DURABLE 100mm WHITE LINE (TYPE-TAPE)~~  
 STA 7+565 TO 7+567 SOLID LT (LANE LINE)  
 STA 7+567 TO 7+595 DOTTED LT (LANE LINE)

TEMPORARY AND DURABLE 100mm WHITE LINE  
 STA 7+565 TO 7+745 SOLID LT  
 STA 7+565 TO 7+745 SOLID RT  
 STA 7+678 TO 7+685 SOLID LT (NO PARKING)  
 STA 7+683 TO 7+685 SOLID RT (NO PARKING)  
 STA 7+687 TO 7+694 SOLID LT (NO PARKING)  
 STA 7+687 TO 7+694 SOLID RT (NO PARKING)

TEMPORARY AND DURABLE 100mm YELLOW LINE  
 STA 7+565 TO 7+624 DOUBLE SOLID RT  
 STA 7+572 TO 7+619 DOUBLE SOLID LT & RT ( ISLAND)  
 STA 7+624 TO 7+745 SOLID LT & RT

DURABLE 200mm YELLOW LINE  
 STA 7+577 TO 7+613 SOLID LT & RT

TEMPORARY CROSSWALK MARKINGS W/DIAGONAL LINES  
 STA 7+686 LT TO RT

CHANGING ELEV. OF DI, CB, OR MH  
 STA 7+693 LT (CB)

REHABILITATION OF DI, CB, OR MH, CLASS I  
 STA 7+710 RT (CB)

CHANGING ELEVATION OF SEWER MANHOLE  
 STA 7+575 RT  
 STA 7+639 RT


ADJUST ELEVATION OF VALVE BOX  
 STA 7+584 LT  
 STA 7+652 RT

REMOVING SIGNS  
 AS SHOWN - ~~2~~

~~DURABLE CROSSWALK MARKINGS W/DIAGONAL LINES (MOD)~~  
 STA 7+686 LT TO RT

~~DURABLE LETTER OR SYMBOL (TYPE-TAPE)~~  
 STA 7+566 LT -" ONLY"

7+715 RT BIKER  
 7+717 RT ARROW  
 7+745 LT ARROW  
 7+747 LT BIKER

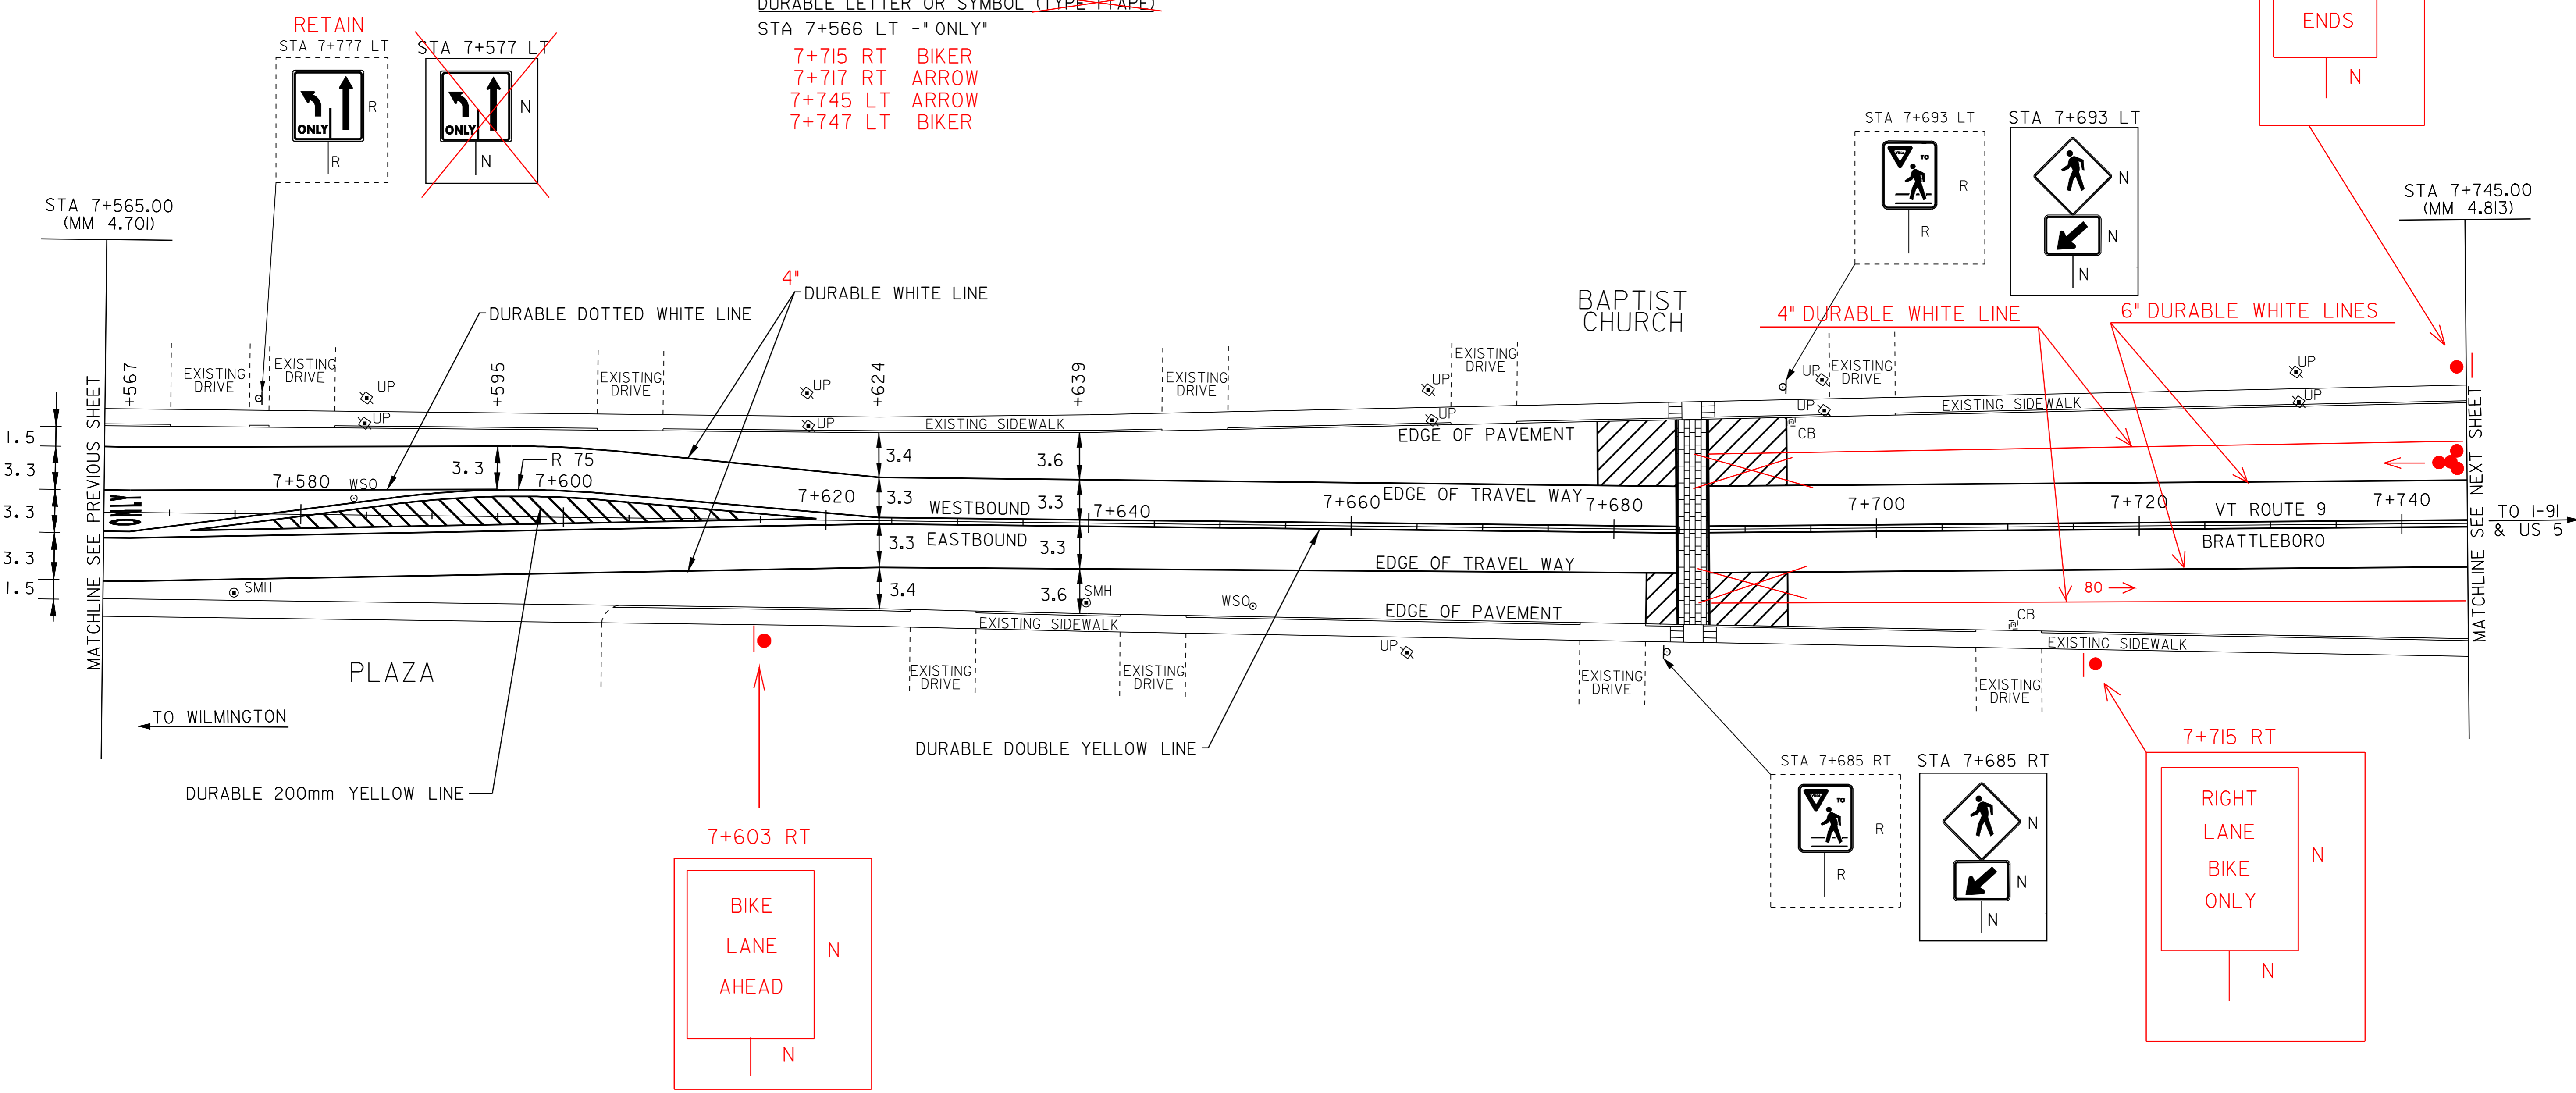

NOTE: ALL DIMENSIONS IN METERS EXCEPT AS INDICATED

**LEGEND**

R	=	REMOVE EXISTING
S	=	SALVAGE
R&S	=	REMOVE AND SALVAGE
N	=	NEW
RET	=	RETAIN
B-B	=	BACK TO BACK

<b>PAVING PROJECT LAYOUT #5</b>	PROJECT NAME: BRATTLEBORO	FILE NAME: ZPAVE\QID026\PD026.dgn	PLOT DATE: \$DATE\$
	PROJECT NUMBER: ST-SIP_2303(I)S	PROJECT LEADER: WRH	DRAWN BY: JAC
	DESIGNED BY: -	CHECKED BY: NLL	SHEET 12 OF 55
	CLD REF. NO.: pd026105.1		

NOT TO SCALE