


DURABLE LETTERS OR SYMBOLS

- 7+958 LT ARROW
- 7+960 LT BIKER
- 7+960 RT BIKER
- 7+962 RT ARROW

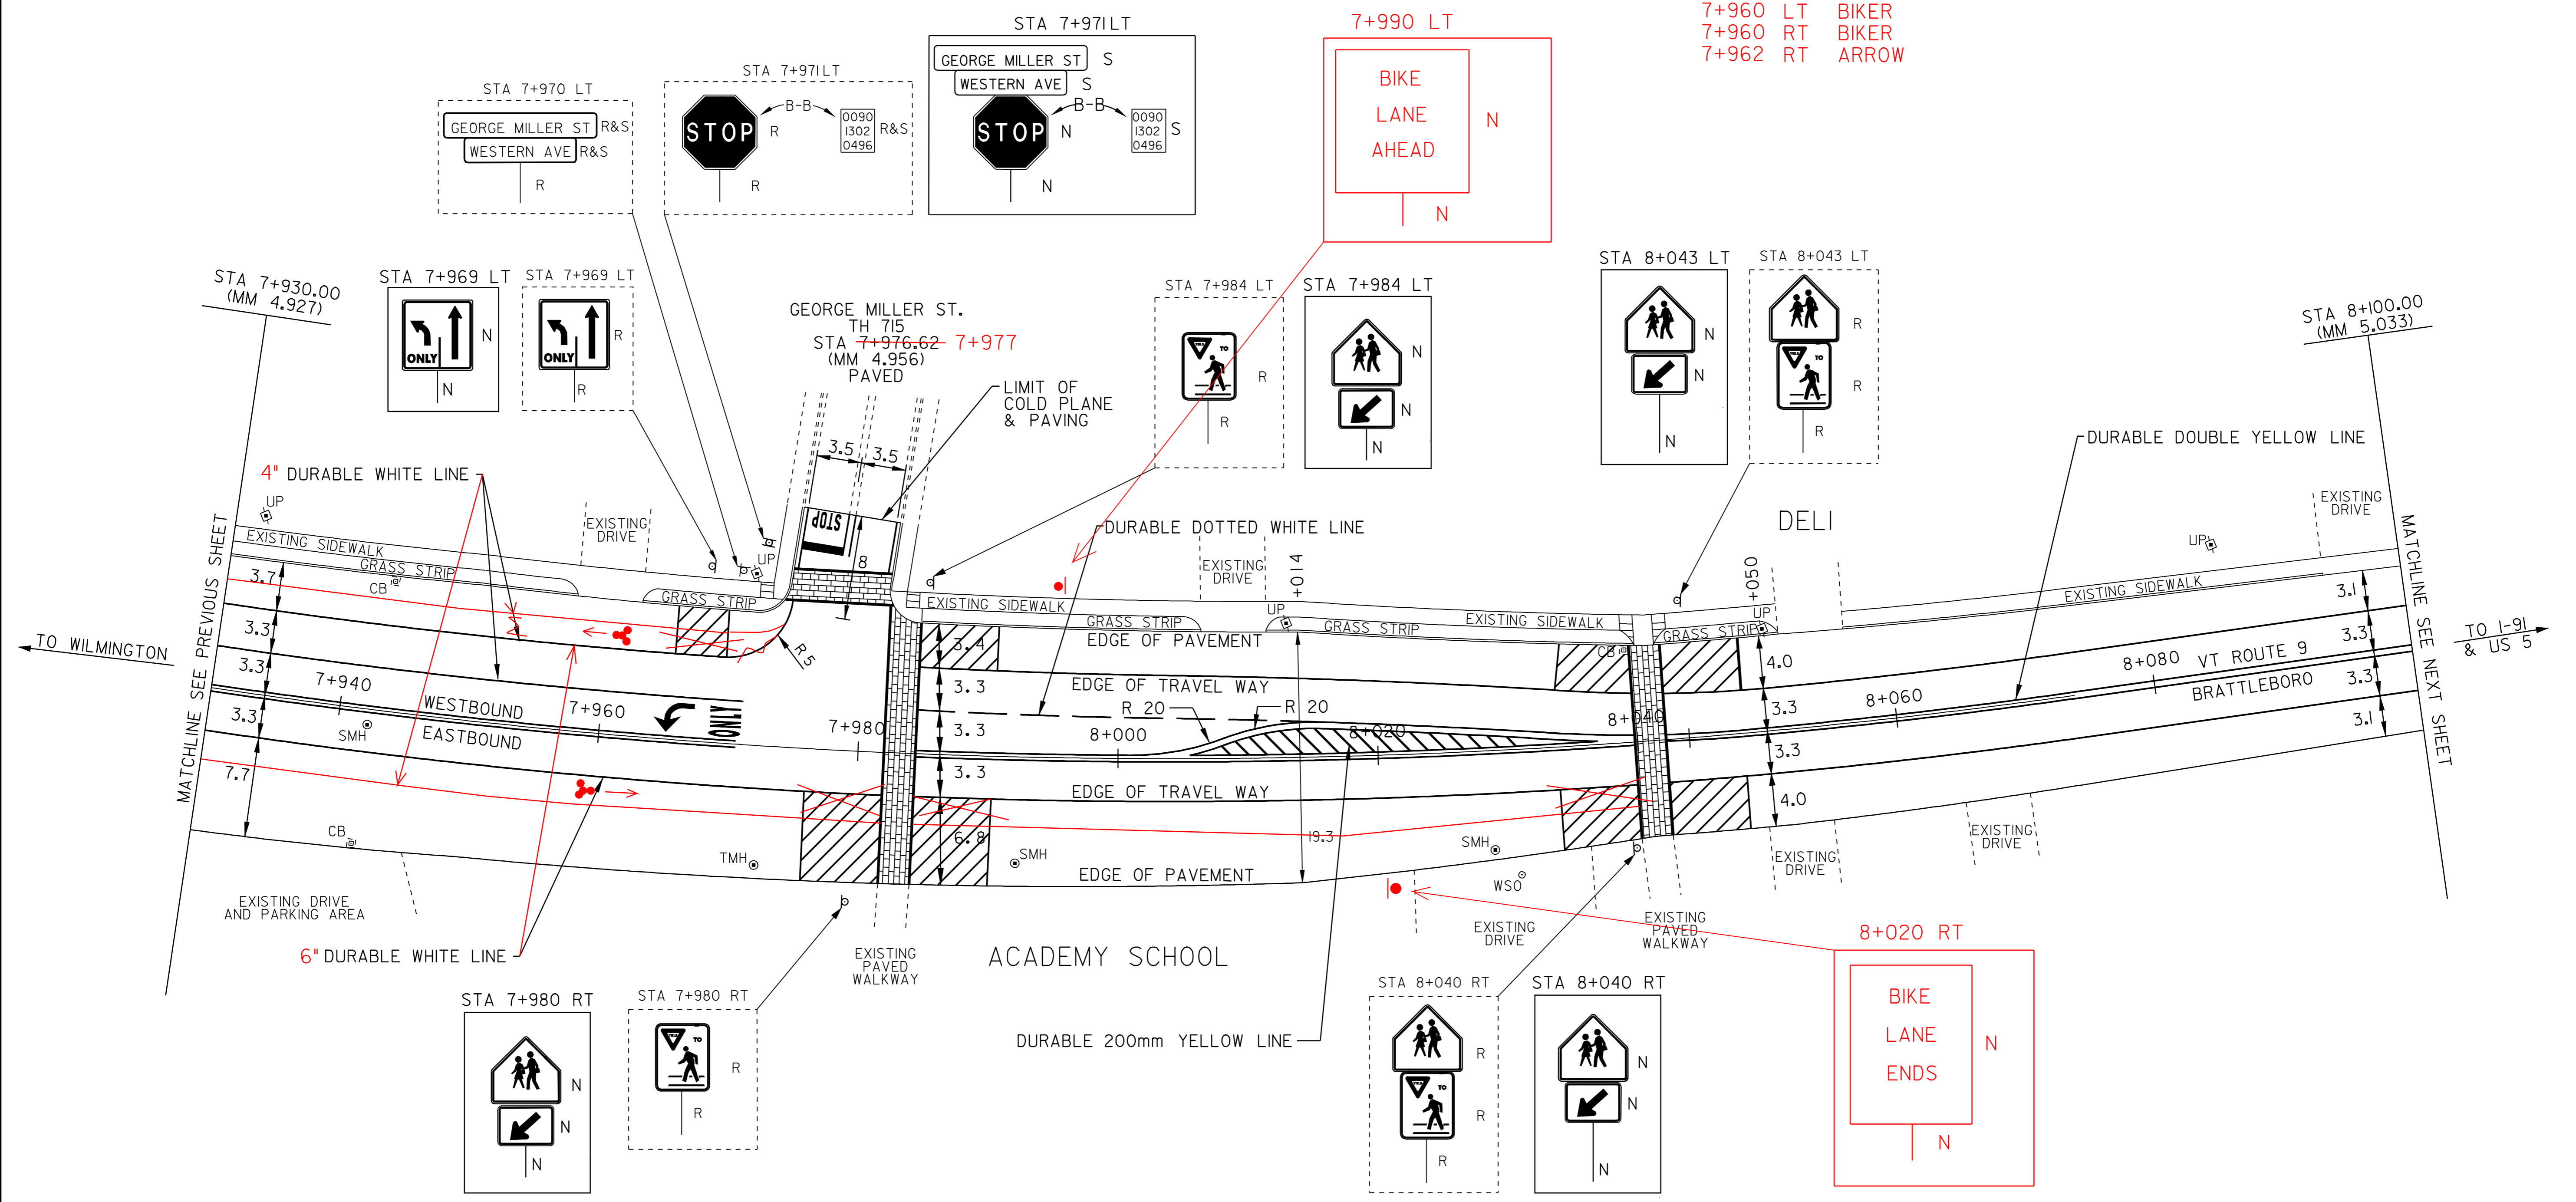

- TEMPORARY AND DURABLE 100mm WHITE LINE
- STA 7+930 TO 7+965 SOLID LT
 - STA 7+930 TO 8+100 SOLID RT
 - STA 7+965 TO 7+974 SOLID LT (NO PARKING)
 - STA 7+974 TO 7+975 SOLID LT (TH 715)
 - STA 7+975 TO 7+981 SOLID RT (NO PARKING)
 - STA 7+981 TO 7+982 SOLID LT (TH 715)
 - STA 7+984 TO 7+990 SOLID LT (NO PARKING)
 - STA 7+984 TO 7+990 SOLID RT (NO PARKING)
 - STA 7+984 TO 8+100 SOLID LT
 - STA 8+036 TO 8+040 SOLID LT (NO PARKING)
 - STA 8+036 TO 8+040 SOLID RT (NO PARKING)
 - STA 8+042 TO 8+048 SOLID LT (NO PARKING)
 - STA 8+042 TO 8+048 SOLID RT (NO PARKING)
- DURABLE 100mm WHITE LINE (TYPE-TAPE)
- STA 7+930 TO 7+971 SOLID LT (LANE LINE)
 - STA 7+984 TO 8+014 DOTTED LT (LANE LINE)
- TEMPORARY 600mm STOP BAR
- STA 7+972 LT (TH 715)
- DURABLE 600mm STOP BAR (TYPE-TAPE)
- STA 7+972 LT (TH 715)

- TEMPORARY AND DURABLE 100mm YELLOW LINE
- STA 7+930 TO 7+971 SOLID LT & RT
 - STA 7+976 DOUBLE SOLID LT (TH 715)
 - STA 8+001 TO 8+037 DOUBLE SOLID LT (ISLAND)
 - STA 7+984 TO 8+100 SOLID LT & RT
- DURABLE CROSSWALK MARKINGS W/DIAGONAL LINES (MOD)
- STA 7+972 TO 7+982 LT
 - STA 7+983 LT TO RT
 - STA 8+041 LT TO RT
- TEMPORARY CROSSWALK MARKINGS W/DIAGONAL LINES
- STA 7+972 TO 7+982 LT
 - STA 7+983 LT TO RT
 - STA 8+041 LT TO RT

- DURABLE 200mm YELLOW LINE
- STA 8+008 TO 8+031 SOLID LT
- DURABLE LETTER OR SYMBOL (TYPE-TAPE)
- STA 7+966 LT - LEFT TURN ARROW
 - STA 7+970 LT - "ONLY"
 - STA 7+973 LT - "STOP" (TH 715)
- TEMPORARY LETTERS OR SYMBOLS
- STA 7+966 LT - LEFT TURN ARROW
 - STA 7+973 LT - "STOP" (TH 715)

- CHANGING ELEV. OF DI, CB, OR MH
- STA 7+942 LT (CB)
 - STA 7+942 RT (CB)
 - STA 7+971 RT (TMH)
 - STA 8+040 LT (CB)
- CHANGING ELEVATION OF SEWER MANHOLE
- STA 7+942 RT
 - STA 7+992 RT
 - STA 8+029 RT

- REMOVING SIGNS
- AS SHOWN - 11 ✓
- ERECTING SALVAGED SIGNS
- AS SHOWN - 3

- LEGEND
- R = REMOVE EXISTING
 - S = SALVAGE
 - R&S = REMOVE AND SALVAGE
 - N = NEW
 - RET = RETAIN
 - B-B = BACK TO BACK

NOTE: ALL DIMENSIONS IN METERS EXCEPT AS INDICATED

NOT TO SCALE

PAVING PROJECT LAYOUT #7	PROJECT NAME: BRATTLEBORO	PLOT DATE: \$DATE\$
	PROJECT NUMBER: ST-STP 2303(I)S	DRAWN BY: JAC
	FILE NAME: /PAVE/OID026/PD026.dgn	DESIGNED BY: -
	CLD REF. NO.: pd026i07.1	CLD REF. NO.: -