

TEMPORARY AND DURABLE 100mm WHITE LINE
 STA 8+100 TO 8+285 SOLID LT
 STA 8+110 TO 8+114 SOLID LT (NO PARKING)
 STA 8+100 TO 8+285 SOLID RT
 STA 8+262 TO 8+266 SOLID RT (NO PARKING)


TEMPORARY AND DURABLE 100mm YELLOW LINE
 STA 8+100 TO 8+285 SOLID LT & RT

DURABLE LETTER OR SYMBOL (TYPE-TAPE)
 STA 8+201 LT - "SCHOOL"
 TEMPORARY LETTERS OR SYMBOLS
 STA 8+201 LT - "SCHOOL"

ADJUST ELEVATION OF VALVE BOX
 STA 8+110 LT
 STA 8+202 LT
 STA 8+265 RT

CHANGING ELEV. OF DI, CB, OR MH
 STA 8+121 LT (CB)
 STA 8+121 RT (CB)
 STA 8+159 LT (CB)
 STA 8+159 RT (CB)
 STA 8+210 RT (CB)
 STA 8+212 LT (CB)
 STA 8+255 LT (CB)
 STA 8+264 RT (CB)

REMOVING SIGNS
 AS SHOWN - 1 ✓

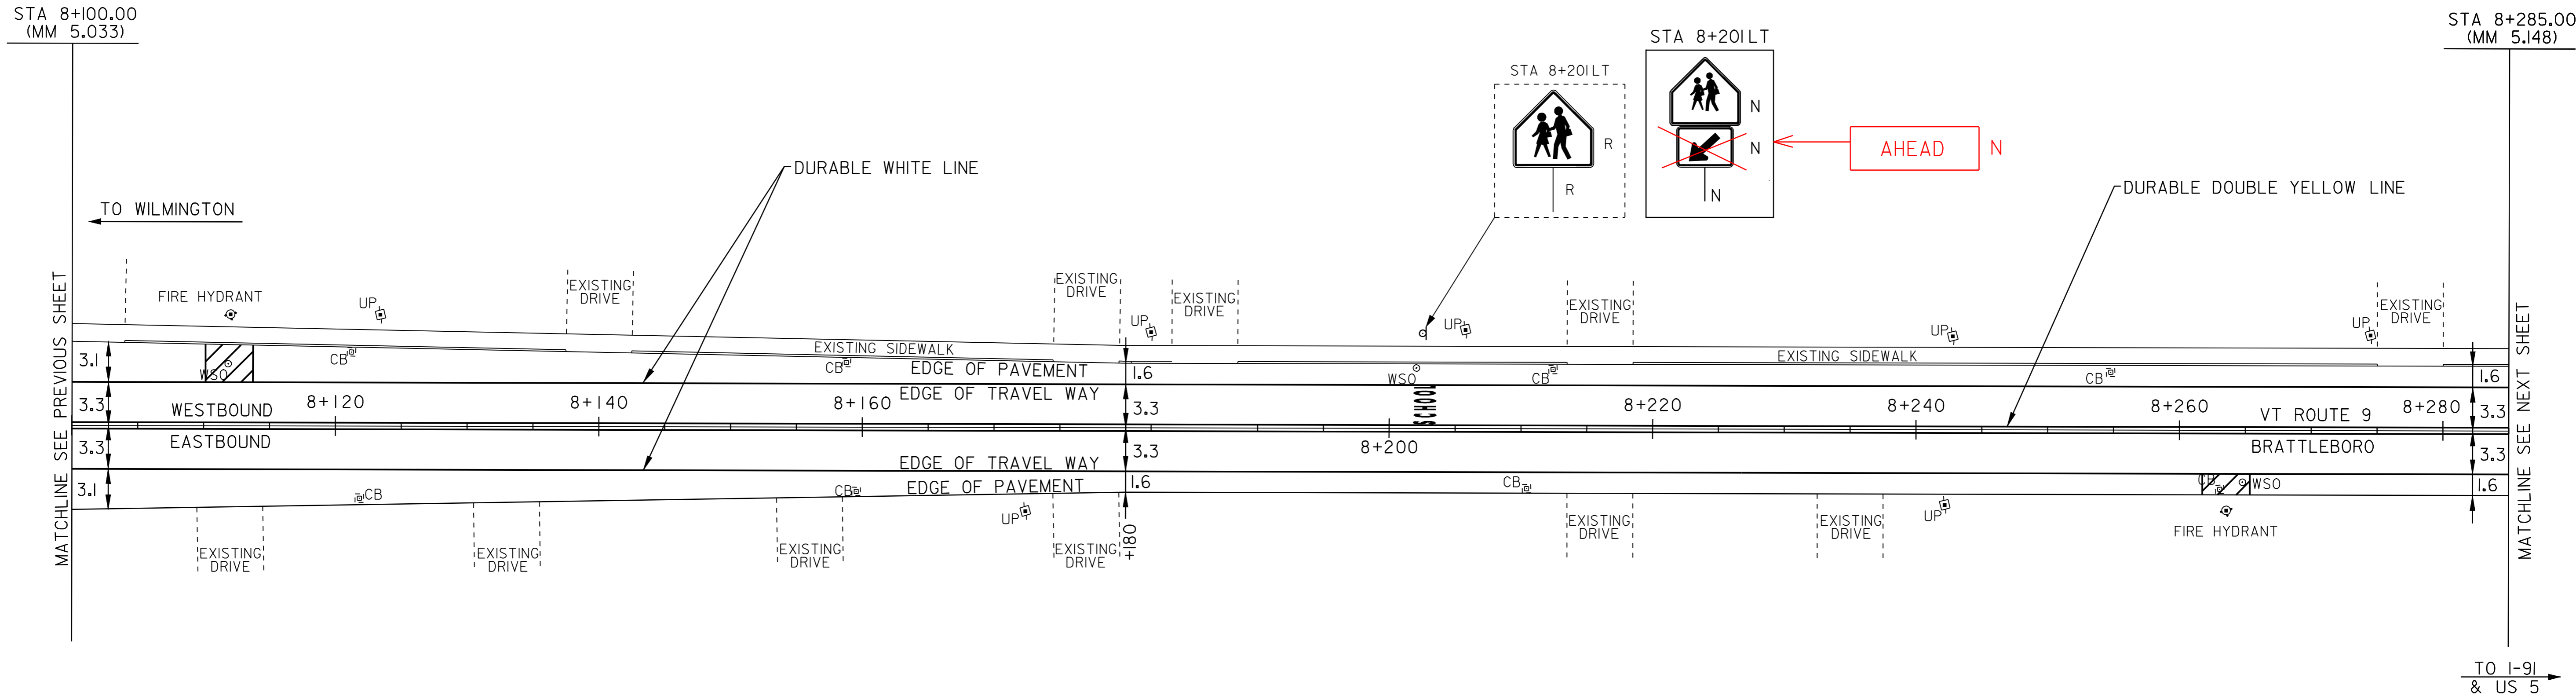

NOT TO SCALE

LEGEND

- R = REMOVE EXISTING
- S = SALVAGE
- R&S = REMOVE AND SALVAGE
- N = NEW
- RET = RETAIN
- B-B = BACK TO BACK

NOTE: ALL DIMENSIONS IN METERS EXCEPT AS INDICATED

**PAVING
PROJECT
LAYOUT #8**

PROJECT NAME:	BRATTLEBORO
PROJECT NUMBER:	ST-STP_2303(1)S
FILE NAME:	PAVE_QID026/PD026.dgn
PROJECT LEADER:	WRH
DESIGNED BY:	
CLD REF. NO.:	pd026108.1
PLOT DATE:	\$DATE\$
DRAWN BY:	JAC
CHECKED BY:	NULL
SHEET	15 OF 55