

TEMPORARY AND DURABLE 100mm WHITE LINE
 STA 8+285 TO 8+365 SOLID LT
 STA 8+285 TO 8+460 SOLID RT
 STA 8+372 TO 8+460 SOLID LT
 STA 8+433 TO 8+437 SOLID LT (NO PARKING)

DURABLE LETTER OR SYMBOL (TYPE + TAPE)
 STA 8+365 LT - "STOP" (TH 716)

TEMPORARY LETTERS OR SYMBOLS
 STA 8+365 LT - "STOP" (TH 716)

CHANGING ELEV. OF DI, CB, OR MH
 STA 8+375 LT (CB)
 STA 8+411 LT (CB)
 STA 8+411 RT (CB)

TEMPORARY AND DURABLE 100mm YELLOW LINE
 STA 8+285 TO 8+362 SOLID LT & RT
 STA 8+366 DOUBLE SOLID LT (TH 716)
 STA 8+374 TO 8+460 SOLID LT & RT

TEMPORARY CROSSWALK MARKINGS W/DIAGONAL LINES
 STA 8+365 TO 8+371 LT

DURABLE CROSSWALK MARKINGS W/DIAGONAL LINES (MOD)
 STA 8+365 TO 8+371 LT

CHANGING ELEVATION OF SEWER MANHOLE
 STA 8+424 RT

SHOULDER BERM REMOVAL
 STA 8+302 TO 8+332 LT
 STA 8+309 TO 8+335 RT
 STA 8+351 TO 8+366 LT
 STA 8+354 TO 8+368 RT


DURABLE 600mm STOP BAR (TYPE + TAPE)
 STA 8+366 LT (TH 716)

TEMPORARY 600mm STOP BAR
 STA 8+366 LT (TH 716)


ADJUST ELEVATION OF VALVE BOX
 STA 8+299 LT
 STA 8+299 LT
 STA 8+302 RT
 STA 8+366 LT
 STA 8+366 LT
 STA 8+368 LT (TH 716)
 STA 8+368 LT (TH 716)
 STA 8+376 RT
 STA 8+435 LT

REMOVING SIGNS
 AS SHOWN - 4 ✓

ERECTING SALVAGED SIGNS
 AS SHOWN - 3

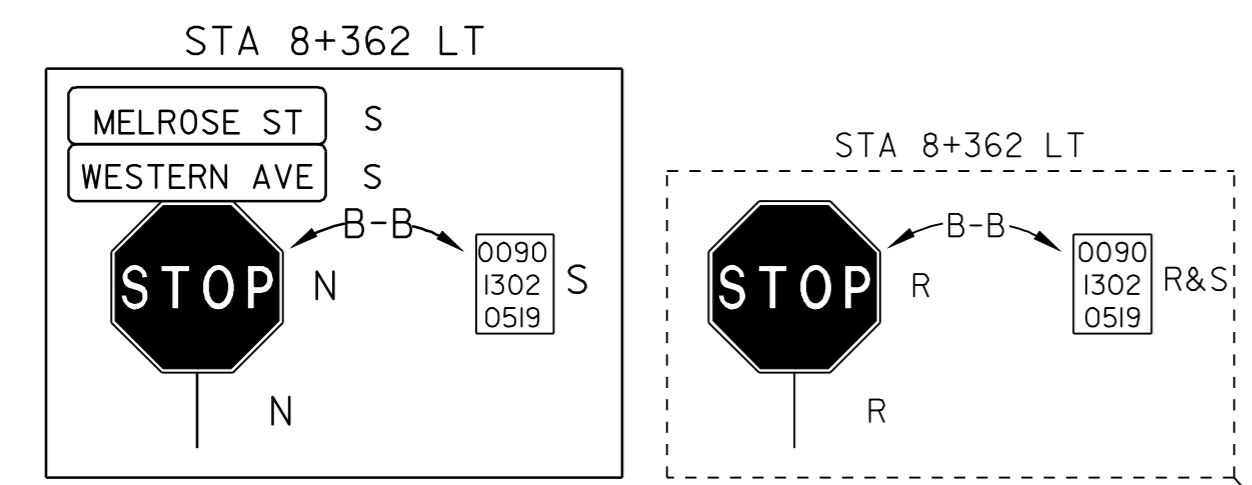

MELROSE ST.
 TH 716
 STA ~~8+368.00~~ 8+352
 (MM 5.200)
 PAVED

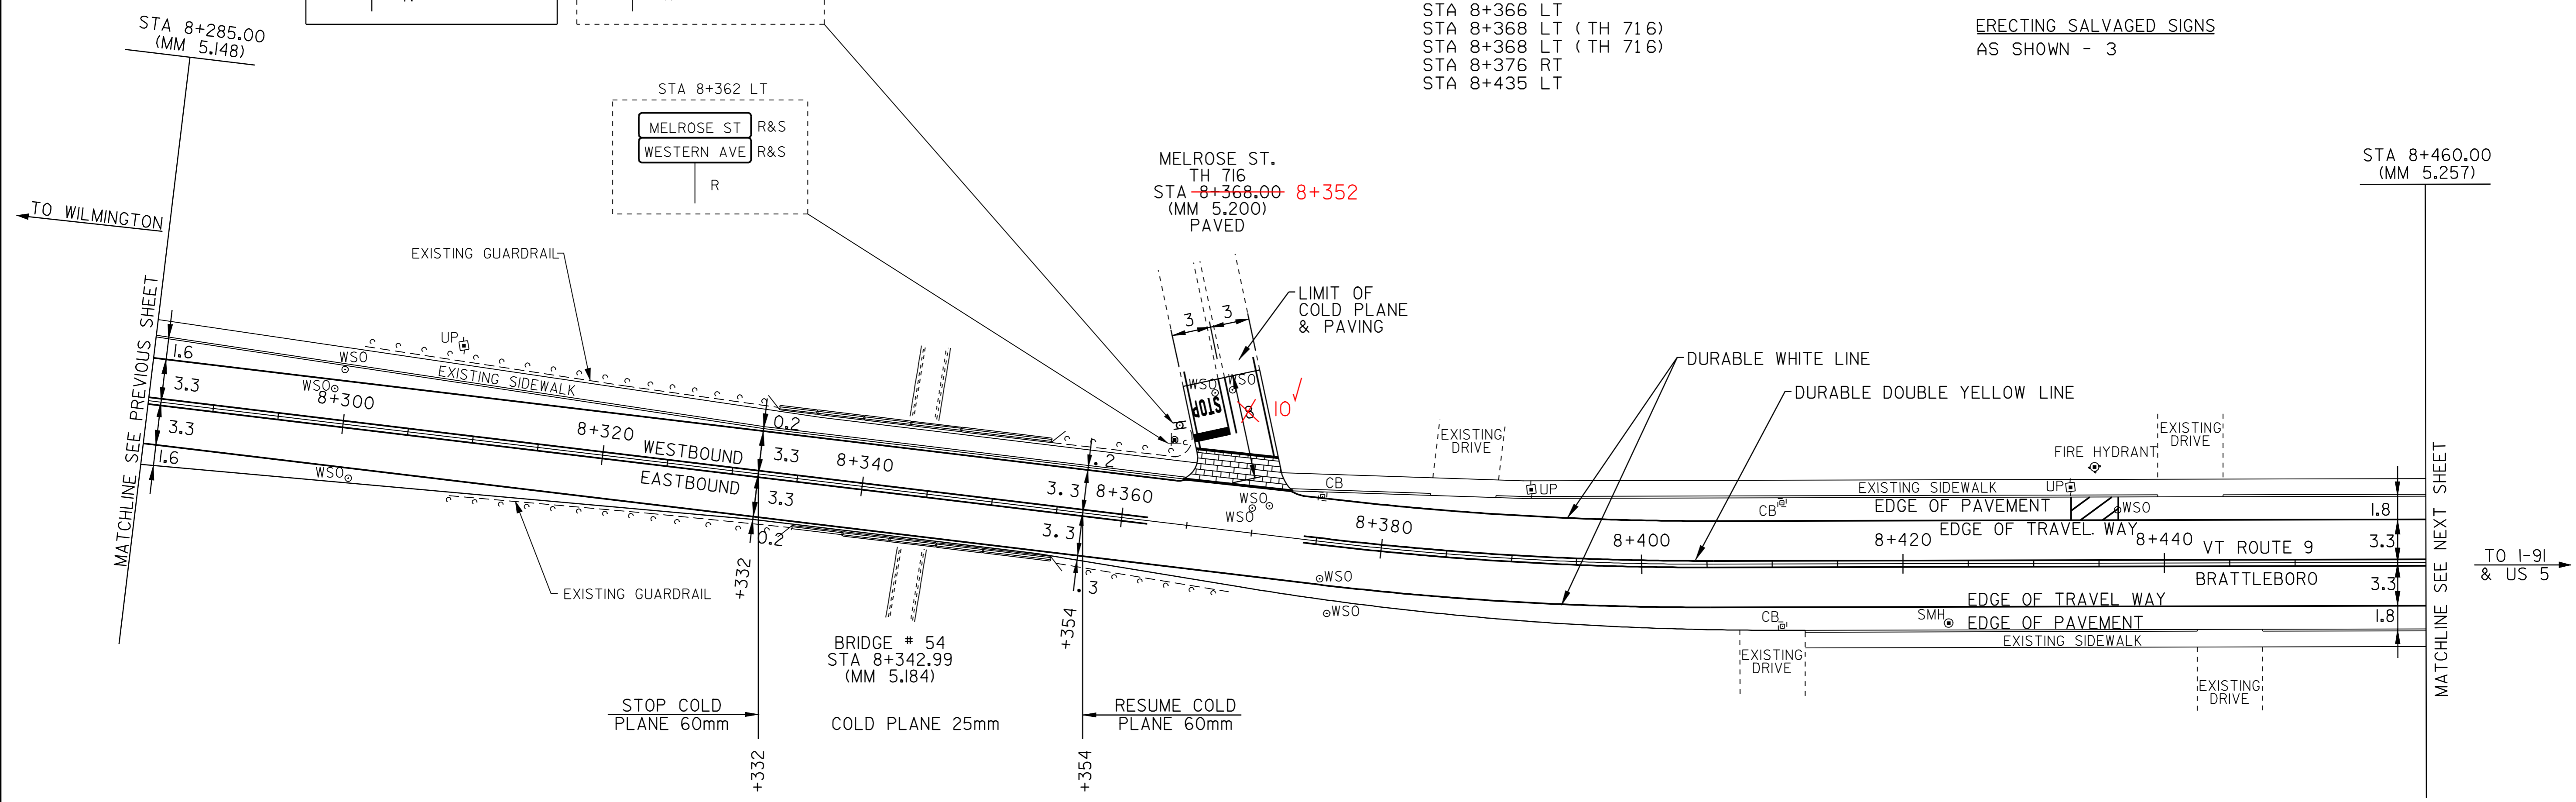

- LEGEND
- R = REMOVE EXISTING
 - S = SALVAGE
 - R&S = REMOVE AND SALVAGE
 - N = NEW
 - RET = RETAIN
 - B-B = BACK TO BACK

NOTE: ALL DIMENSIONS IN METERS EXCEPT AS INDICATED

NOT TO SCALE

PAVING PROJECT LAYOUT #9	PROJECT NAME: BRATTLEBORO	PLOT DATE: \$DATE\$
	PROJECT NUMBER: ST-STP_2303(1)S	DRAWN BY: JAC
	FILE NAME: /PAVE/QID026/PD026.dgn	CHECKED BY: NLL
	DESIGNED BY: WRH	SHEET 16 OF 55