

TEMPORARY AND DURABLE 100mm WHITE LINE  
 STA 8+640 TO 8+820 SOLID LT  
 STA 8+640 TO 8+738 SOLID RT  
 STA 8+738 TO 8+742 SOLID RT (TH 372)  
 STA 8+750 TO 8+754 SOLID RT (TH 372)  
 STA 8+754 TO 8+820 SOLID RT

TEMPORARY AND DURABLE 100mm YELLOW LINE  
 STA 8+640 TO 8+742 SOLID LT & RT  
 STA 8+747 DOUBLE SOLID RT (TH 372)  
 STA 8+754 TO 8+820 SOLID LT & RT

DURABLE 600mm STOP BAR (TYPE I TAPE)  
 STA 8+750 RT (TH 372)

TEMPORARY 600mm STOP BAR  
 STA 8+750 RT (TH 372)

DURABLE LETTER OR SYMBOL (TYPE I TAPE)  
 STA 8+748 RT - "STOP" (TH 372)  
TEMPORARY LETTERS OR SYMBOLS  
 STA 8+748 RT - "STOP" (TH 372)

DURABLE CROSSWALK MARKINGS W/DIAGONAL LINES (MOD)  
 STA 8+761 TO 8+762 SOLID LT TO RT  
TEMPORARY CROSSWALK MARKINGS W/DIAGONAL LINES  
 STA 8+761 TO 8+762 SOLID LT TO RT

STEEL BEAM GUARDRAIL  
 STA 8+653 TO 8+714 RT

ANCHOR FOR STEEL BEAM GUARDRAIL  
 STA 8+653 RT  
 STA 8+714 RT

REMOVAL & DISP. OF GUARDRAIL  
 STA 8+654 TO 8+714 RT

CHANGING ELEV. OF DI, CB, OR MH  
 STA 8+651 LT (CB)  
 STA 8+655 RT (CB)  
 STA 8+695 LT (CB)  
 STA 8+698 RT (CB)  
 STA 8+723 RT (CB)  
 STA 8+747 RT (DMH)  
 STA 8+779 RT (CB)


REHABILITATION OF DI, CB, OR MH, CLASS I  
 STA 8+772 LT (CB)

CHANGING ELEVATION OF SEWER MANHOLE  
 STA 8+680 RT

ADJUST ELEVATION OF VALVE BOX  
 STA 8+717 LT  
 STA 8+758 RT

REMOVING SIGNS ✓  
 AS SHOWN - 6

ERECTING SALVAGED SIGNS  
 AS SHOWN - 3

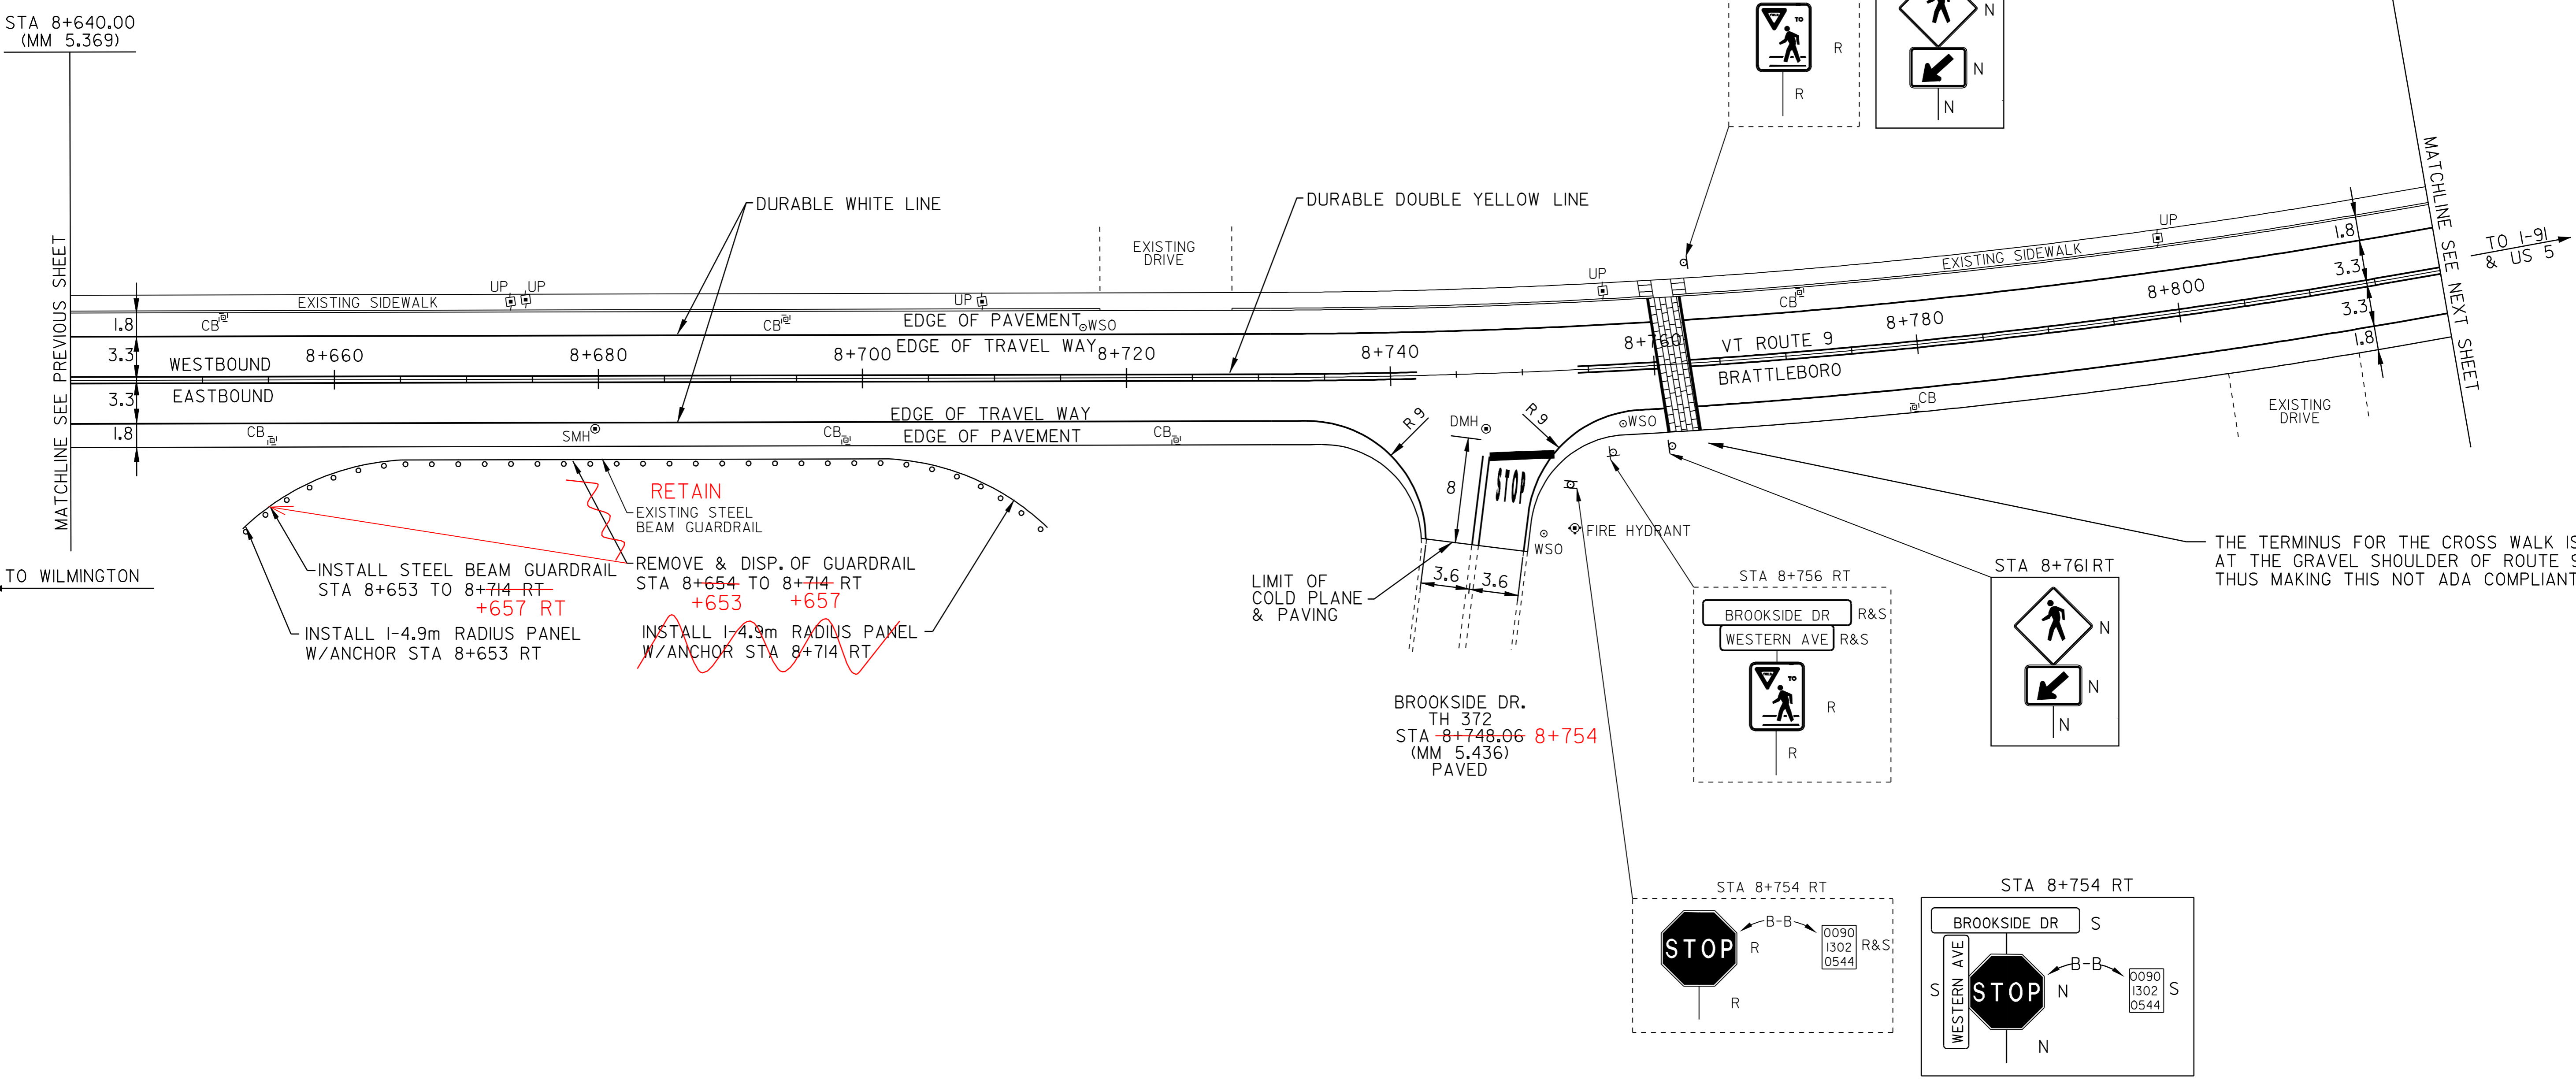

MATCHLINE SEE PREVIOUS SHEET

MATCHLINE SEE NEXT SHEET

THE TERMINUS FOR THE CROSS WALK IS AT THE GRAVEL SHOULDER OF ROUTE 9 THUS MAKING THIS NOT ADA COMPLIANT.

NOT TO SCALE

- LEGEND**
- R = REMOVE EXISTING
  - S = SALVAGE
  - R&S = REMOVE AND SALVAGE
  - N = NEW
  - RET = RETAIN
  - B-B = BACK TO BACK

NOTE: ALL DIMENSIONS IN METERS EXCEPT AS INDICATED

<b>PAVING PROJECT LAYOUT #11</b>	PROJECT NAME: BRATTLEBORO	FILE NAME: \PAVE\QID026\PD026.dgn	PLOT DATE: \$DATE\$
	PROJECT NUMBER: ST-STP_2303(I)S	PROJECT LEADER: WRH	DRAWN BY: JAC
	DESIGNED BY: -	CHECKED BY: NLL	
	CLD REF. NO.: p4026III.I		SHEET 18 OF 55