

TEMPORARY AND DURABLE 100mm WHITE LINE

STA 8+820 TO 9+000 SOLID LT
STA 8+820 TO 9+000 SOLID RT

TEMPORARY AND DURABLE 100mm YELLOW LINE

STA 8+820 TO 9+000 SOLID LT & RT

CHANGING ELEVATION OF SEWER MANHOLE


STA 8+870 RT
STA 8+985 RT

CHANGING ELEV. OF DI, CB, OR MH

STA 8+825 RT (CB)
STA 8+850 RT (CB)
STA 8+874 RT (CB)
STA 8+887 RT (DMH)
STA 8+890 LT (CB)
STA 8+894 RT (CB)
STA 8+923 LT (CB)

REHABILITATION OF DI, CB, OR MH, CLASS I

STA 8+821 LT (CB)

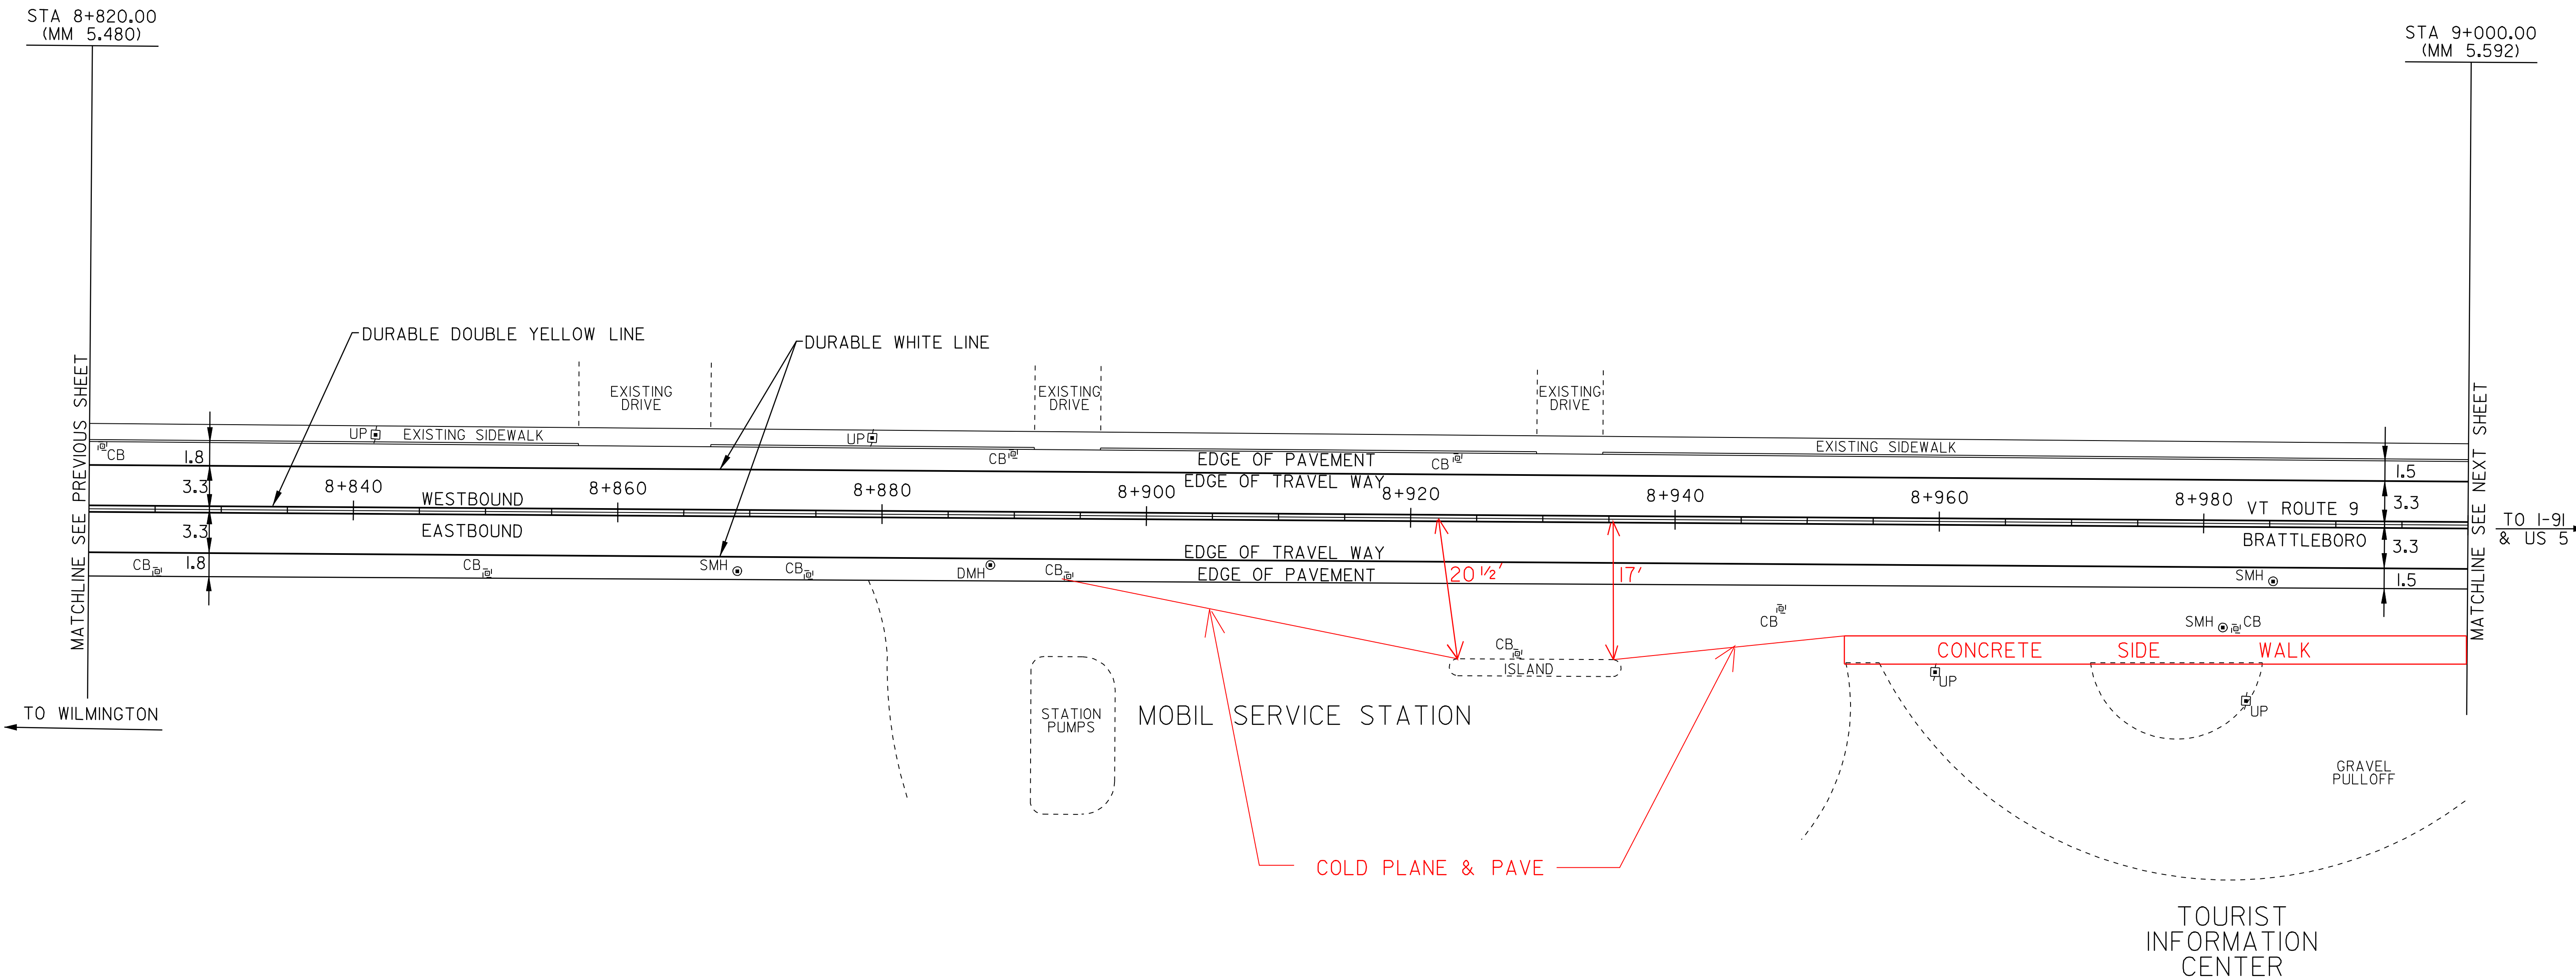

NOTE: ALL DIMENSIONS IN METERS EXCEPT AS INDICATED

LEGEND

- R = REMOVE EXISTING
- S = SALVAGE
- R&S = REMOVE AND SALVAGE
- N = NEW
- RET = RETAIN
- B-B = BACK TO BACK

PAVING PROJECT LAYOUT #12

PROJECT NAME:	BRATTLEBORO		
PROJECT NUMBER:	SI-STP_2303(I)S		
FILE NAME:	ZPAVE\01D026\PD026.dgn	PLOT DATE:	\$DATE\$
PROJECT LEADER:	WRH	DRAWN BY:	JAC
DESIGNED BY:		CHECKED BY:	NLL
CLD REF. NO.:	pd026112.1	SHEET	19 OF 55

NOT TO SCALE