

TEMPORARY AND DURABLE 100mm WHITE LINE
 STA 9+180 TO 9+245 SOLID LT
 STA 9+180 TO 9+292 SOLID RT
 STA 9+245 TO 9+247 SOLID LT (TH 304)
 STA 9+253 TO 9+254 SOLID LT (TH 304)
 STA 9+257 TO 9+365 SOLID LT
 STA 9+292 TO 9+298 SOLID RT (TH 378)
 STA 9+304 TO 9+305 SOLID RT (TH 378)
 STA 9+305 TO 9+345 SOLID RT
 STA 9+345 TO 9+346 SOLID RT (TH 378)
 STA 9+352 TO 9+360 SOLID RT (TH 378)
 STA 9+360 TO 9+365 SOLID RT

TEMPORARY AND DURABLE 100mm YELLOW LINE
 STA 9+180 TO 9+244 SOLID LT & RT
 STA 9+249 DOUBLE SOLID LT (TH 304)
 STA 9+257 TO 9+292 SOLID LT & RT
 STA 9+292 DOUBLE SOLID RT (TH 378)
 STA 9+304 TO 9+343 SOLID LT & RT
 STA 9+355 TO 9+365 SOLID LT & RT

DURABLE LETTER OR SYMBOL (TYPE + TAPE)
 STA 9+247 LT - "STOP" (TH 304)
 STA 9+292 RT - "STOP" (TH 378)

TEMPORARY LETTERS OR SYMBOLS
 STA 9+247 LT - "STOP" (TH 304)
 STA 9+292 RT - "STOP" (TH 378)

DURABLE 600 mm STOP BAR (TYPE + TAPE)
 STA 9+247 LT (TH 304)
 STA 9+300 RT (TH 378)

TEMPORARY 600 mm STOP BAR
 STA 9+247 LT (TH 304)
 STA 9+300 RT (TH 378)

DURABLE CROSSWALK MARKINGS W/DIAGONAL LINES (MOD)
 STA 9+245 TO 9+255 LT
 STA 9+256 LT TO RT
 STA 9+293 TO 9+305 RT

TEMPORARY CROSSWALK MARKINGS W/DIAGONAL LINES
 STA 9+245 TO 9+255 LT
 STA 9+256 LT TO RT
 STA 9+293 TO 9+305 RT

ADJUST ELEVATION OF VALVE BOX
 STA 9+280 RT
 STA 9+300 LT
 STA 9+301 LT
 STA 9+313 RT


CHANGING ELEV. OF DI, CB, OR MH
 STA 9+241 LT (CB)
 STA 9+253 LT (CB) - TH 304
 STA 9+318 LT (CB)

REHABILITATION OF DI, CB, OR MH, CLASS I
 STA 9+247 RT (CB)
 STA 9+247 LT (CB) - TH 304
 STA 9+262 LT (CB)
 STA 9+293 RT (CB)
 STA 9+295 LT (CB)

CHANGING ELEVATION OF SEWER MANHOLE
 STA 9+242 LT
 STA 9+269 LT
 STA 9+306 RT

REMOVING SIGNS
 AS SHOWN - 8 10

ERECTING SALVAGED SIGNS
 AS SHOWN - 4

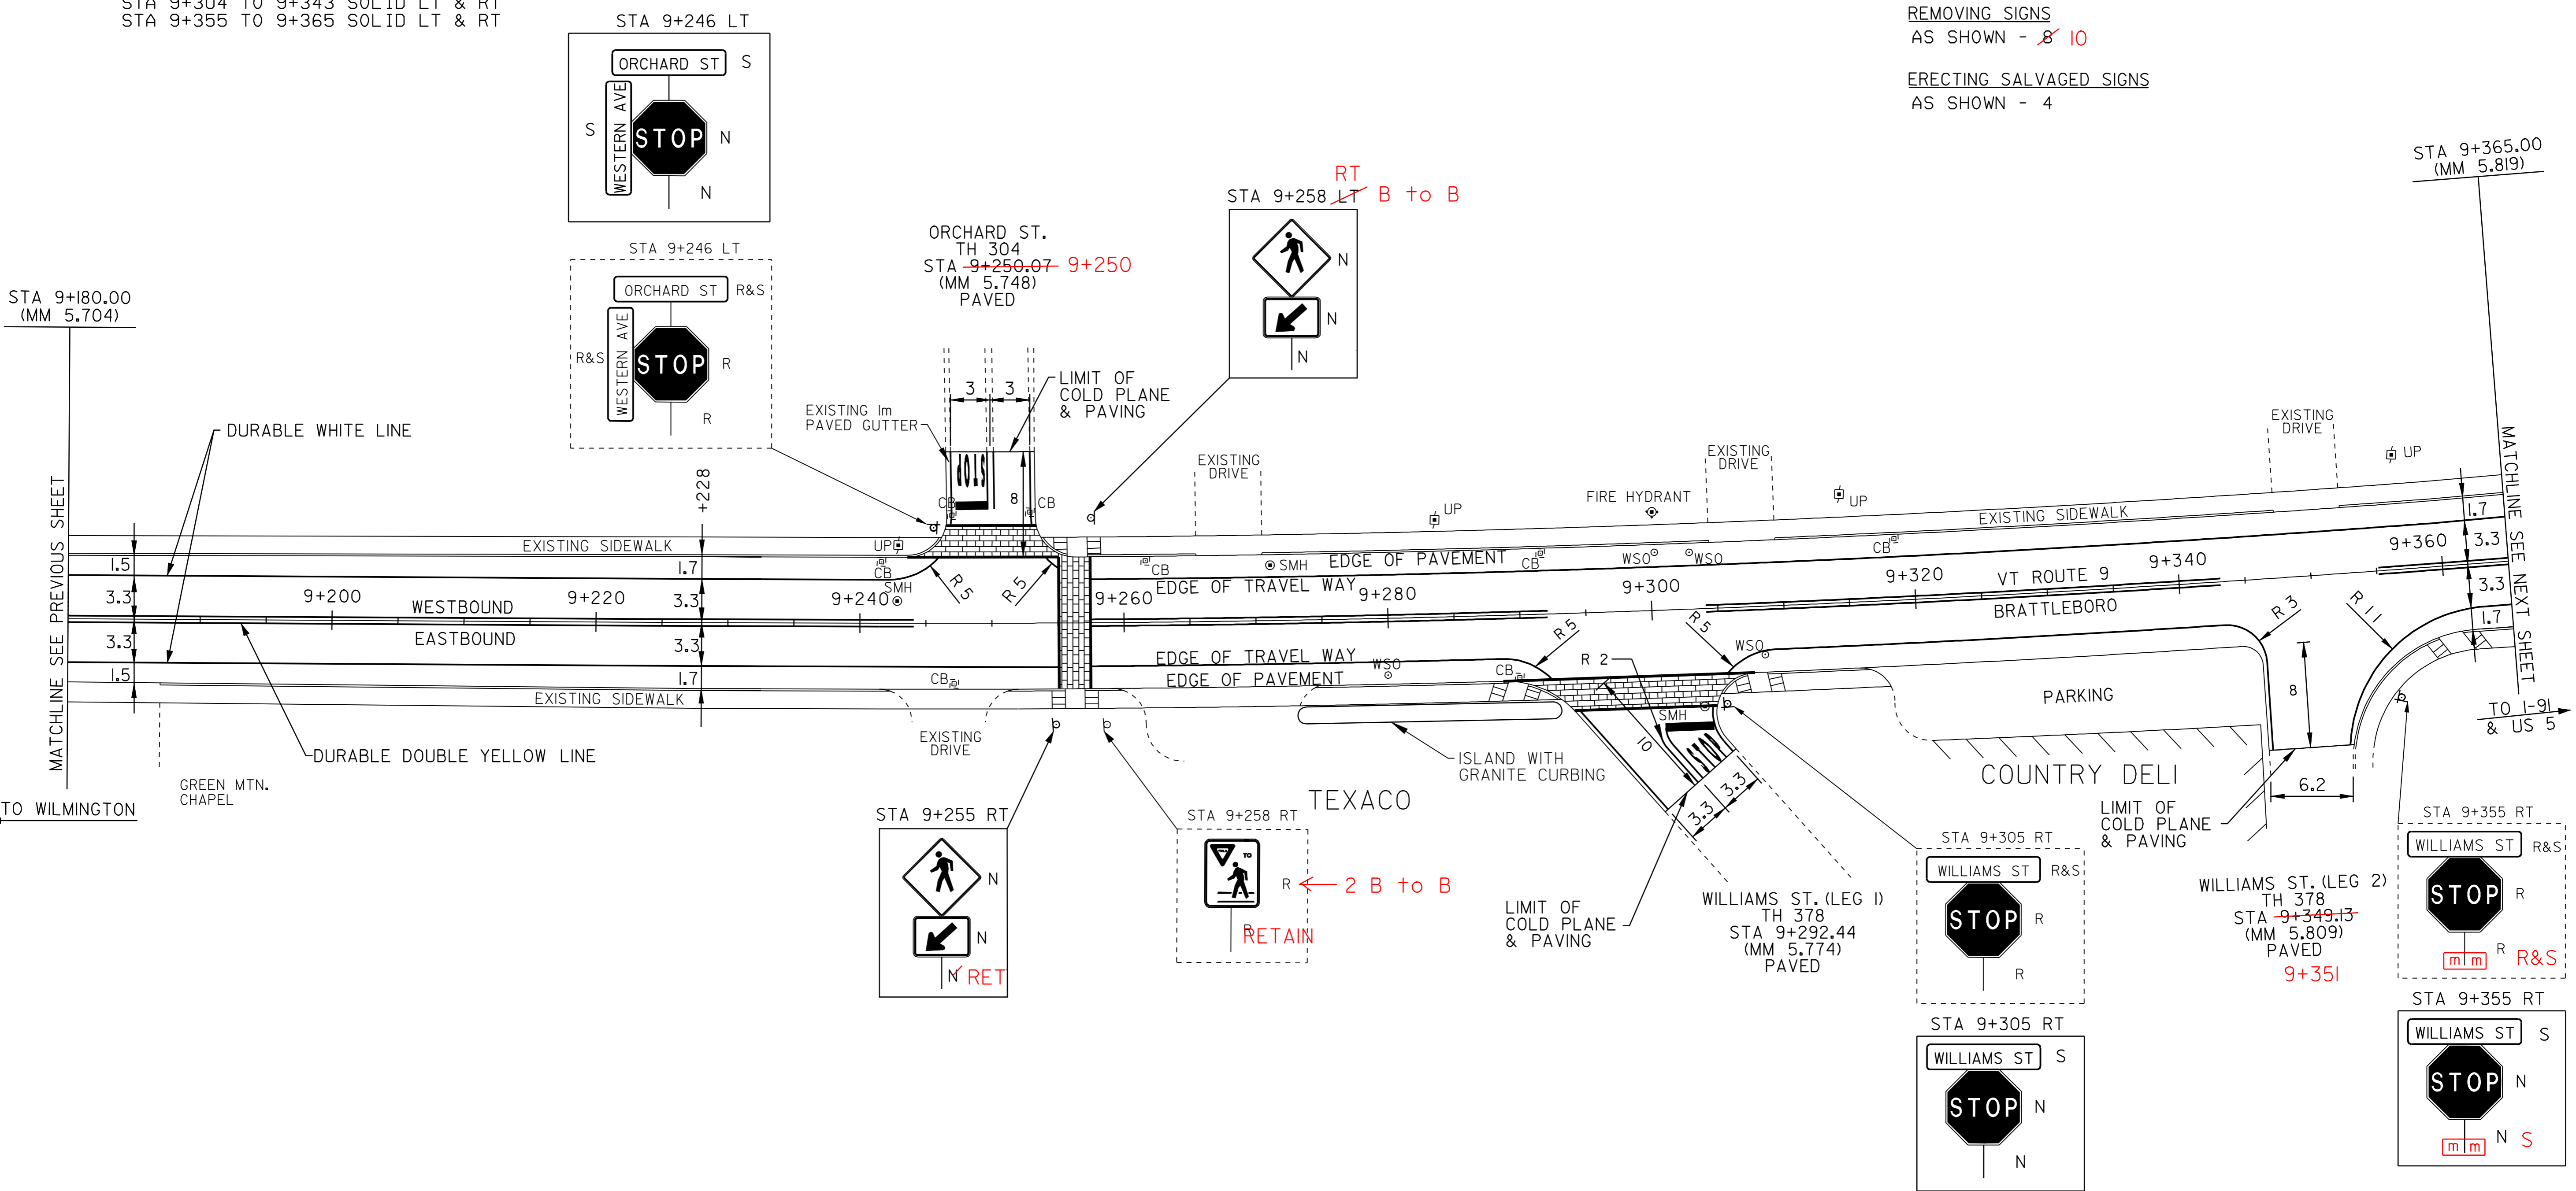

MATCHLINE SEE PREVIOUS SHEET

MATCHLINE SEE NEXT SHEET

LEGEND

- R = REMOVE EXISTING
- S = SALVAGE
- R&S = REMOVE AND SALVAGE
- N = NEW
- RET = RETAIN
- B-B = BACK TO BACK

NOTE: ALL DIMENSIONS IN METERS EXCEPT AS INDICATED

NOT TO SCALE

PAVING PROJECT LAYOUT #14	PROJECT NAME: BRATTLEBORO	FILE NAME: ZPAVE_QID026/PD026.dgn	PLOT DATE: \$DATE\$
	PROJECT NUMBER: ST-SIP_2303(1)S	PROJECT LEADER: WRH	DRAWN BY: JAC
	DESIGNED BY: -	CHECKED BY: NLL	SHEET 21 OF 55
	CLD REF. NO.: pd026114.1		