

TEMPORARY AND DURABLE 100mm WHITE LINE
 STA 9+365 TO 9+450 SOLID LT
 STA 9+365 TO 9+515 SOLID RT
 STA 9+450 TO 9+460 SOLID LT (TH 306)
 STA 9+470 TO 9+480 SOLID LT (TH 306)
 STA 9+475 TO 9+481 SOLID LT (NO PARKING)
 STA 9+482 TO 9+492 SOLID LT (NO PARKING)
 STA 9+482 TO 9+515 SOLID LT
 STA 9+501 TO 9+515 SOLID LT (NO PARKING)

DURABLE LETTER OR SYMBOL (TYPE I TAPE)
 STA 9+461 LT-"STOP"
 STA 9+485 RT-THRU/LEFT TURN ARROW


DURABLE 600mm STOP BAR (TYPE I TAPE)
 STA 9+461 LT (TH 306)
TEMPORARY 600mm STOP BAR
 STA 9+461 LT (TH 306)

DURABLE CROSSWALK MARKINGS W/DIAGONAL LINES (MOD)
 STA 9+482 LT TO RT
TEMPORARY CROSSWALK MARKINGS W/DIAGONAL LINES
 STA 9+482 LT TO RT

DURABLE 100 mm WHITE LINE (TYPE I TAPE)
 STA 9+483 TO 9+515 DASHED RT (LANE LINE)

DURABLE 200 mm YELLOW LINE
 STA 9+429 TO 9+435 SOLID LT & RT

TEMPORARY AND DURABLE 100mm YELLOW LINE
 STA 9+365 TO 9+455 SOLID LT & RT
 STA 9+429 TO 9+435 SOLID LT & RT (ISLAND APPROACH)
 STA 9+465 DOUBLE SOLID LT (TH 306)
 STA 9+474 TO 9+481 SOLID LT & RT (ISLAND)
 STA 9+483 TO 9+487 SOLID LT & RT (ISLAND)
 STA 9+509 TO 9+515 SOLID LT & RT (ISLAND)

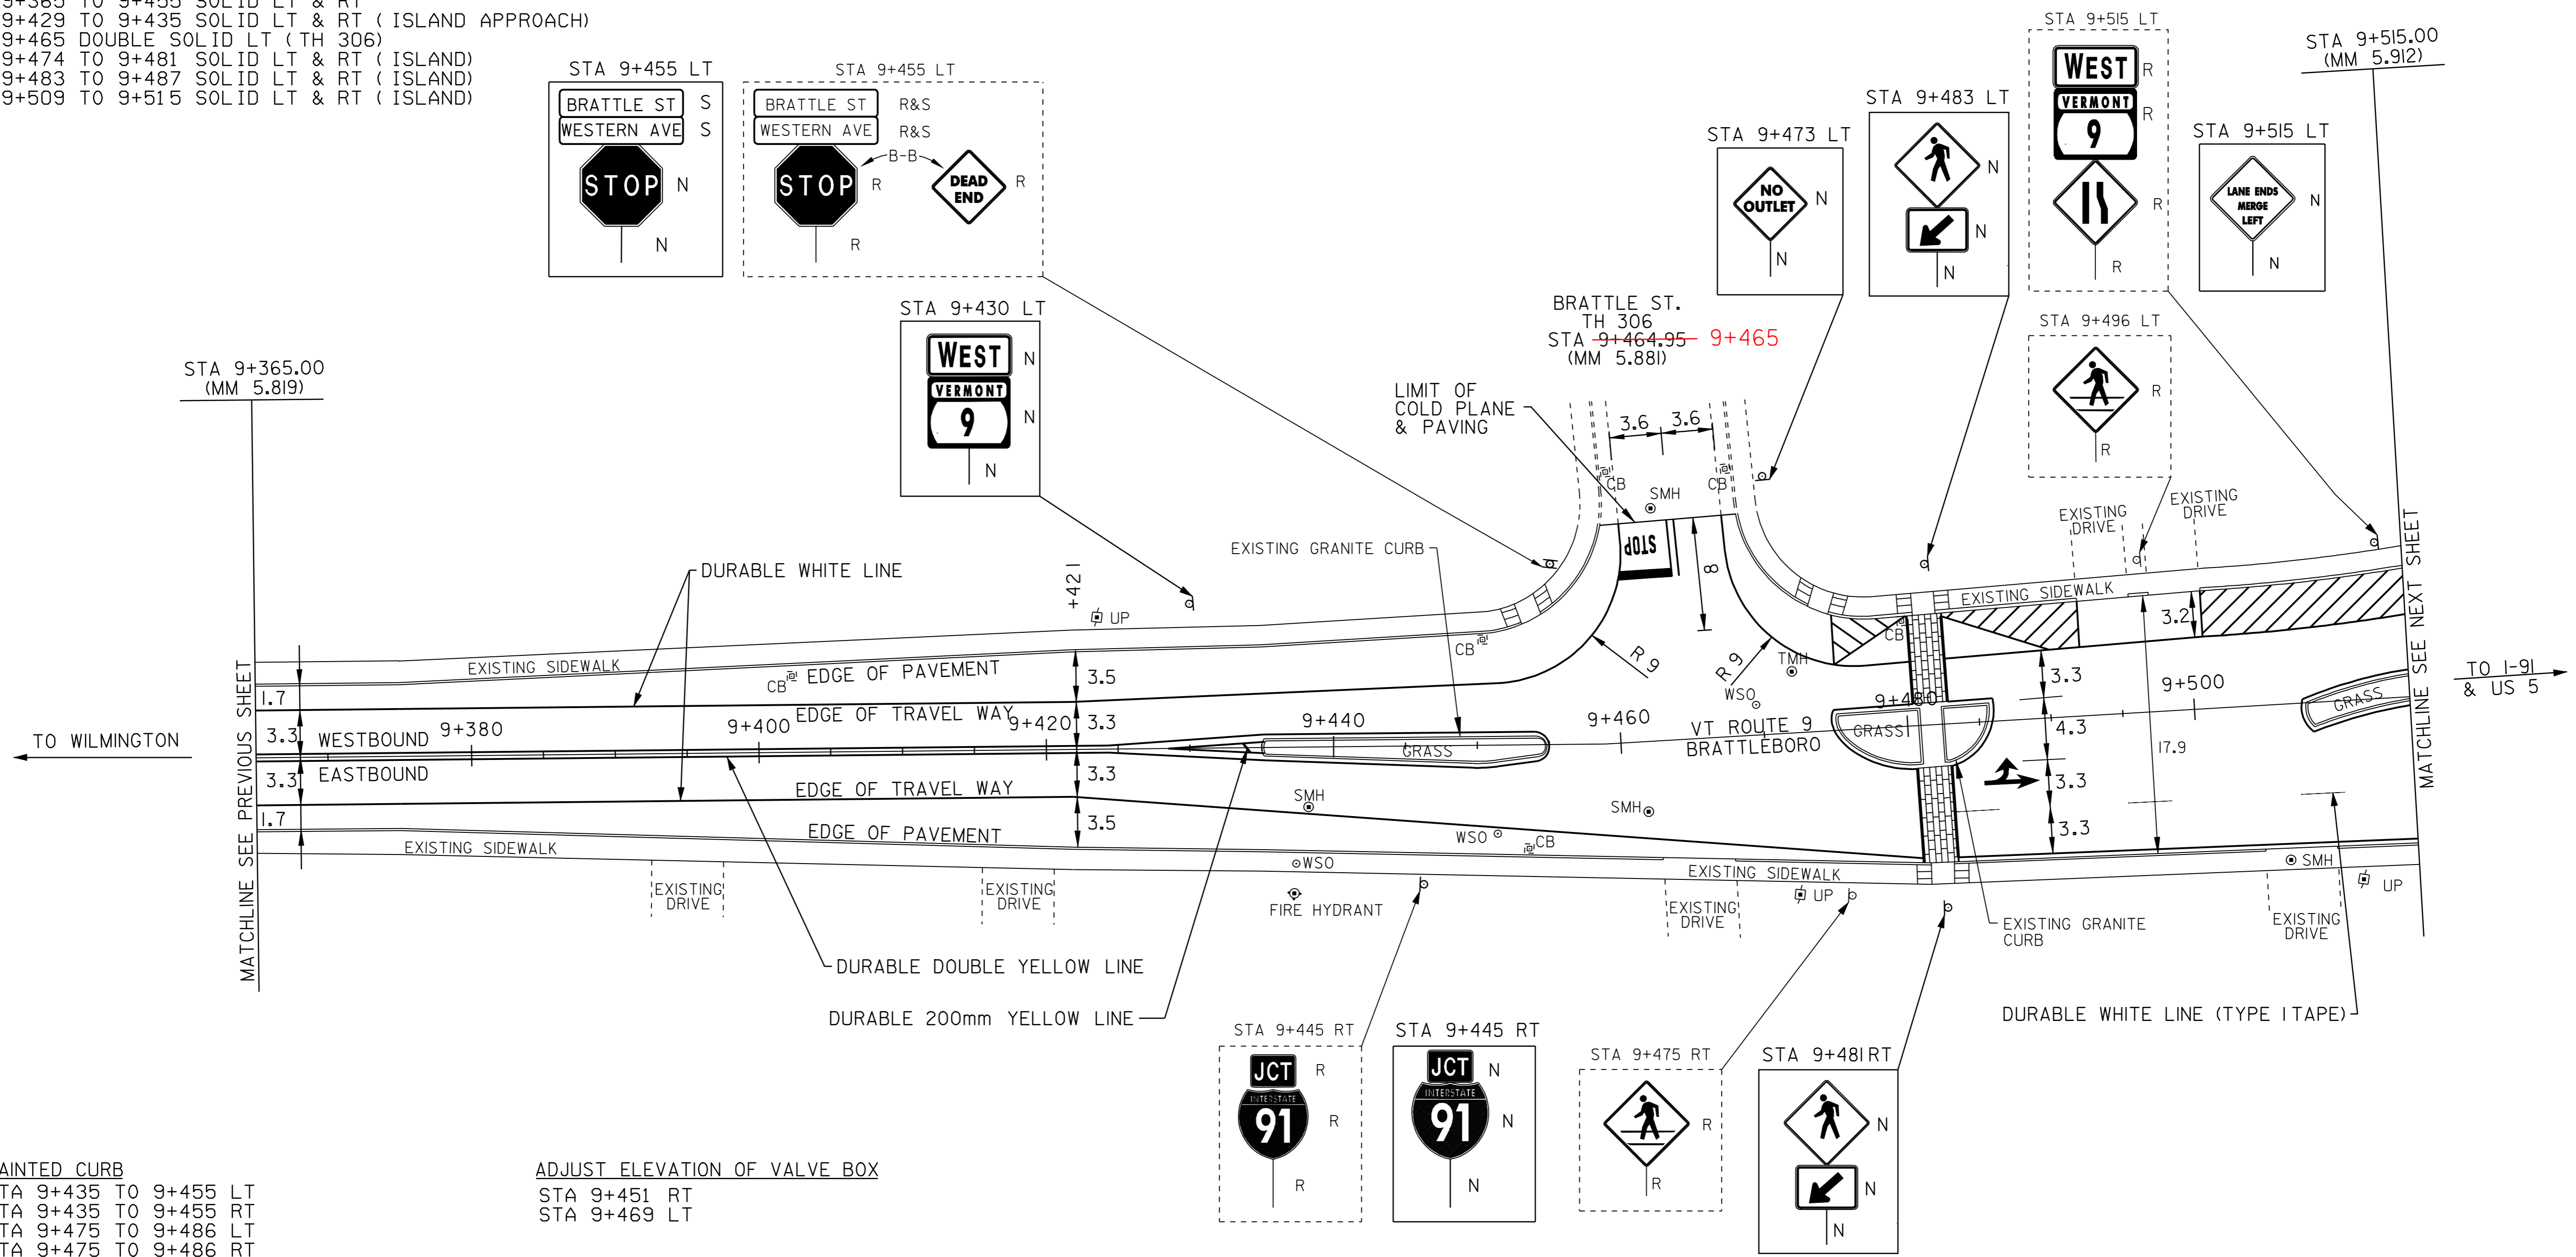

PAINTED CURB
 STA 9+435 TO 9+455 LT
 STA 9+435 TO 9+455 RT
 STA 9+475 TO 9+486 LT
 STA 9+475 TO 9+486 RT
 STA 9+507 TO 9+515 LT
 STA 9+507 TO 9+515 RT

ADJUST ELEVATION OF VALVE BOX
 STA 9+451 RT
 STA 9+469 LT


REMOVING SIGNS
 AS SHOWN - 11 ✓

ERECTING SALVAGED SIGNS
 AS SHOWN - 2

CHANGING ELEV. OF DI, CB, OR MH
 STA 9+472 LT (TMH)

REHABILITATION OF DI, CB, OR MH, CLASS I
 STA 9+403 LT (CB)
 STA 9+453 LT (CB)
 STA 9+453 RT (CB)
 STA 9+481 LT (CB)

CHANGING ELEVATION OF SEWER MANHOLE
 STA 9+436 RT
 STA 9+462 RT

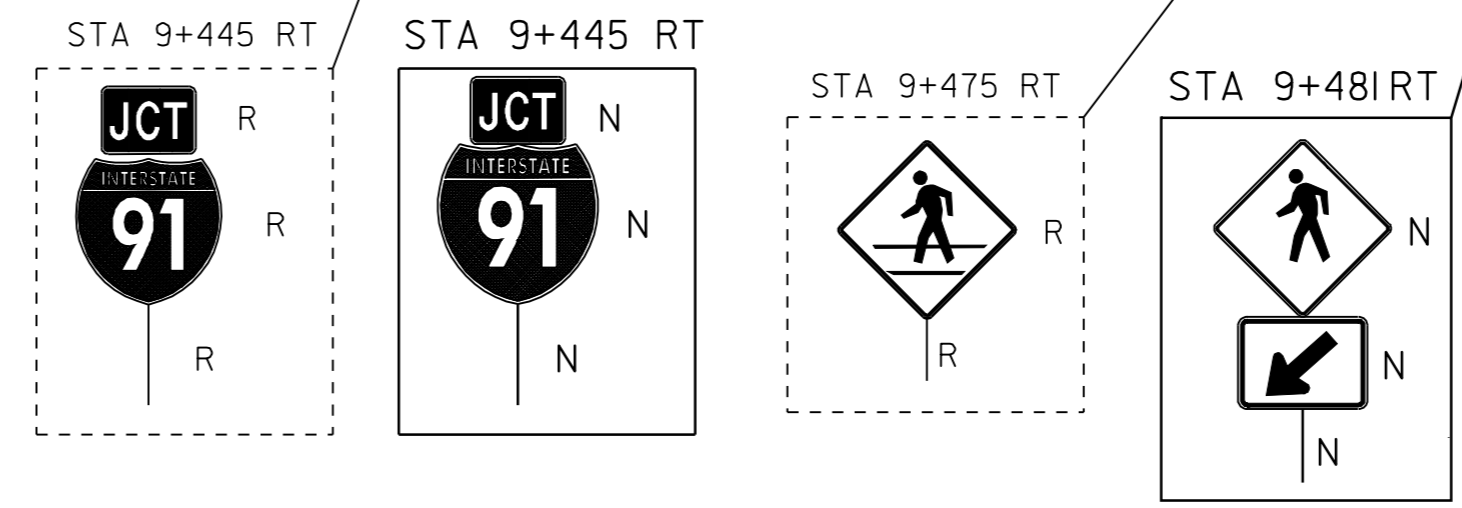

LEGEND
 R = REMOVE EXISTING
 S = SALVAGE
 R&S = REMOVE AND SALVAGE
 N = NEW
 RET = RETAIN
 B-B = BACK TO BACK

NOTE: ALL DIMENSIONS IN METERS EXCEPT AS INDICATED

| | |
|--|-----------------------------------|
| PAVING PROJECT LAYOUT #15 | PROJECT NAME: BRATTLEBORO |
| | PROJECT NUMBER: ST-SIP_2303(1)S |
| | FILE NAME: \PAVE\QID026\PD026.dgn |
| | CLD REF. NO.: p4026(1)5.1 |
| PROJECT LEADER: WRH | PLOT DATE: \$DATE\$ |
| DESIGNED BY: - | DRAWN BY: JAC |
| CHECKED BY: NLL | SHEET 22 OF 55 |

NOT TO SCALE