

TEMPORARY AND DURABLE 100mm WHITE LINE
 STA 9+515 TO 9+517 SOLID LT (NO PARKING)
 STA 9+515 TO 9+517 SOLID LT
 STA 9+515 TO 9+700 SOLID RT
 STA 9+536 TO 9+546 SOLID LT (RAMP ISLAND)
 STA 9+576 TO 9+621 SOLID LT
 STA 9+645 TO 9+652 SOLID LT (RAMP ISLAND)
 STA 9+672 TO 9+676 SOLID LT
 STA 9+676 TO 9+684 SOLID LT (TH 308)
 STA 9+692 TO 9+700 SOLID LT (TH 308)

DURABLE 100mm WHITE LINE (TYPE I TAPE)
 STA 9+515 TO 9+680 DASHED RT (LANE LINE)
 STA 9+520 TO 9+536 SOLID RT (LANE LINE)
 STA 9+564 TO 9+631 SOLID LT (LANE LINE)
 STA 9+586 TO 9+631 SOLID RT (LANE LINE)
 STA 9+647 TO 9+680 SOLID LT (LANE LINE)

TEMPORARY AND DURABLE 100mm YELLOW LINE
 STA 9+517 TO 9+537 SOLID LT & RT (ISLAND)
 STA 9+562 TO 9+633 SOLID LT & RT (ISLAND)
 STA 9+647 TO 9+680 SOLID LT & RT (ISLAND)
 STA 9+688 DOUBLE SOLID LT (TH 308)
 STA 9+698 TO 9+700 SOLID LT & RT (ISLAND)

TEMPORARY AND DURABLE 150mm WHITE LINE
 STA 9+517 TO 9+535 SOLID LT (RAMP)
 STA 9+546 TO 9+547 SOLID LT (RAMP ISLAND)
 STA 9+559 TO 9+576 SOLID LT (RAMP)
 STA 9+621 TO 9+634 SOLID LT (RAMP)
 STA 9+644 TO 9+645 SOLID LT (RAMP ISLAND)
 STA 9+651 TO 9+672 SOLID LT (RAMP)

TEMPORARY AND DURABLE 150mm YELLOW LINE
 STA 9+537 TO 9+542 SOLID LT (RAMP/ISLAND)
 STA 9+553 TO 9+555 DOUBLE SOLID LT (ISLAND)
 STA 9+637 TO 9+639 DOUBLE SOLID LT (ISLAND)
 STA 9+646 TO 9+652 SOLID LT (RAMP/ISLAND)

DURABLE CROSSWALK MARKINGS W/DIAGONAL LINES (MOD)
 STA 9+667 LT TO RT

TEMPORARY CROSSWALK MARKINGS W/DIAGONAL LINES
 STA 9+667 LT TO RT

DURABLE 600mm STOP BAR (TYPE I TAPE)
 STA 9+531 LT (RAMP)
 STA 9+535 RT
 STA 9+550 LT (RAMP)
 STA 9+630 LT (RAMP)
 STA 9+631 RT
 STA 9+685 LT (TH 308)


TEMPORARY 600mm STOP BAR
 STA 9+531 LT (RAMP)
 STA 9+535 RT
 STA 9+550 LT (RAMP)
 STA 9+630 LT (RAMP)
 STA 9+631 RT
 STA 9+685 LT (TH 308)

CHANGING ELEV. OF DI, CB, OR MH
 STA 9+681 LT (TMH)

REHABILITATION OF DI, CB, OR MH, CLASS I
 STA 9+517 LT (CB)
 STA 9+517 RT (CB)
 STA 9+563 RT (CB)
 STA 9+646 RT (CB)
 STA 9+676 LT (CB)

CHANGING ELEVATION OF SEWER MANHOLE
 STA 9+688 LT

ADJUST ELEVATION OF VALVE BOX
 STA 9+540 LT
 STA 9+541 LT
 STA 9+680 LT
 STA 9+688 LT

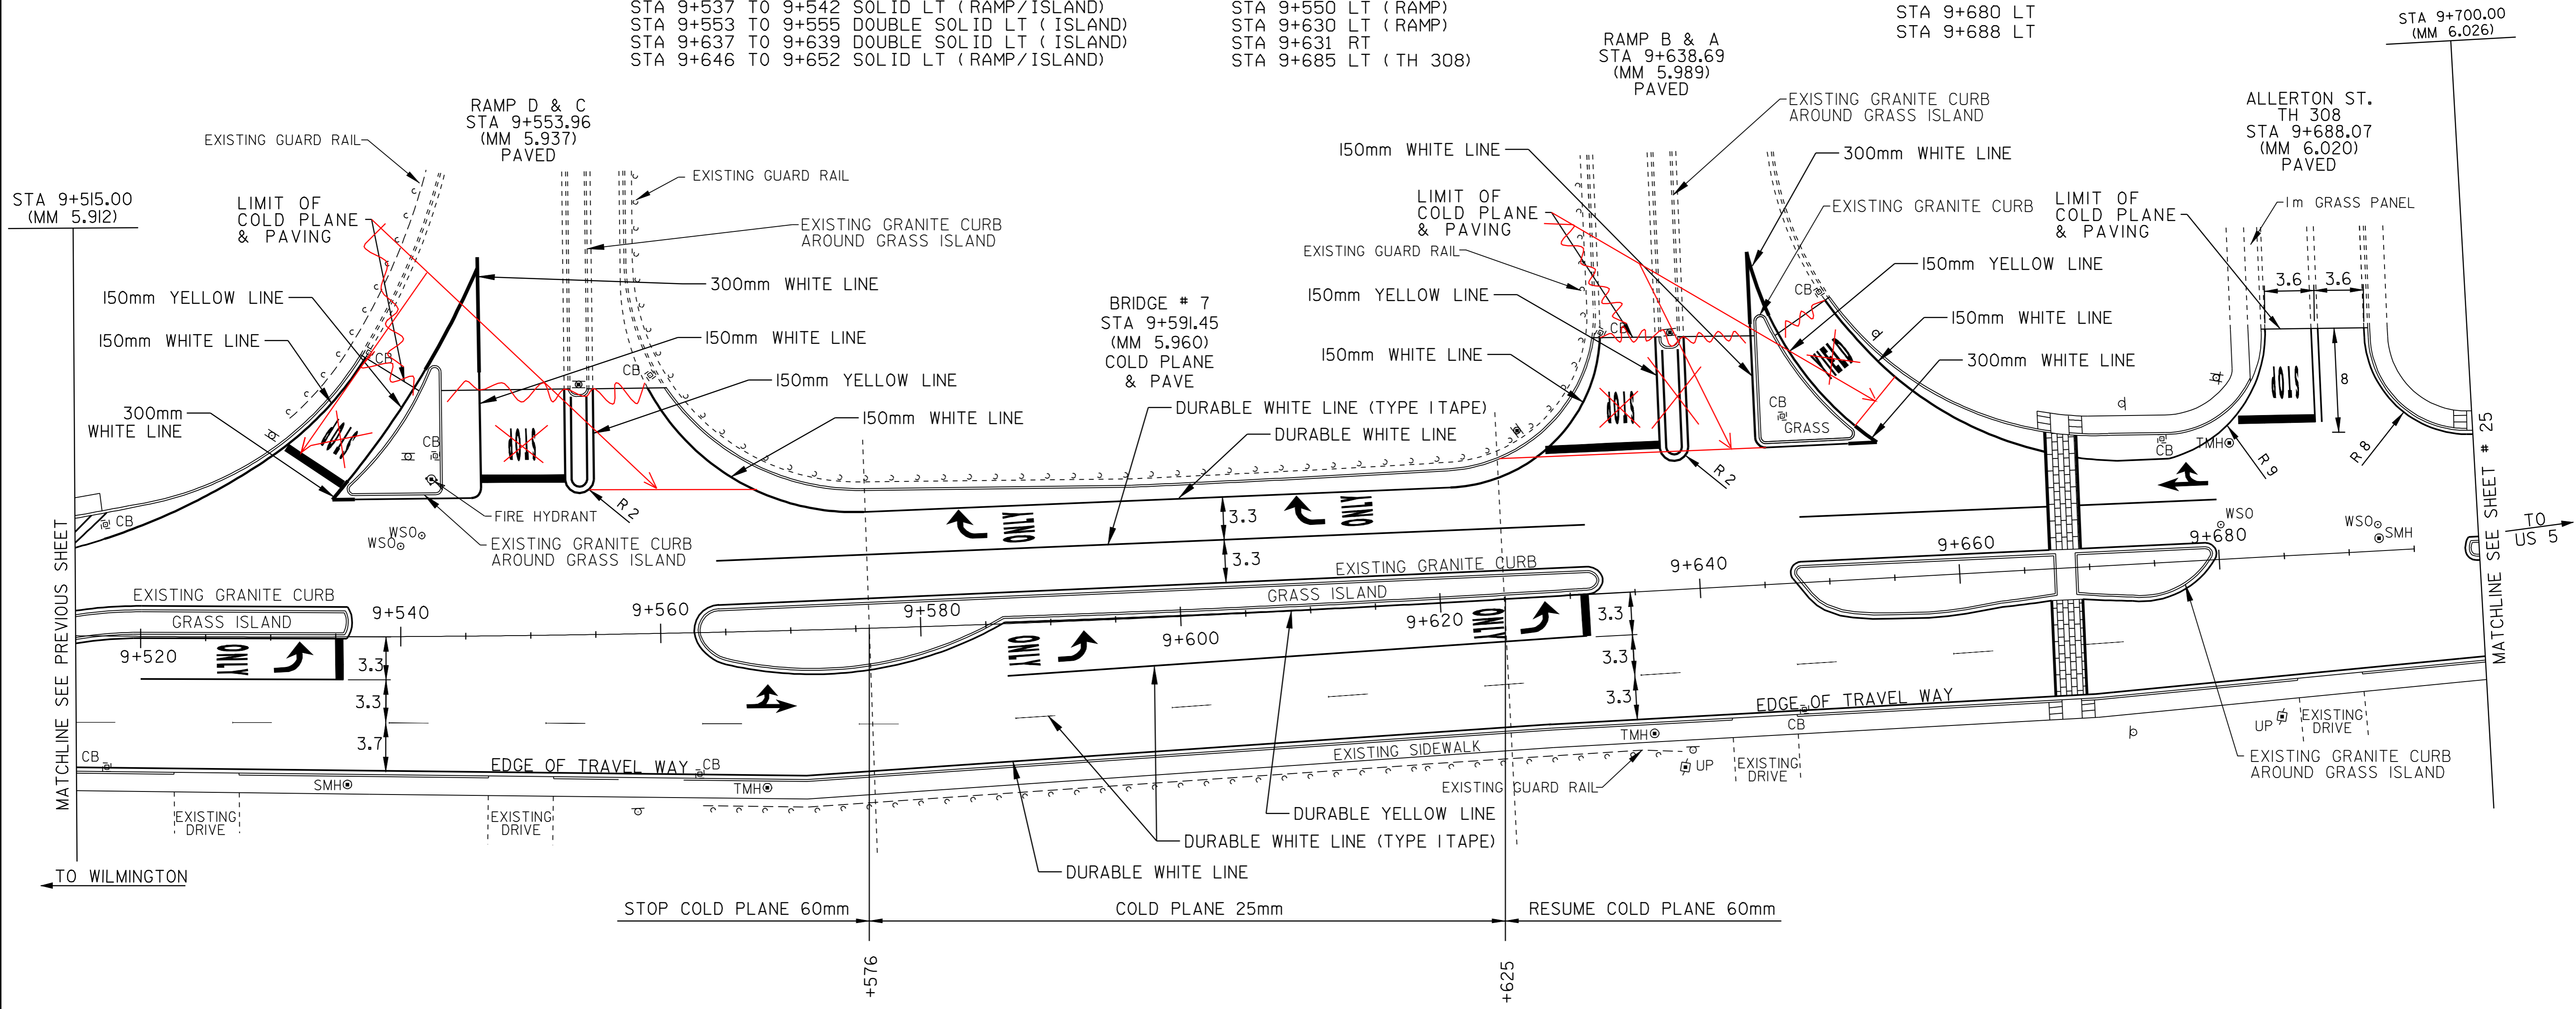

DURABLE LETTER OR SYMBOL (TYPE I TAPE)
 STA 9+527 RT-" ONLY"
 STA 9+531 RT-LEFT TURN ARROW
 STA 9+535 LT-" STOP" (RAMP)
 STA 9+550 LT-" STOP" (RAMP)
 STA 9+568 RT-THRU/LEFT TURN ARROW
 STA 9+584 LT-RIGHT TURN ARROW
 STA 9+587 LT-" ONLY"
 STA 9+587 RT-" ONLY"
 STA 9+591 RT-LEFT TURN ARROW
 STA 9+610 LT-RIGHT TURN ARROW
 STA 9+614 LT-" ONLY"
 STA 9+624 RT-" ONLY"
 STA 9+628 RT-LEFT TURN ARROW
 STA 9+630 LT-" STOP" (RAMP)
 STA 9+651 LT-" YIELD" (RAMP)
 STA 9+679 LT - THRU/RIGHT TURN ARROW
 STA 9+685 LT - "STOP" (TH 308)

TEMPORARY LETTERS OR SYMBOLS
 STA 9+531 RT-LEFT TURN ARROW
 STA 9+535 LT-" STOP" (RAMP)
 STA 9+550 LT-" STOP" (RAMP)
 STA 9+568 RT-THRU/LEFT TURN ARROW
 STA 9+584 LT-RIGHT TURN ARROW
 STA 9+591 RT-LEFT TURN ARROW
 STA 9+610 LT-RIGHT TURN ARROW
 STA 9+628 RT-LEFT TURN ARROW
 STA 9+630 LT-" STOP" (RAMP)
 STA 9+651 LT-" YIELD" (RAMP)
 STA 9+679 LT - THRU/RIGHT TURN ARROW
 STA 9+685 LT - "STOP" (TH 308)

TEMPORARY AND DURABLE 300mm WHITE LINE
 STA 9+535 TO 9+537 SOLID LT
 STA 9+535 TO 9+536 SOLID LT (RAMP)
 STA 9+542 TO 9+546 SOLID LT (RAMP)
 STA 9+546 SOLID LT (RAMP)
 STA 9+644 SOLID LT (RAMP)
 STA 9+644 TO 9+646 SOLID LT (RAMP)
 STA 9+652 TO 9+654 SOLID LT (RAMP)
 STA 9+652 TO 9+654 SOLID LT

PAINTED CURB
 STA 9+515 TO 9+536 LT
 STA 9+515 TO 9+536 RT
 STA 9+563 TO 9+572 LT
 STA 9+563 TO 9+572 RT
 STA 9+577 TO 9+595 LT
 STA 9+623 TO 9+632 LT
 STA 9+623 TO 9+632 RT
 STA 9+647 TO 9+656 LT
 STA 9+647 TO 9+656 RT
 STA 9+671 TO 9+680 LT
 STA 9+671 TO 9+680 RT
 STA 9+698 TO 9+700 LT
 STA 9+698 TO 9+700 RT

LEGEND
 R = REMOVE EXISTING
 S = SALVAGE
 R&S = REMOVE AND SALVAGE
 N = NEW
 RET = RETAIN
 B-B = BACK TO BACK

NOTE: ALL DIMENSIONS IN METERS EXCEPT AS INDICATED

| | | | |
|---|---------------------------------|-----------------------------------|---------------------|
| PAVING PROJECT LAYOUT #16 A STRIPING | PROJECT NAME: BRATTLEBORO | FILE NAME: /PAVE/QID026/PD026.dgn | PLOT DATE: \$DATE\$ |
| | PROJECT NUMBER: ST-STP_2303(I)S | PROJECT LEADER: WRH | DRAWN BY: JAC |
| | DESIGNED BY: _____ | CLD REF. NO.: pd026ll6a.1 | CHECKED BY: NLL |
| | | | SHEET 23 OF 55 |

NOT TO SCALE