


REMOVING SIGNS
AS SHOWN - 41 42

ERECTING SALVAGED SIGNS
AS SHOWN - 1

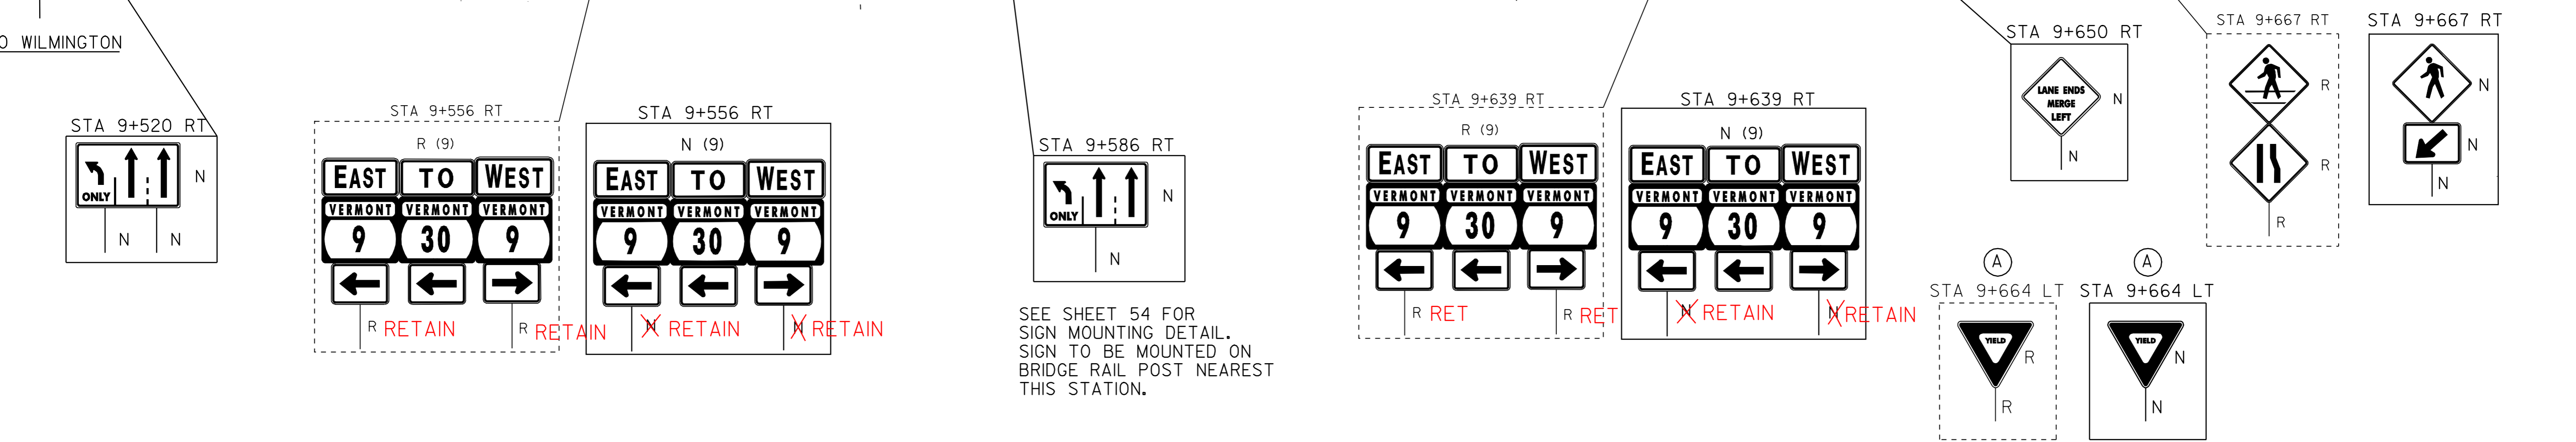

SEE SHEET 54 FOR
SIGN MOUNTING DETAIL.
SIGN TO BE MOUNTED ON
BRIDGE RAIL POST NEAREST
THIS STATION.

- LEGEND**
- R = REMOVE EXISTING
 - S = SALVAGE
 - R&S = REMOVE AND SALVAGE
 - N = NEW
 - RET = RETAIN
 - B-B = BACK TO BACK

NOTE: ALL DIMENSIONS IN METERS EXCEPT AS INDICATED

PAVING PROJECT LAYOUT #16 B SIGNING	PROJECT NAME: BRATTLEBORO
	PROJECT NUMBER: ST-STP 2303(I)S
	FILE NAME: ZPAVE/OID026/PD026.dgn
	PROJECT LEADER: WRH
	DESIGNED BY: _____
CLD REF. NO.: p4026116b.1	PLOT DATE: \$DATE\$ DRAWN BY: JAC CHECKED BY: NLL SHEET 24 OF 55

NOT TO SCALE