

TEMPORARY AND DURABLE 100mm WHITE LINE
 STA 9+885 TO 10+065 SOLID LT
 STA 9+885 TO 10+003 SOLID RT
 STA 9+975 TO 9+987 SOLID LT (NO PARKING)
 STA 9+997 TO 10+003 SOLID RT (NO PARKING)
 STA 10+003 TO 10+007 SOLID RT (TH 382)
 STA 10+015 TO 10+020 SOLID RT (TH 382)
 STA 10+020 TO 10+026 SOLID RT (NO PARKING)
 STA 10+020 TO 10+065 SOLID RT

TEMPORARY AND DURABLE 100mm YELLOW LINE
 STA 9+885 TO 10+006 SOLID LT & RT
 STA 10+012 DOUBLE SOLID RT (TH 382)
 STA 10+018 TO 10+065 SOLID LT & RT

DURABLE LETTER OR SYMBOL (TYPE-TAPE)
 STA 10+014 RT - "STOP" (TH 382)

TEMPORARY LETTERS OR SYMBOLS
 STA 10+014 RT - "STOP" (TH 382)

DURABLE 600mm STOP BAR (TYPE-TAPE)
 STA 10+012 RT (TH 382)

TEMPORARY 600mm STOP BAR
 STA 10+012 RT (TH 382)

DURABLE CROSSWALK MARKINGS W/DIAGONAL LINES (MOD)
 STA 10+003 TO 10+019 RT

TEMPORARY CROSSWALK MARKINGS W/DIAGONAL LINES
 STA 10+003 TO 10+019 RT

CHANGING ELEV. OF DI, CB, OR MH

STA 10+010 RT (DMH)
 STA 10+012 LT (DMH)

REHABILITATION OF DI, CB, OR MH, CLASS I

STA 9+916 RT (CB)
 STA 9+969 RT (CB)
 STA 9+969 LT (CB)
 STA 10+008 RT (CB) - TH 382
 STA 10+019 LT (CB)
 STA 10+019 RT (CB)

ADJUST ELEVATION OF VALVE BOX

STA 9+975 LT
 STA 9+978 LT
 STA 9+980 LT
 STA 9+980 RT
 STA 9+990 LT
 STA 10+007 RT
 STA 10+015 LT
 STA 10+016 RT - TH 382

CHANGING ELEVATION OF SEWER MANHOLE

STA 9+941 RT
 STA 9+969 RT
 STA 10+008 LT
 STA 10+012 RT


REMOVING SIGNS

AS SHOWN - 6

ERECTING SALVAGED SIGNS

AS SHOWN - 2

STA 10+065.00
 (MM 6.254)

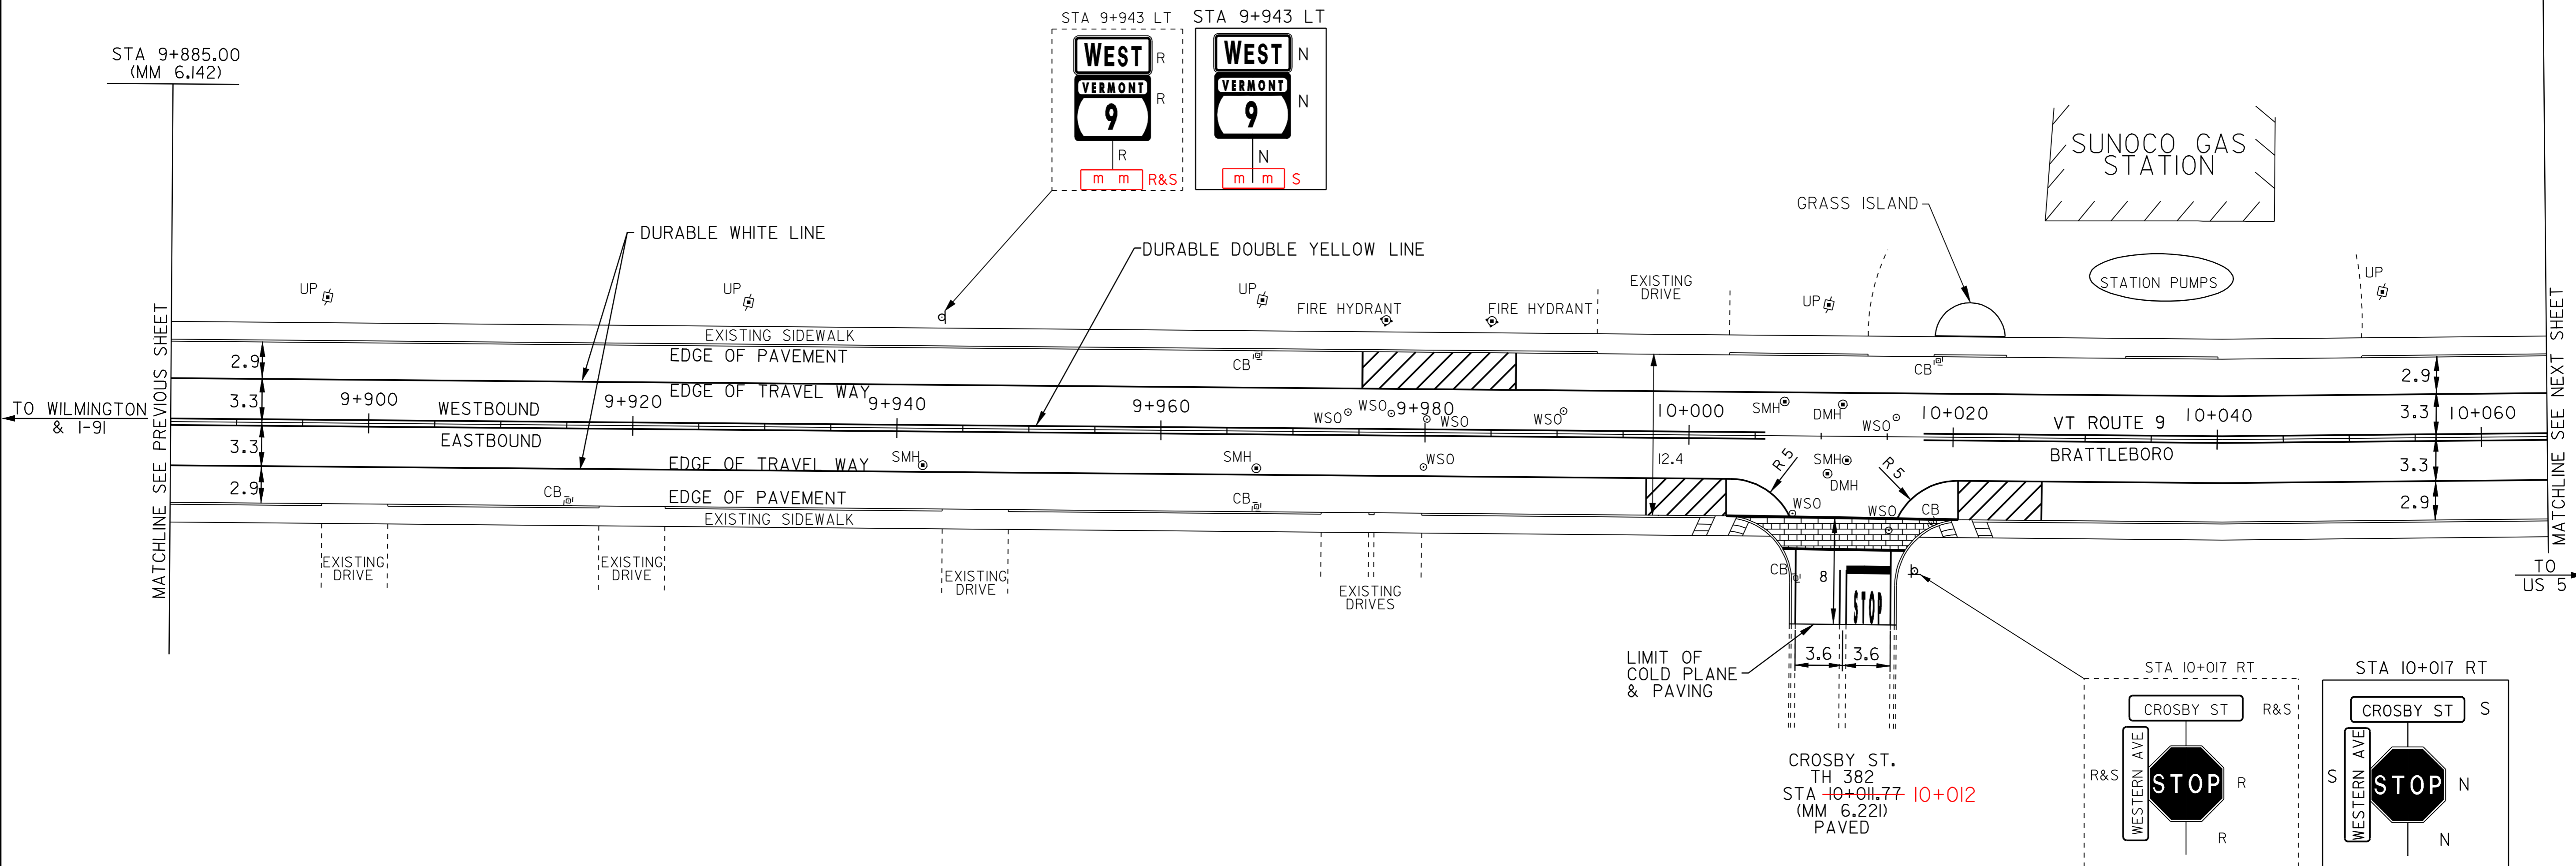

LEGEND

- R = REMOVE EXISTING
- S = SALVAGE
- R&S = REMOVE AND SALVAGE
- N = NEW
- RET = RETAIN
- B-B = BACK TO BACK

NOTE: ALL DIMENSIONS IN METERS EXCEPT AS INDICATED

NOT TO SCALE

PAVING PROJECT LAYOUT #18

PROJECT NAME:	BRATTLEBORO
PROJECT NUMBER:	ST-STP_2303(I)S
FILE NAME:	PAVE_QID026/PD026.dgn
PROJECT LEADER:	WRH
DESIGNED BY:	
CLD REF. NO.:	pd026i18.1
PLOT DATE:	\$DATE\$
DRAWN BY:	JAC
CHECKED BY:	NLL
SHEET	26 OF 55