

TEMPORARY AND DURABLE 100mm WHITE LINE
 STA 10+065 TO 10+230 SOLID LT & RT
 STA 10+164 TO 10+170 SOLID LT & RT (NO PARKING)
 STA 10+172 TO 10+179 SOLID LT & RT (NO PARKING)

REHABILITATION OF DI, CB, OR MH, CLASS I
 STA 10+077 LT (CB)
 STA 10+099 LT (CB)
 STA 10+099 RT (CB)
 STA 10+187 LT (CB)
 STA 10+187 RT (CB)


CHANGING ELEVATION OF SEWER MANHOLE
 STA 10+087 RT
 STA 10+150 LT
 STA 10+168 RT
 STA 10+225 RT

REMOVING SIGNS
 AS SHOWN - 4 ✓

TEMPORARY AND DURABLE 100mm YELLOW LINE
 STA 10+065 TO 10+230 SOLID LT & RT

DURABLE CROSSWALK MARKINGS W/DIAGONAL LINES (MOD)
 STA 10+171 LT TO RT

TEMPORARY CROSSWALK MARKINGS W/DIAGONAL LINES
 STA 10+171 LT TO RT

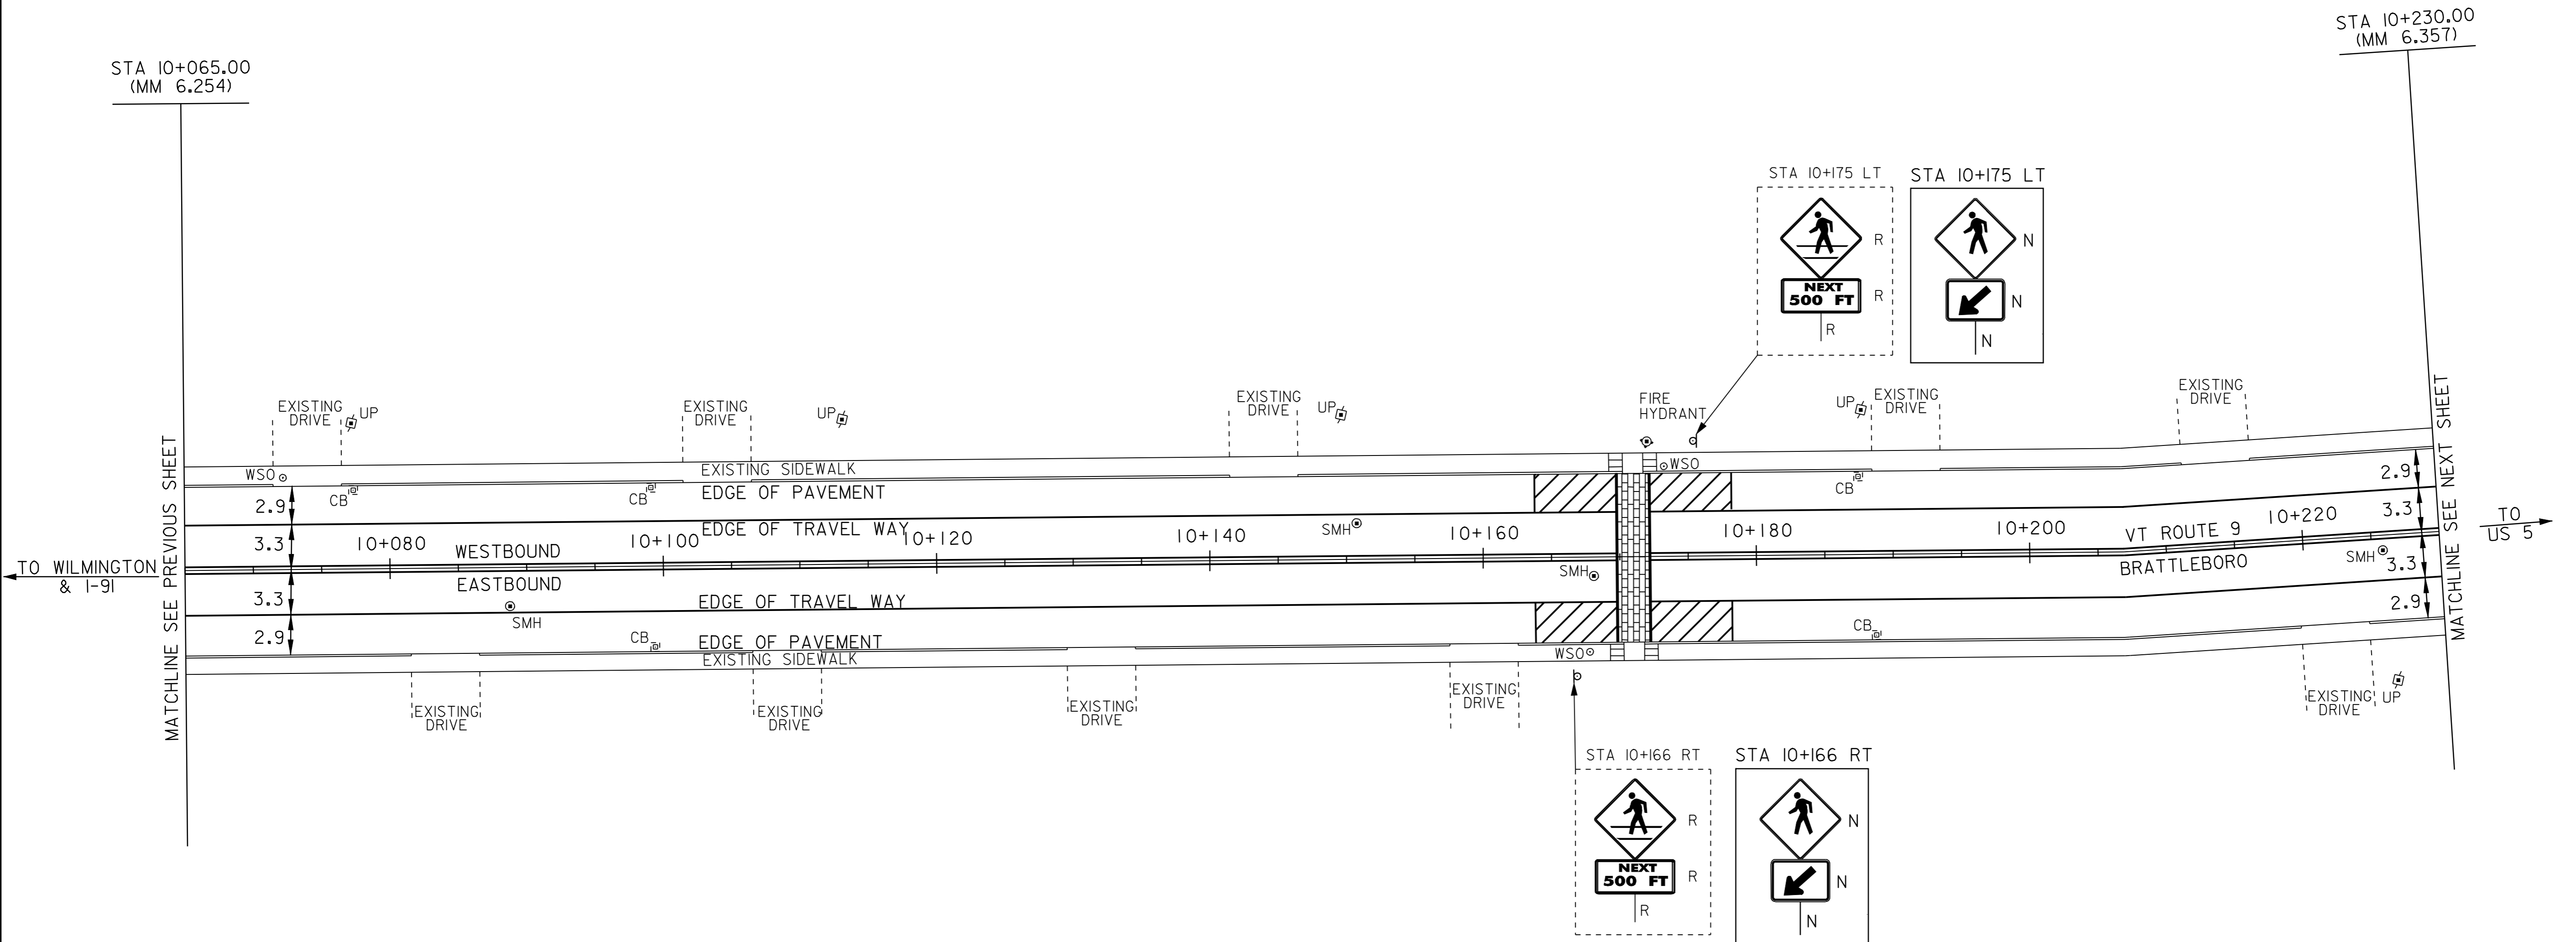

LEGEND

- R = REMOVE EXISTING
- S = SALVAGE
- R&S = REMOVE AND SALVAGE
- N = NEW
- RET = RETAIN
- B-B = BACK TO BACK

NOTE: ALL DIMENSIONS IN METERS EXCEPT AS INDICATED

NOT TO SCALE

**PAVING
PROJECT
LAYOUT #19**

PROJECT NAME: BRATTLEBORO	PLOT DATE: \$DATE\$
PROJECT NUMBER: ST-STP_2303(I)S	DRAWN BY: JAC
FILE NAME: \PAVE\QD026\PD026.dgn	CHECKED BY: NLL
PROJECT LEADER: WRH	CLD REF. NO.: pd026i19.1
DESIGNED BY:	SHEET 27 OF 55